


DESCRIPTION AND LOCATION

PROJECT LENGTH: 5.529 MILES; 29,193 FEET

1986 ADT: 1720

BEGINNING IN THE TOWN OF HARDWICK ON VT. ROUTE 15
M.M. 5.759 AND EXTENDING EASTERLY 5.529 MILES TO
M.M. 4.091 IN THE TOWN OF WALDEN. RESURFACING THE
EXISTING HIGHWAY AND SHOULDERS, NEW PAVEMENT MARKINGS,
AND RESURFACE EXISTING GUTTERS.

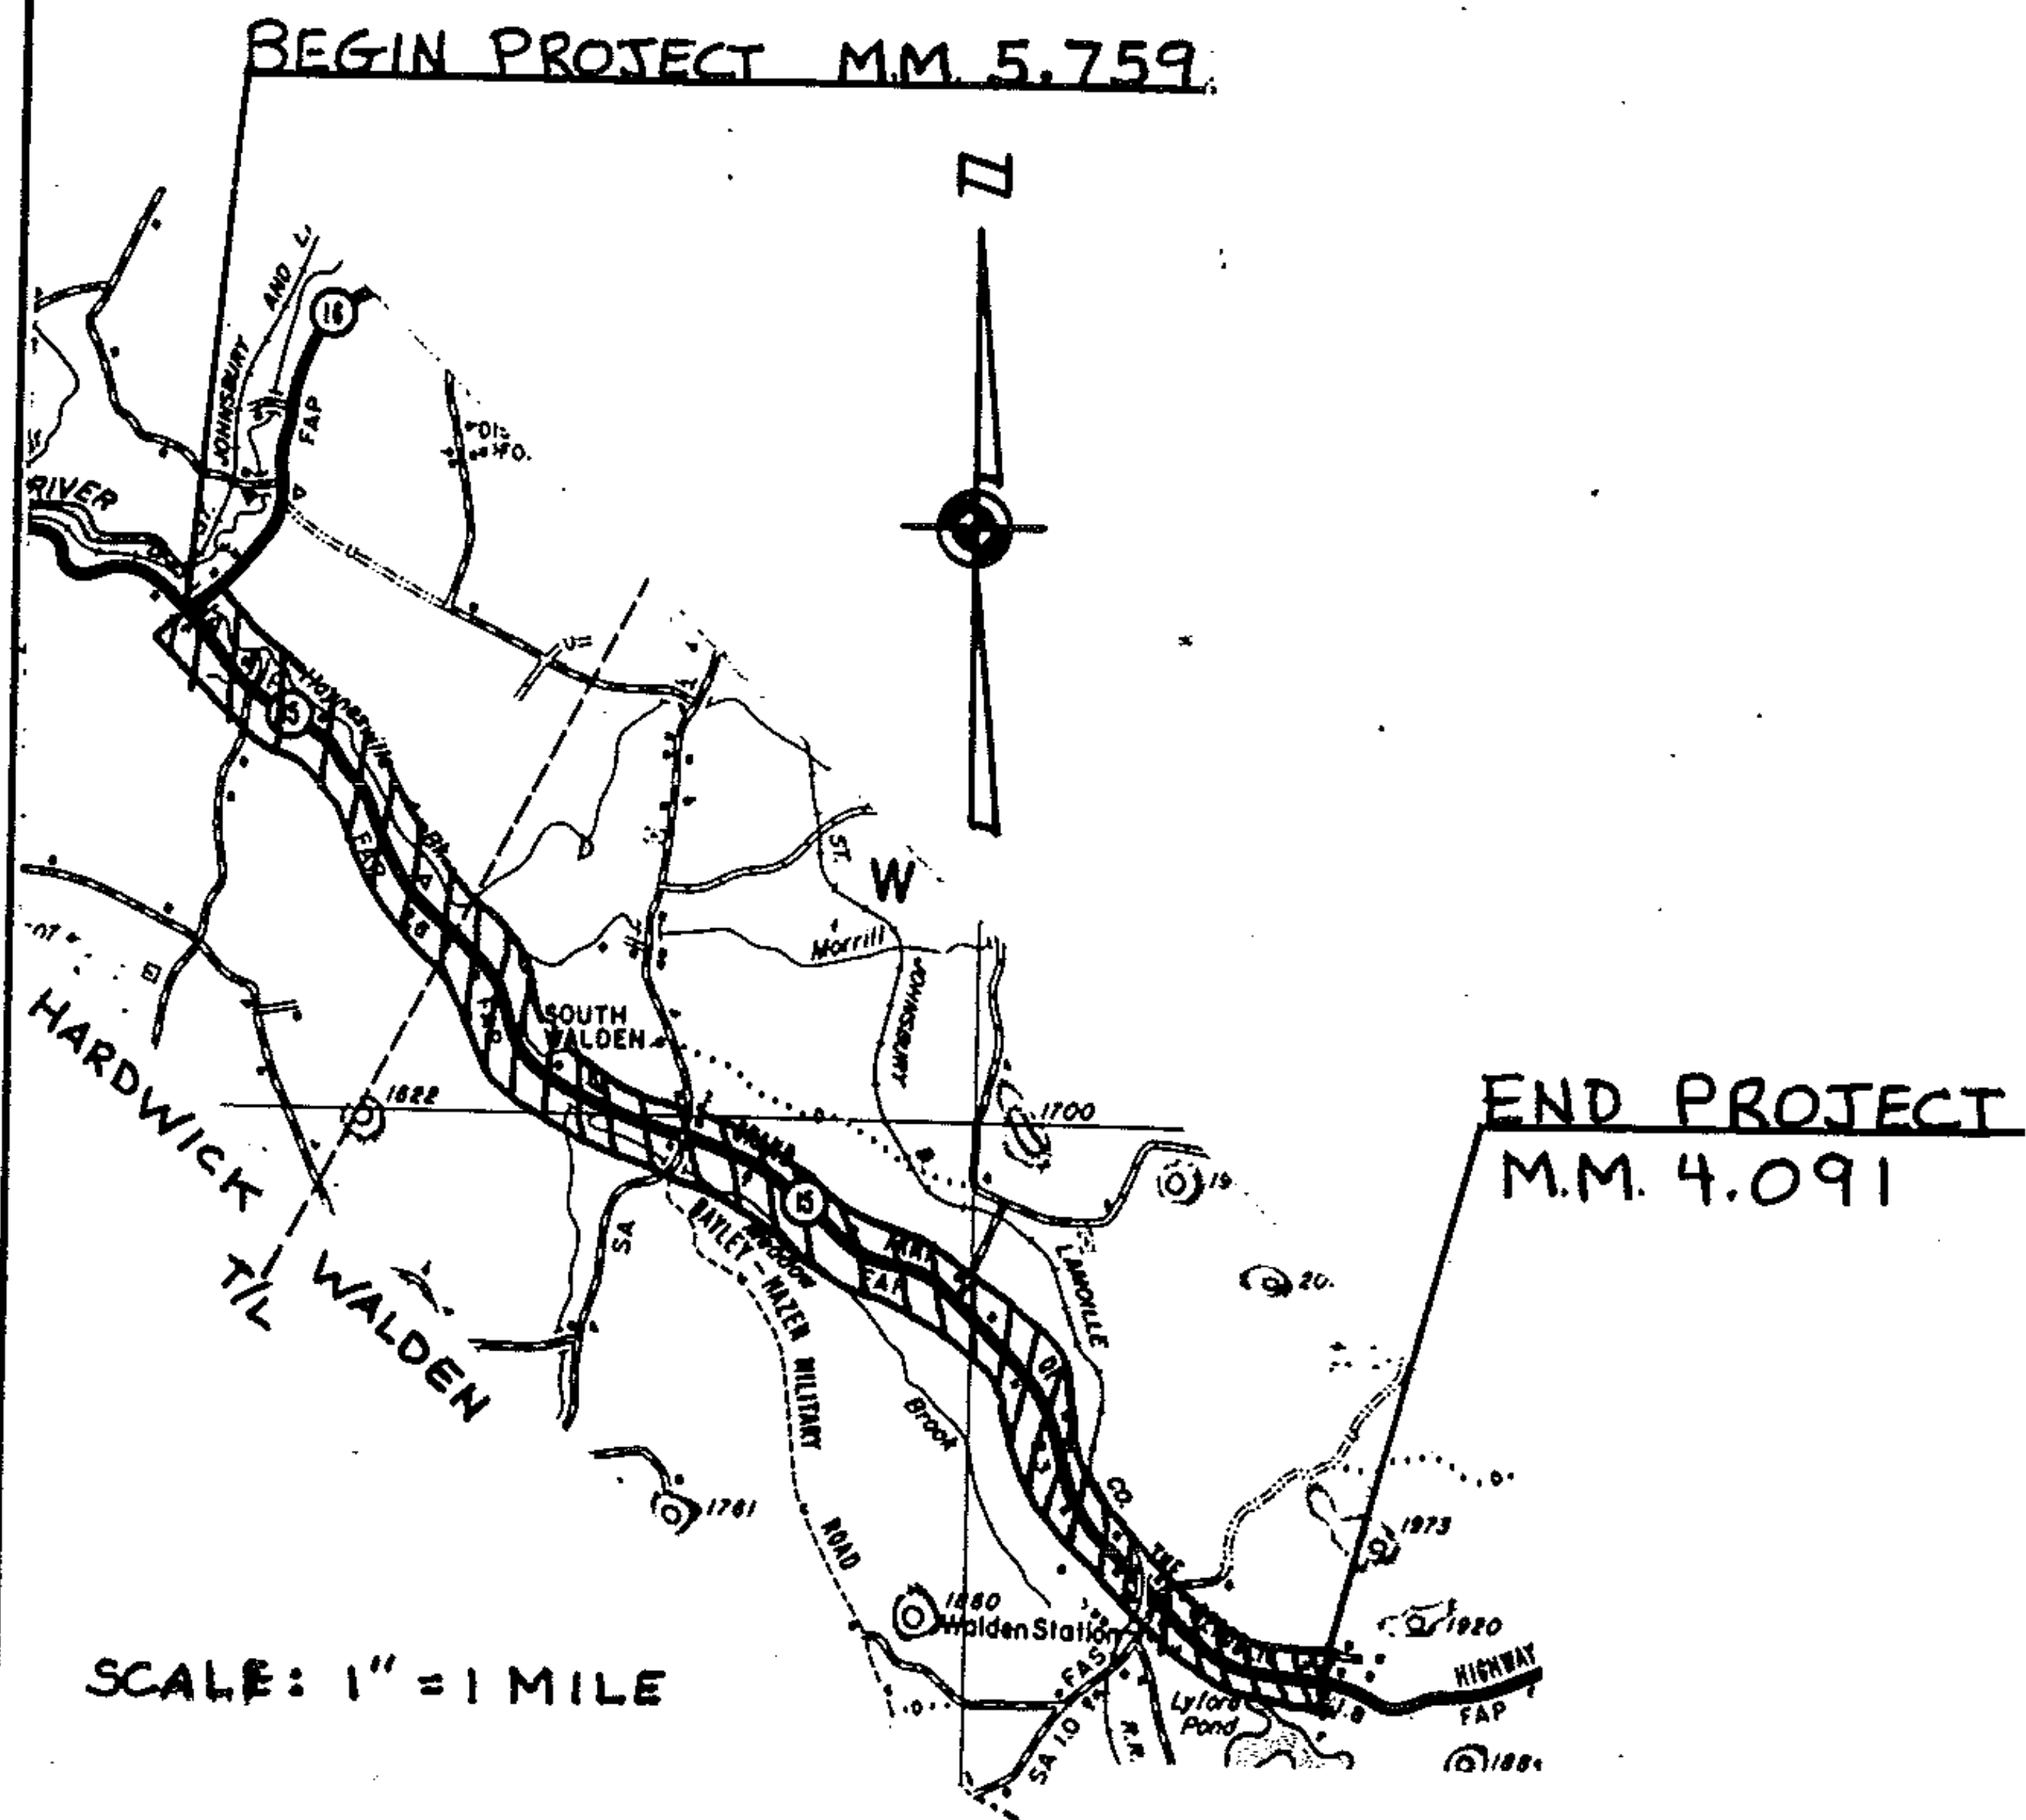

PROJECT HARDWICK-WALDEN

NO. HMA 2820

SHEET 19 OF 81 SHEETS