



PAVING LIMITS FOR DRIVES & TOWN ROADS

PAVING LIMITS FOR TOWN ROADS

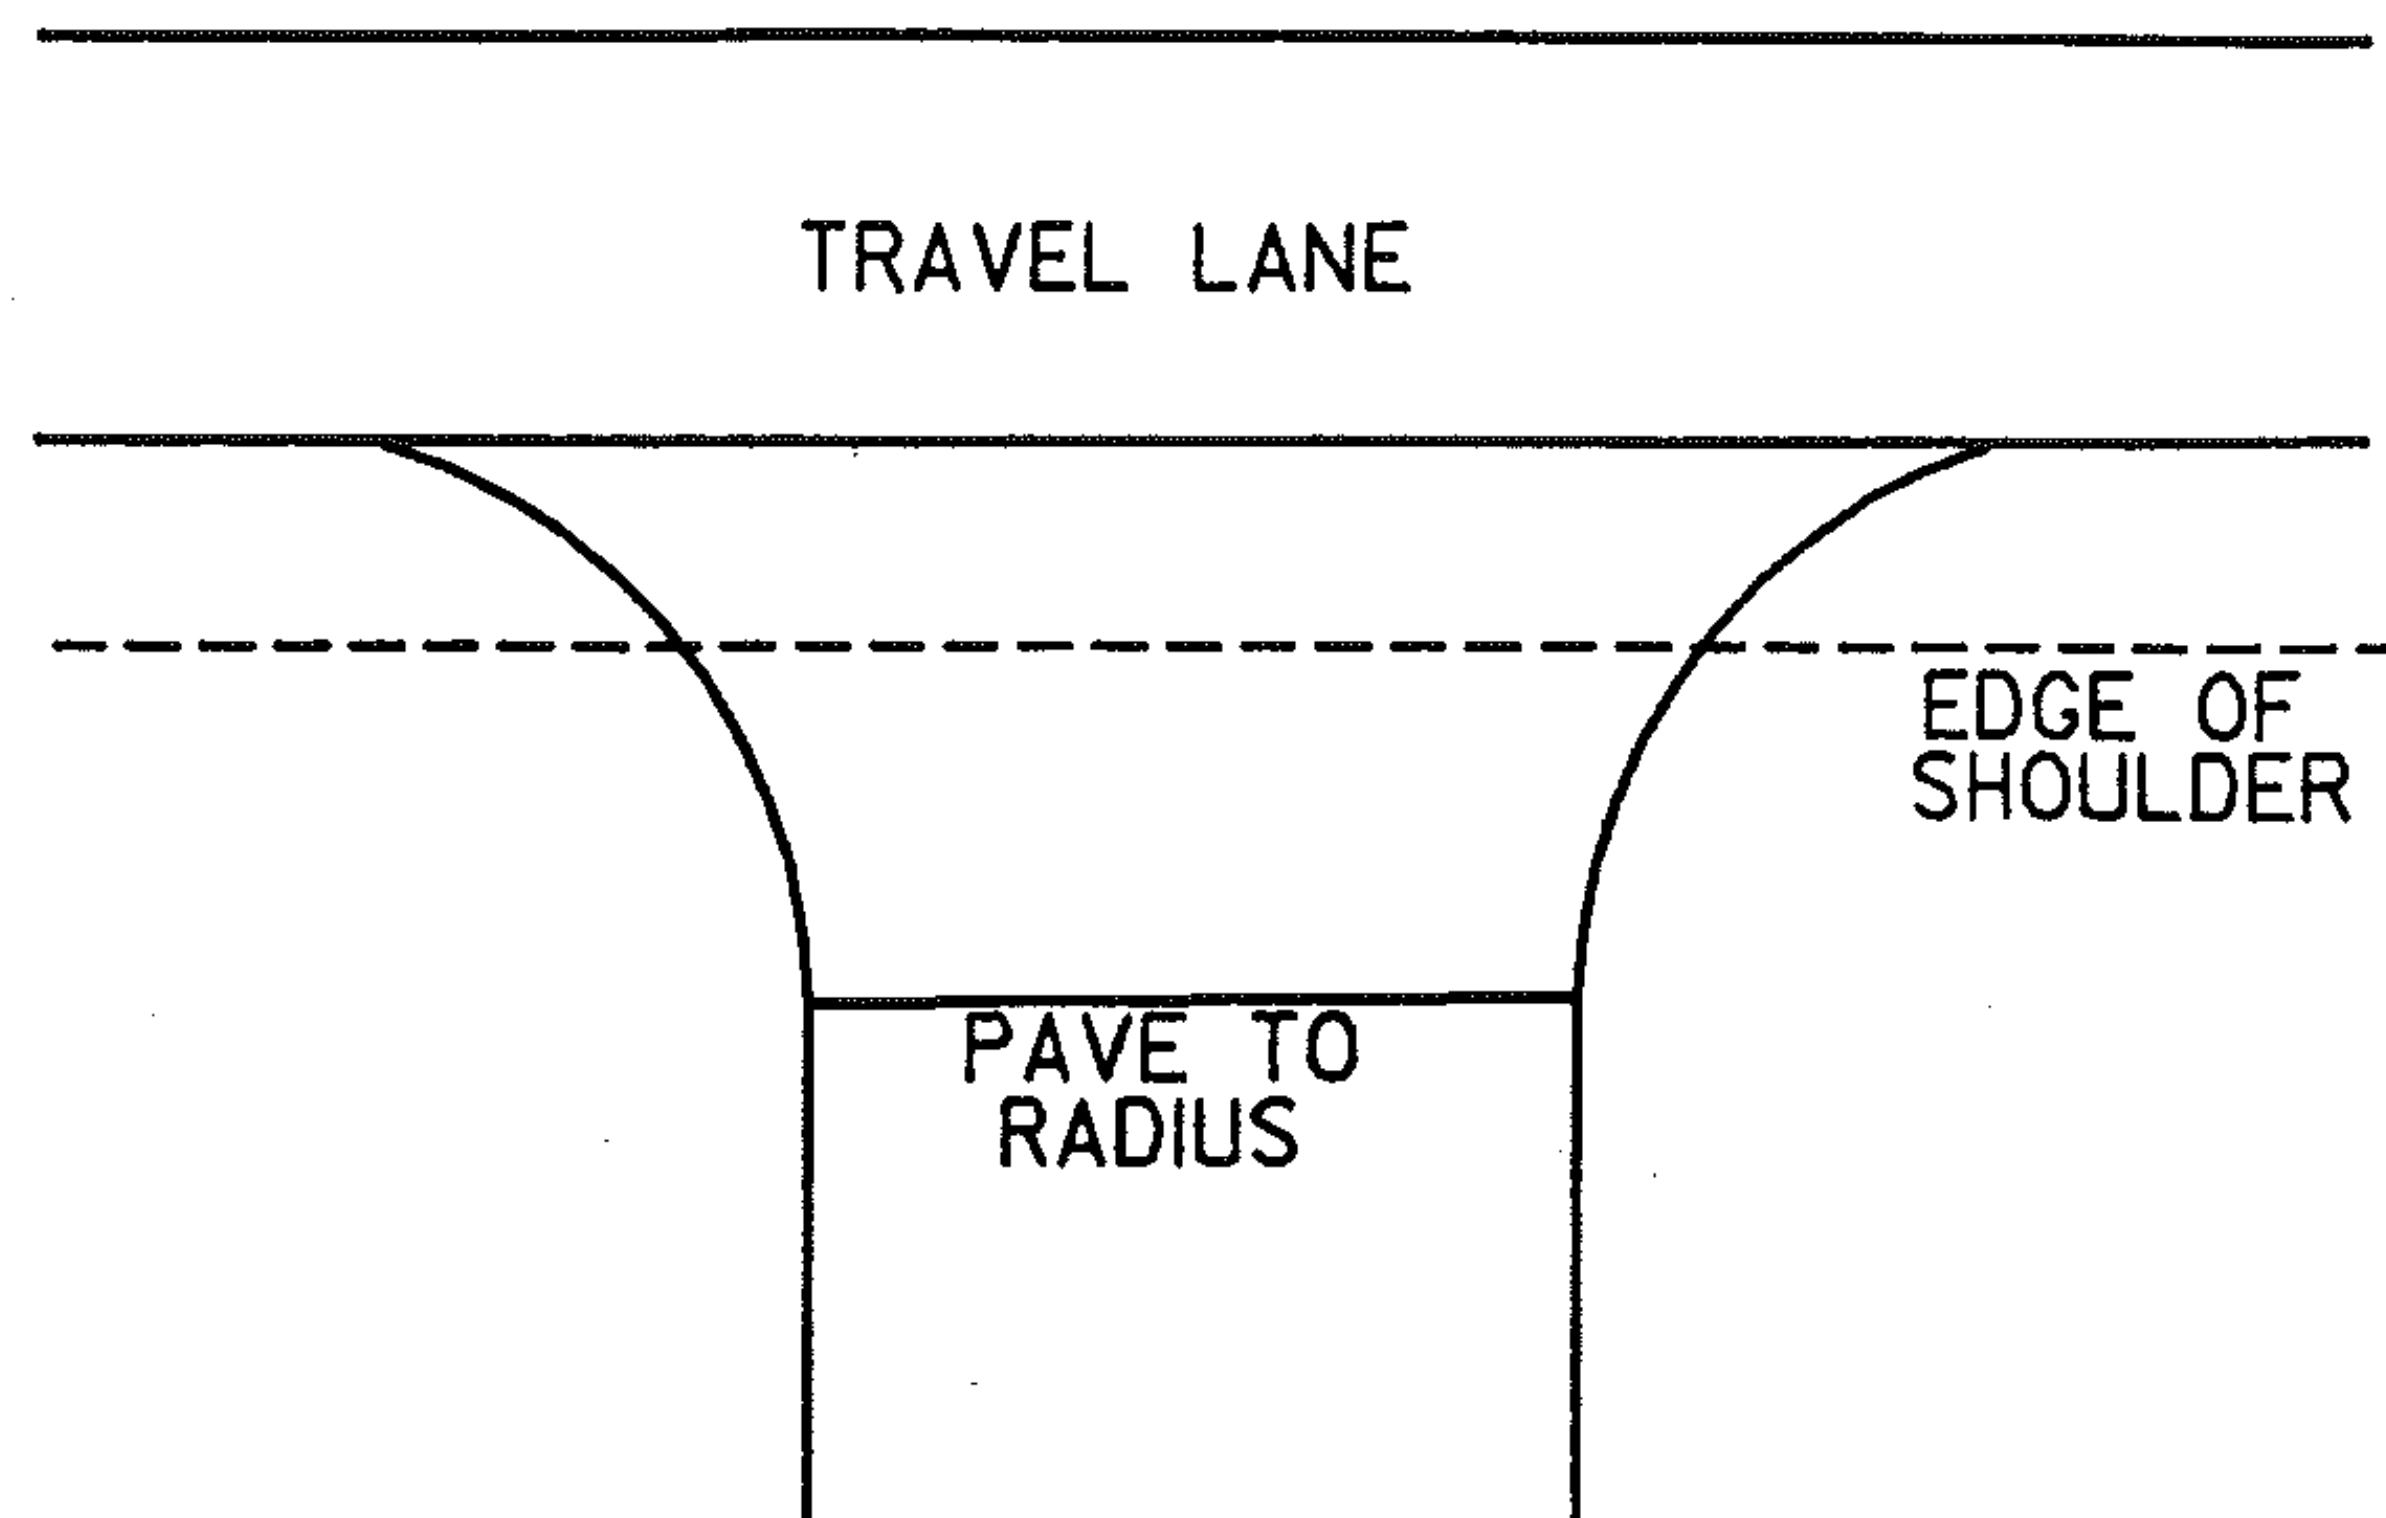

PAVING LIMITS FOR DRIVES

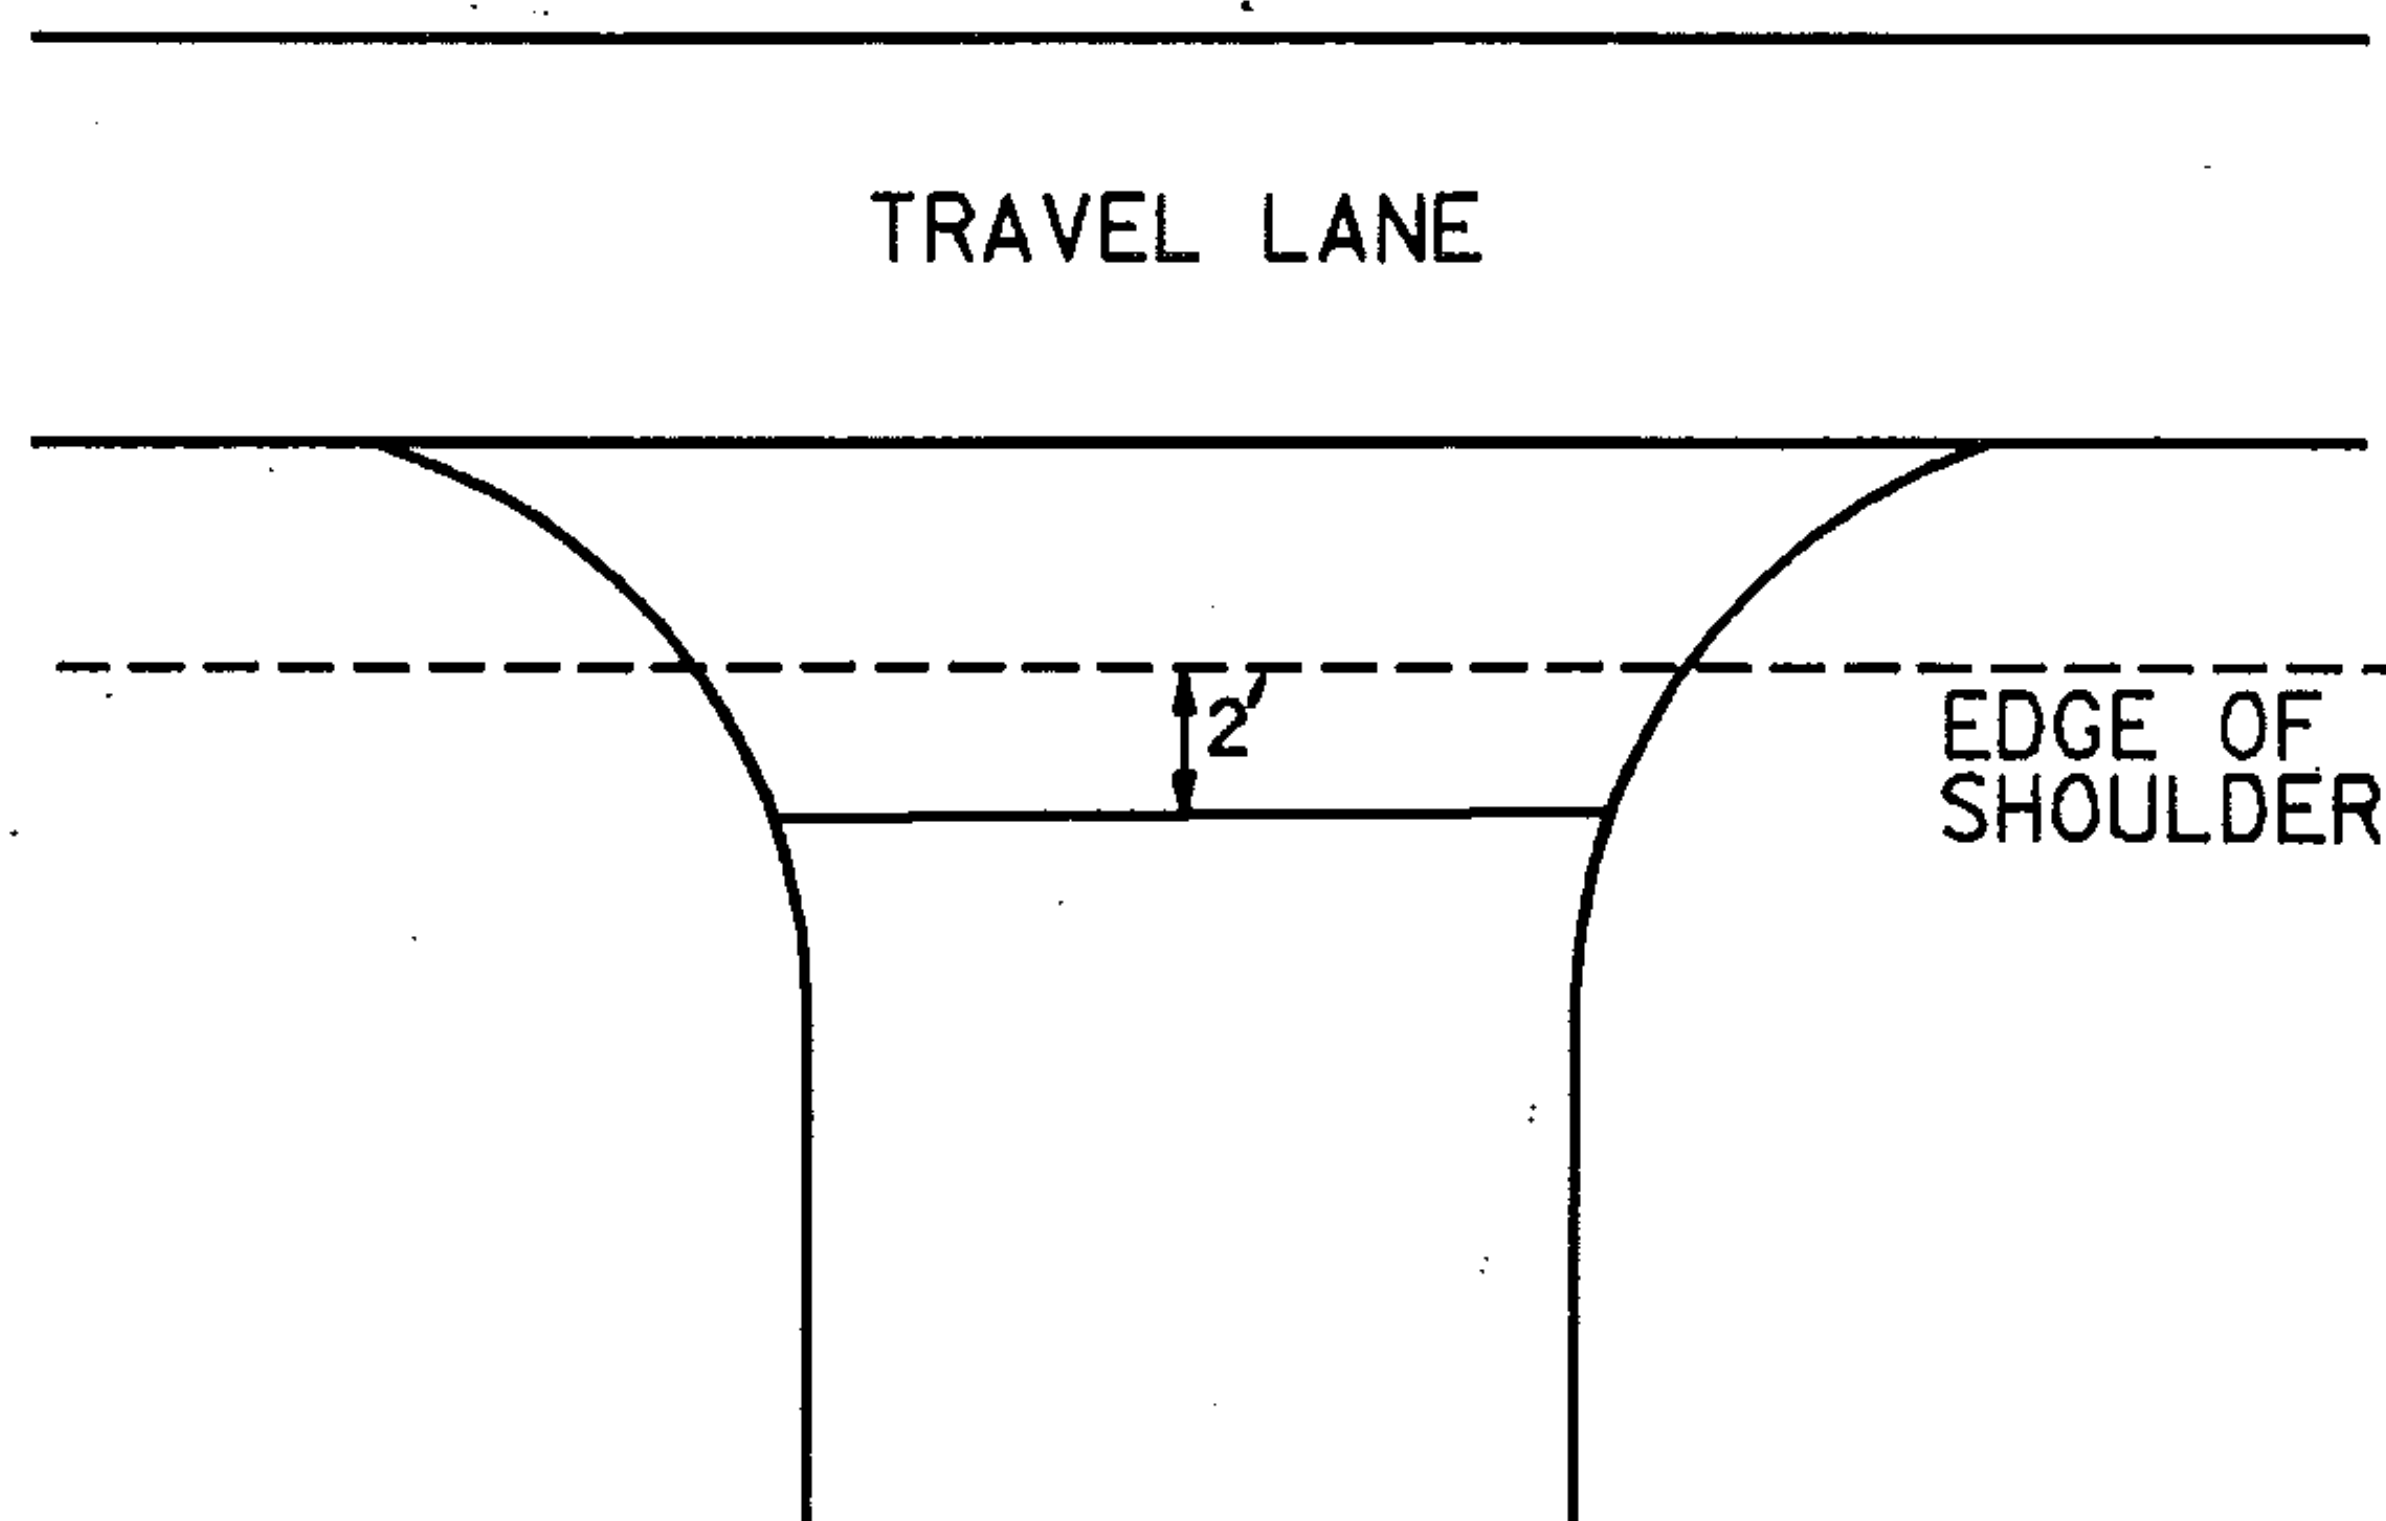

PROJECT HARDWICK-WALDEN

NO. HMA 2820

SHEET 21 OF 81 SHEETS