



PAVING LIMITS FOR DRIVES & TOWN ROADS

PAVING LIMITS FOR TOWN ROADS

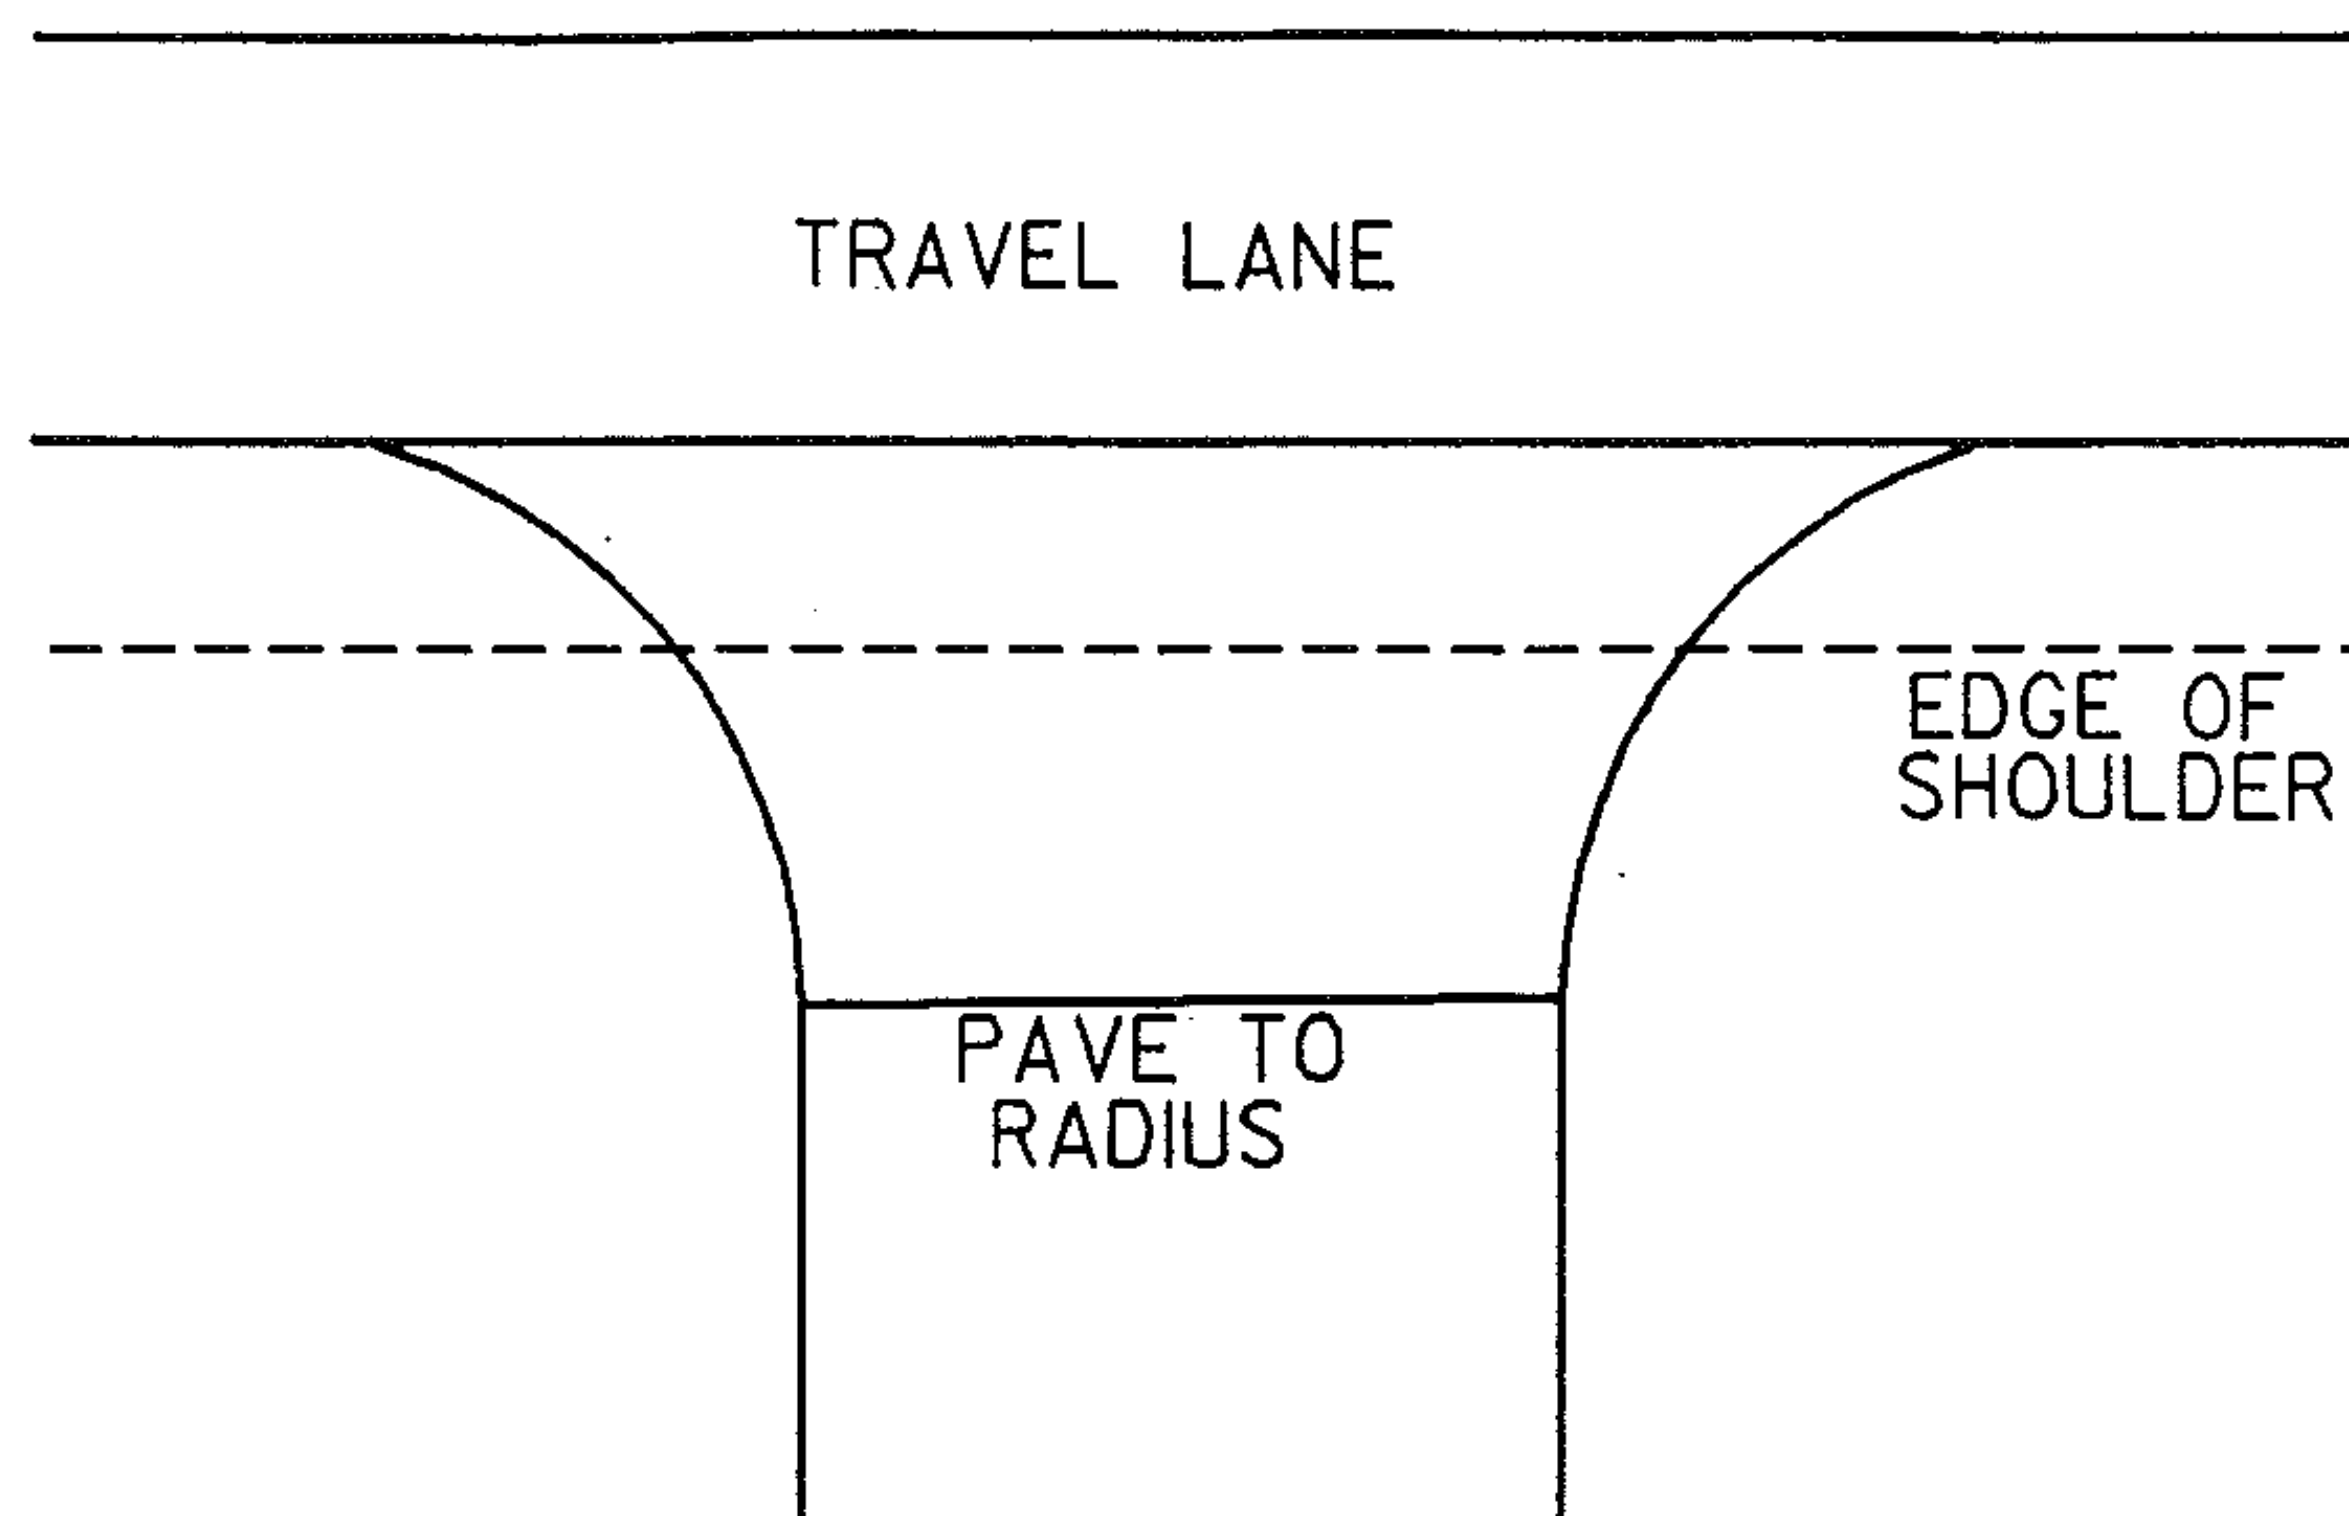

PAVING LIMITS FOR DRIVES

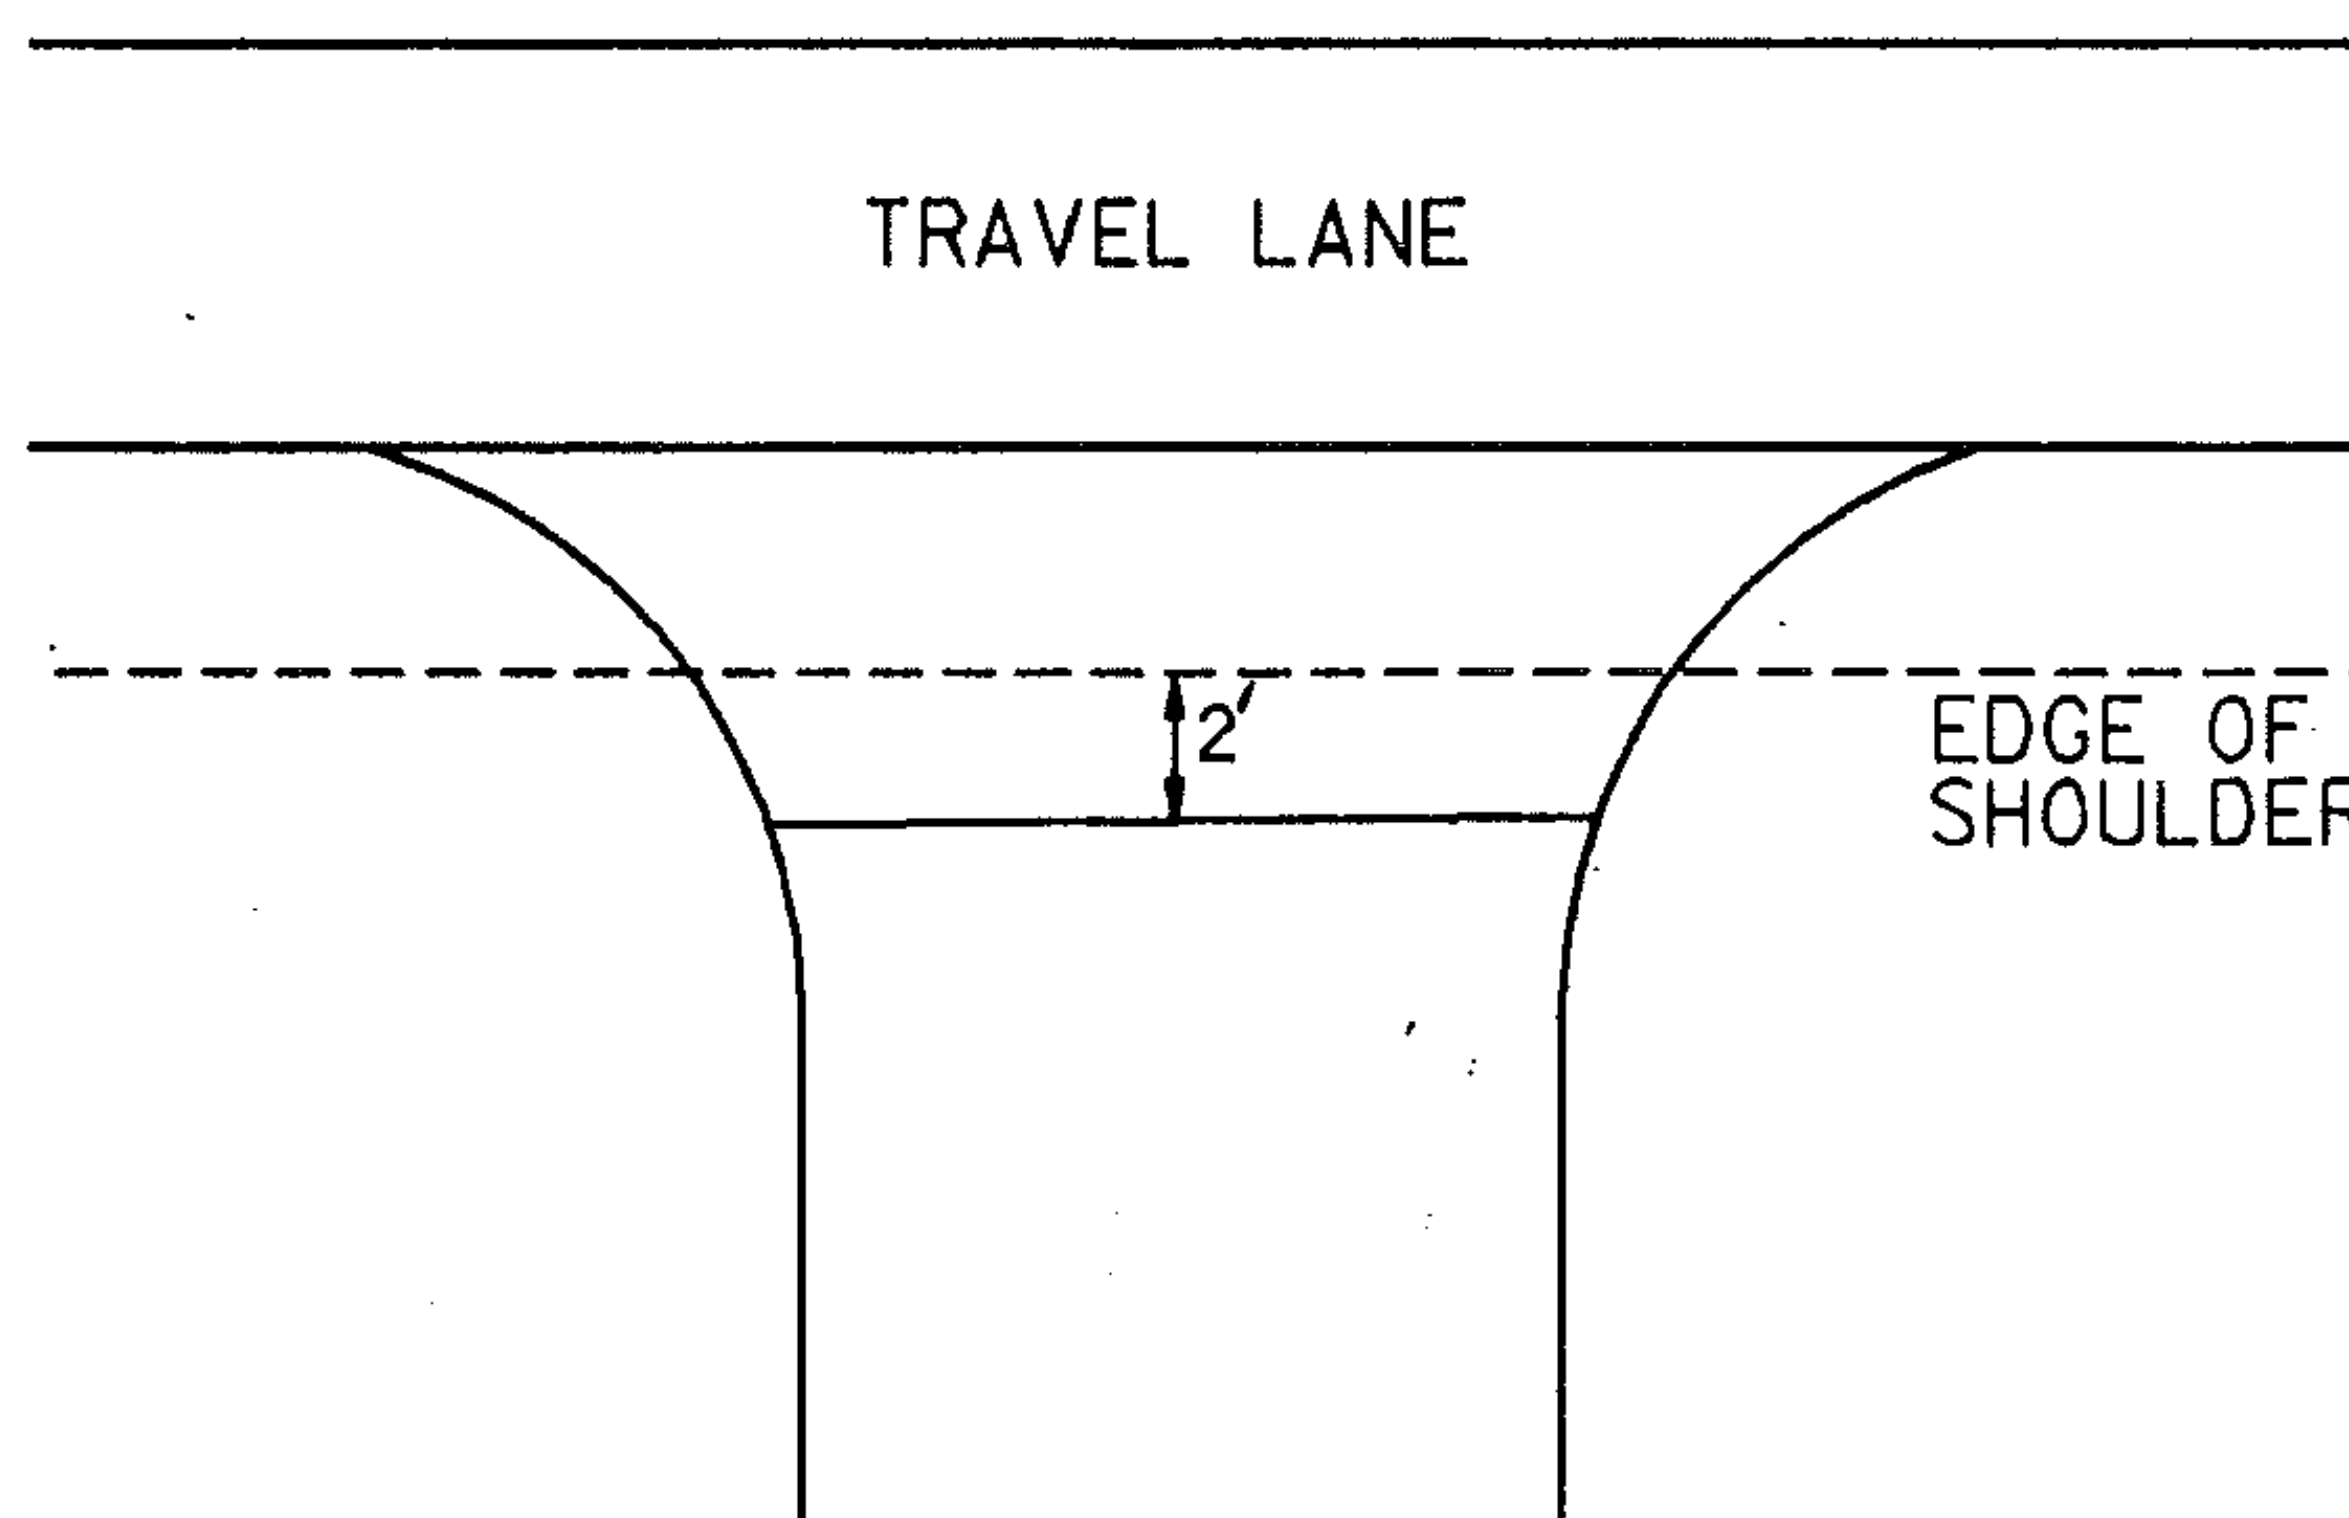

PROJECT MONTPELIER

NO. HMA 2821

SHEET 41 OF 81 SHEETS