



PAVING LIMITS FOR DRIVES & TOWN ROADS

PAVING LIMITS FOR TOWN ROADS

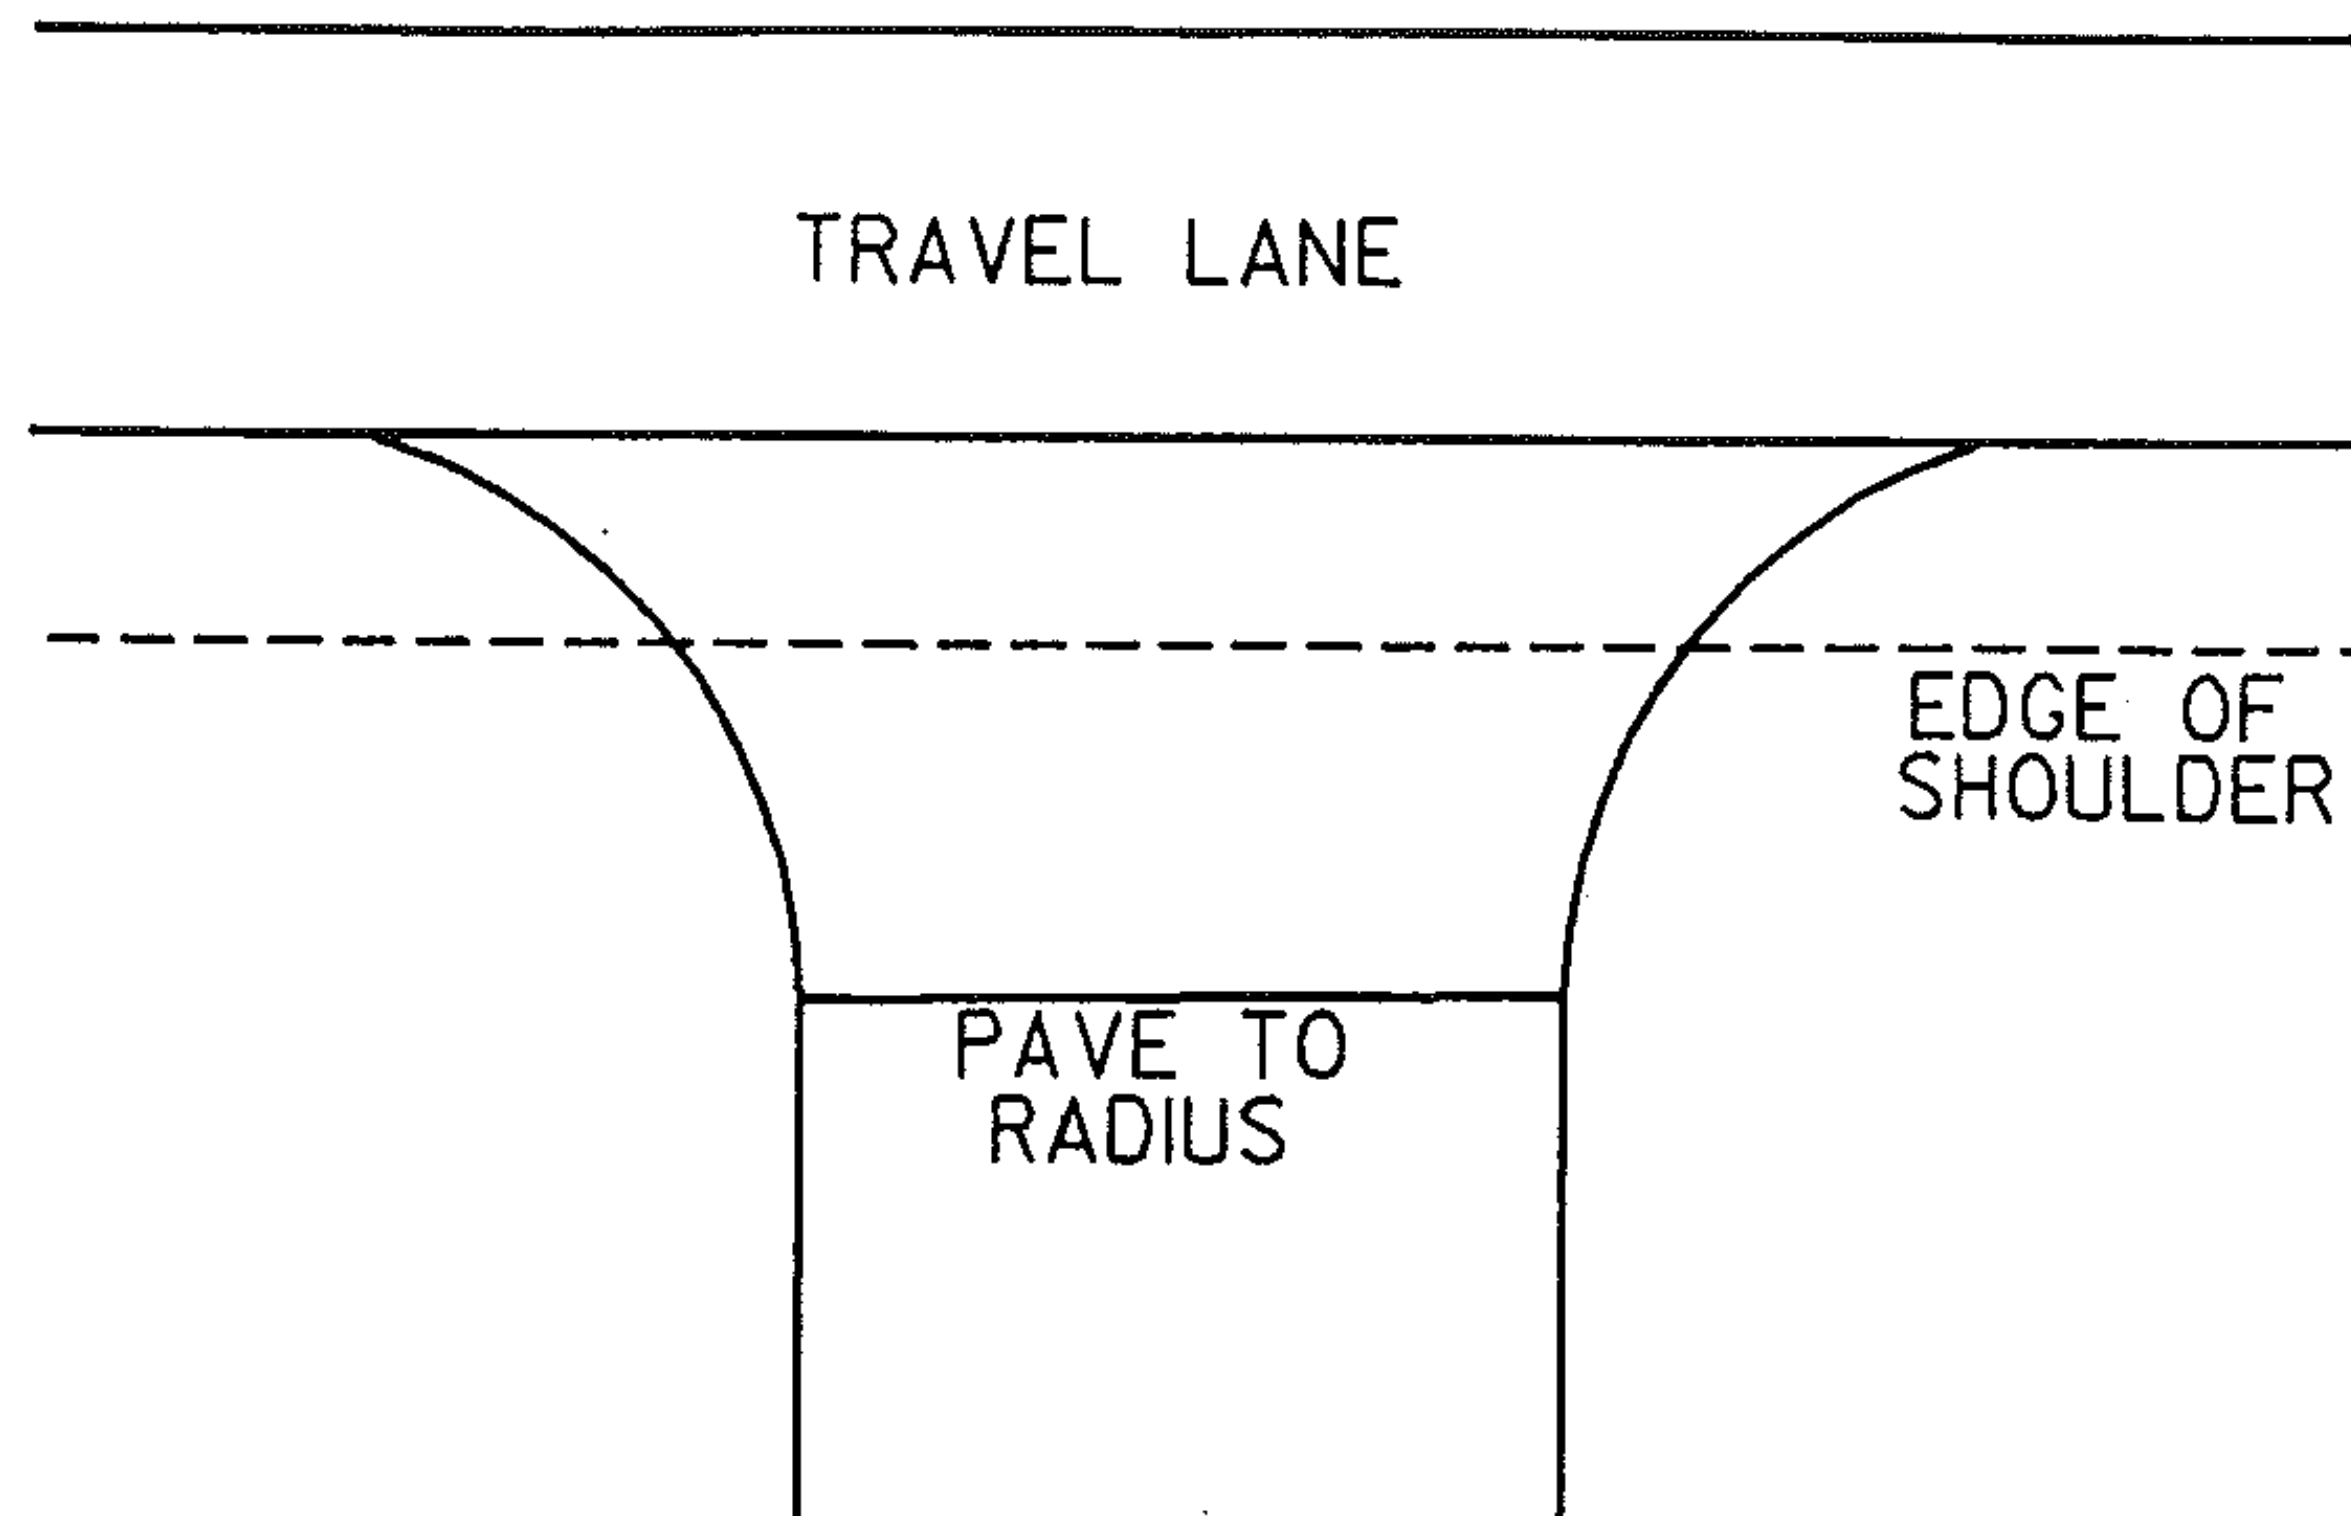

PAVING LIMITS FOR DRIVES

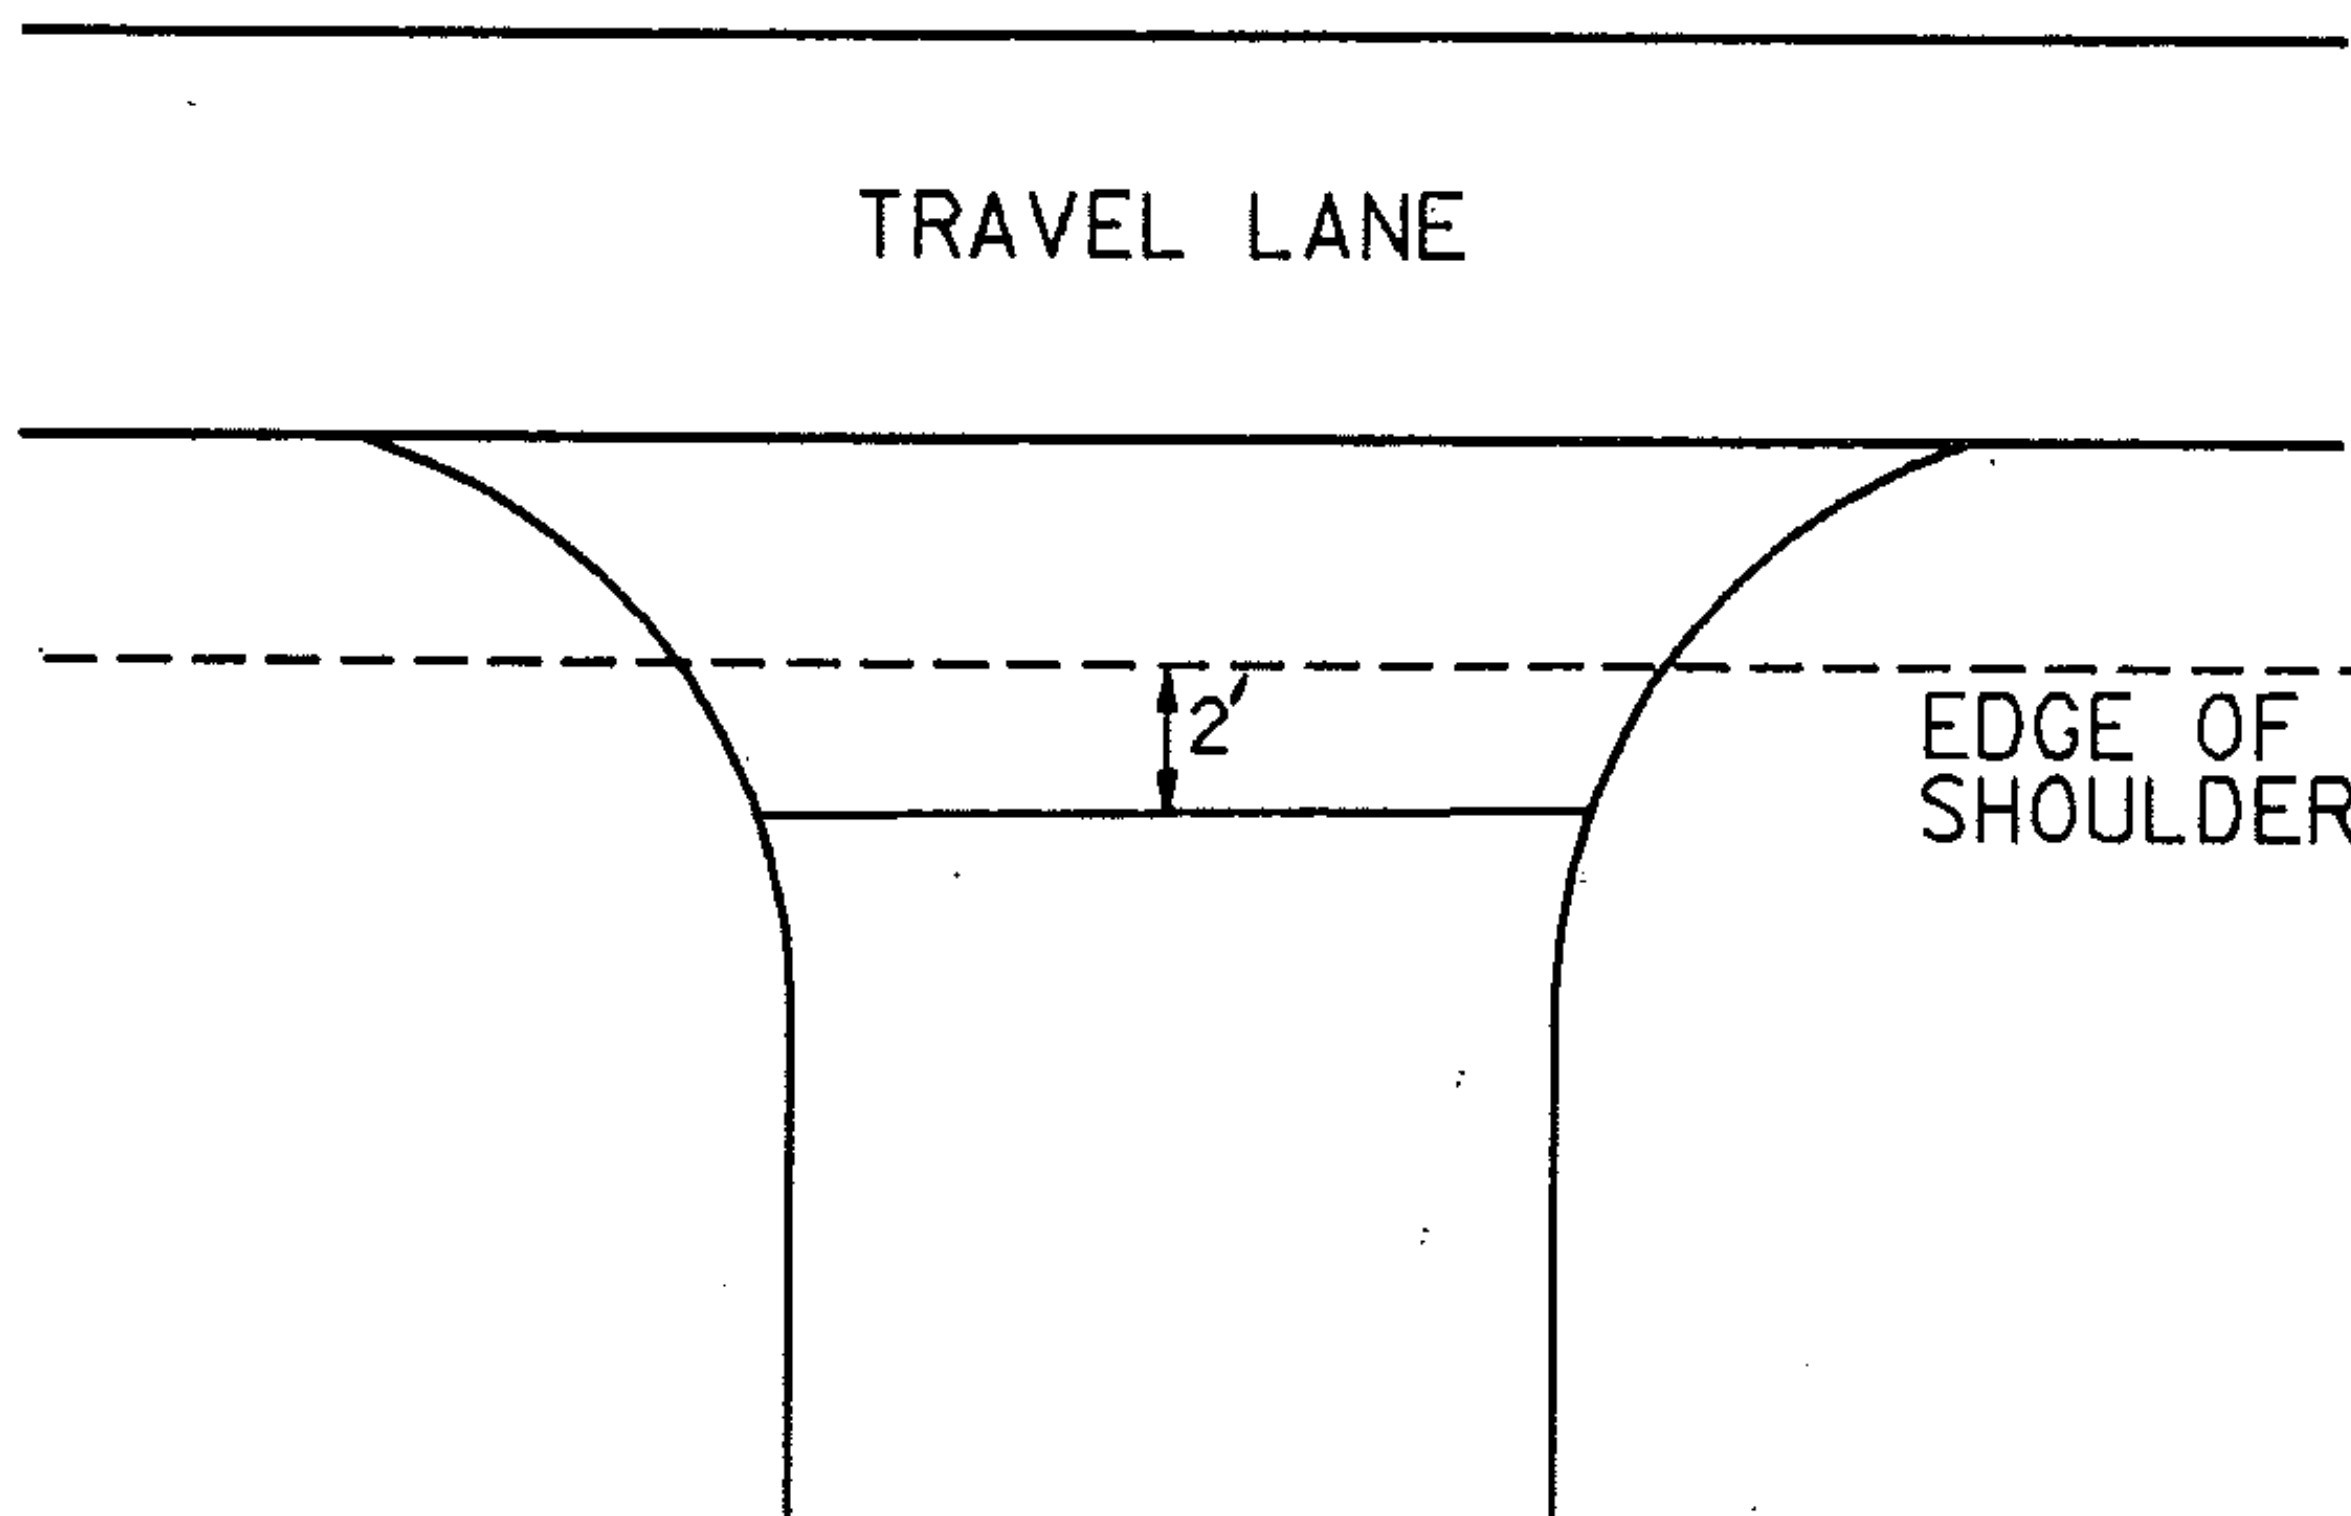

PROJECT Waterford - St. Johnsbury

NO. HMA 2842

SHEET 110F81 SHEETS