


DESCRIPTION AND LOCATION

COLD PLANING DETAIL

NOT TO SCALE

⊕
RAILROAD
OVERPASS @ MM 3.35

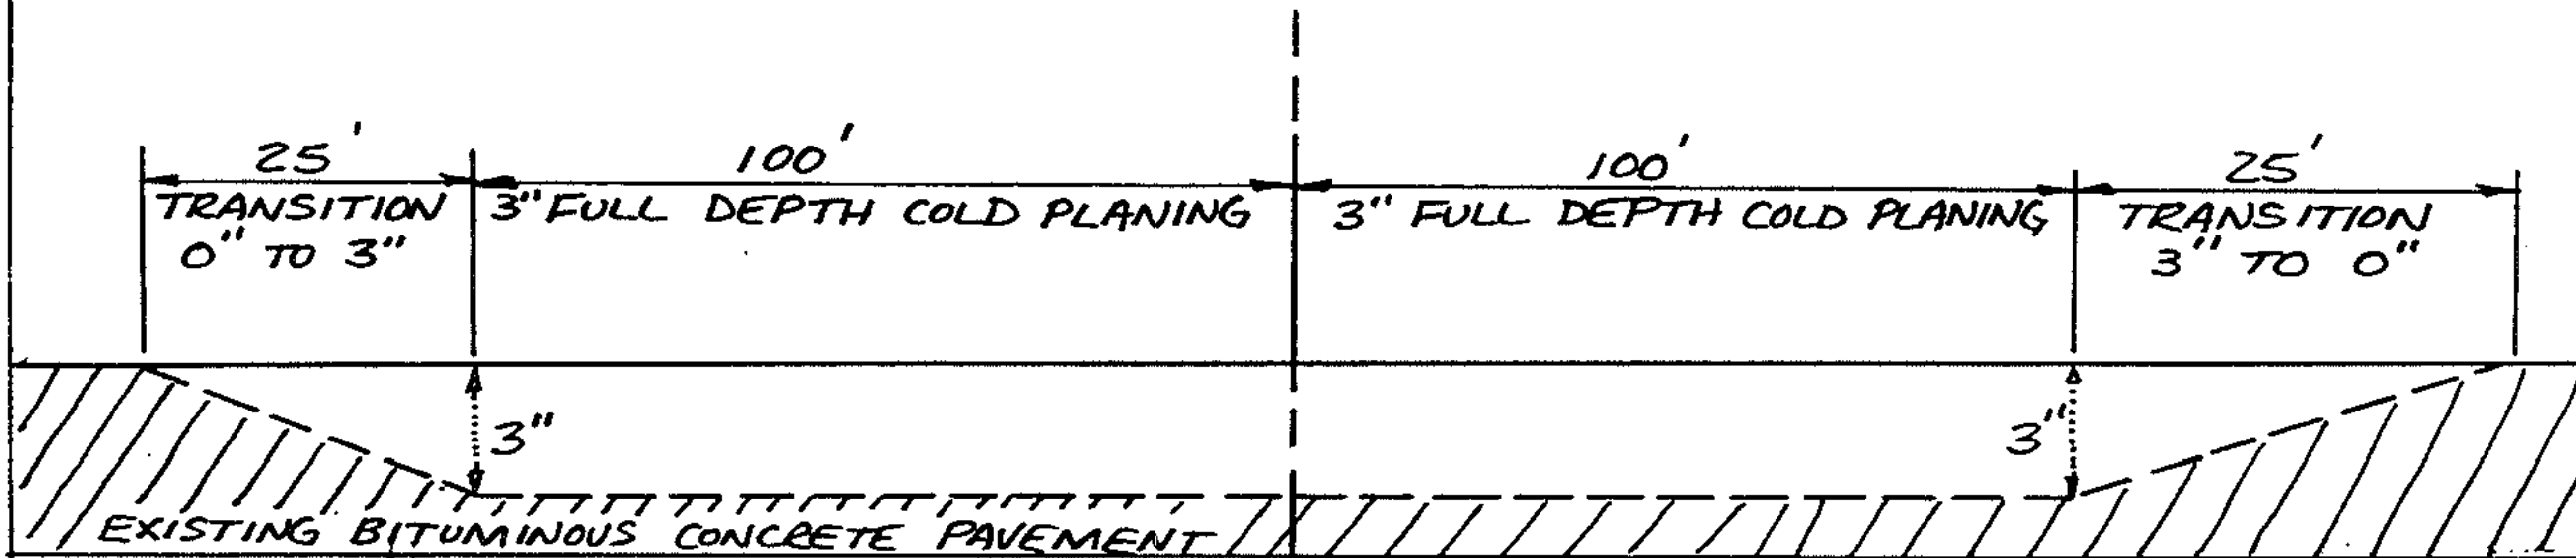

⊕
RAILROAD
OVERPASS

PAVING IN THIS AREA TO
BE 2" BITUMINOUS CONCRETE
PAVEMENT,
3/4" LEVELING COURSE (TYPE IV)
1 1/4" WEARING COURSE (TYPE III)

PROJECT HARDWICK-WALDEN

NO. HMA 2820
SHEET 2⁰ OF 8¹ SHEETS