


DESCRIPTION AND LOCATION

PROJECT LENGTH: 2.477 MILES ; 13,078 FEET  
1985 ADT: 4790

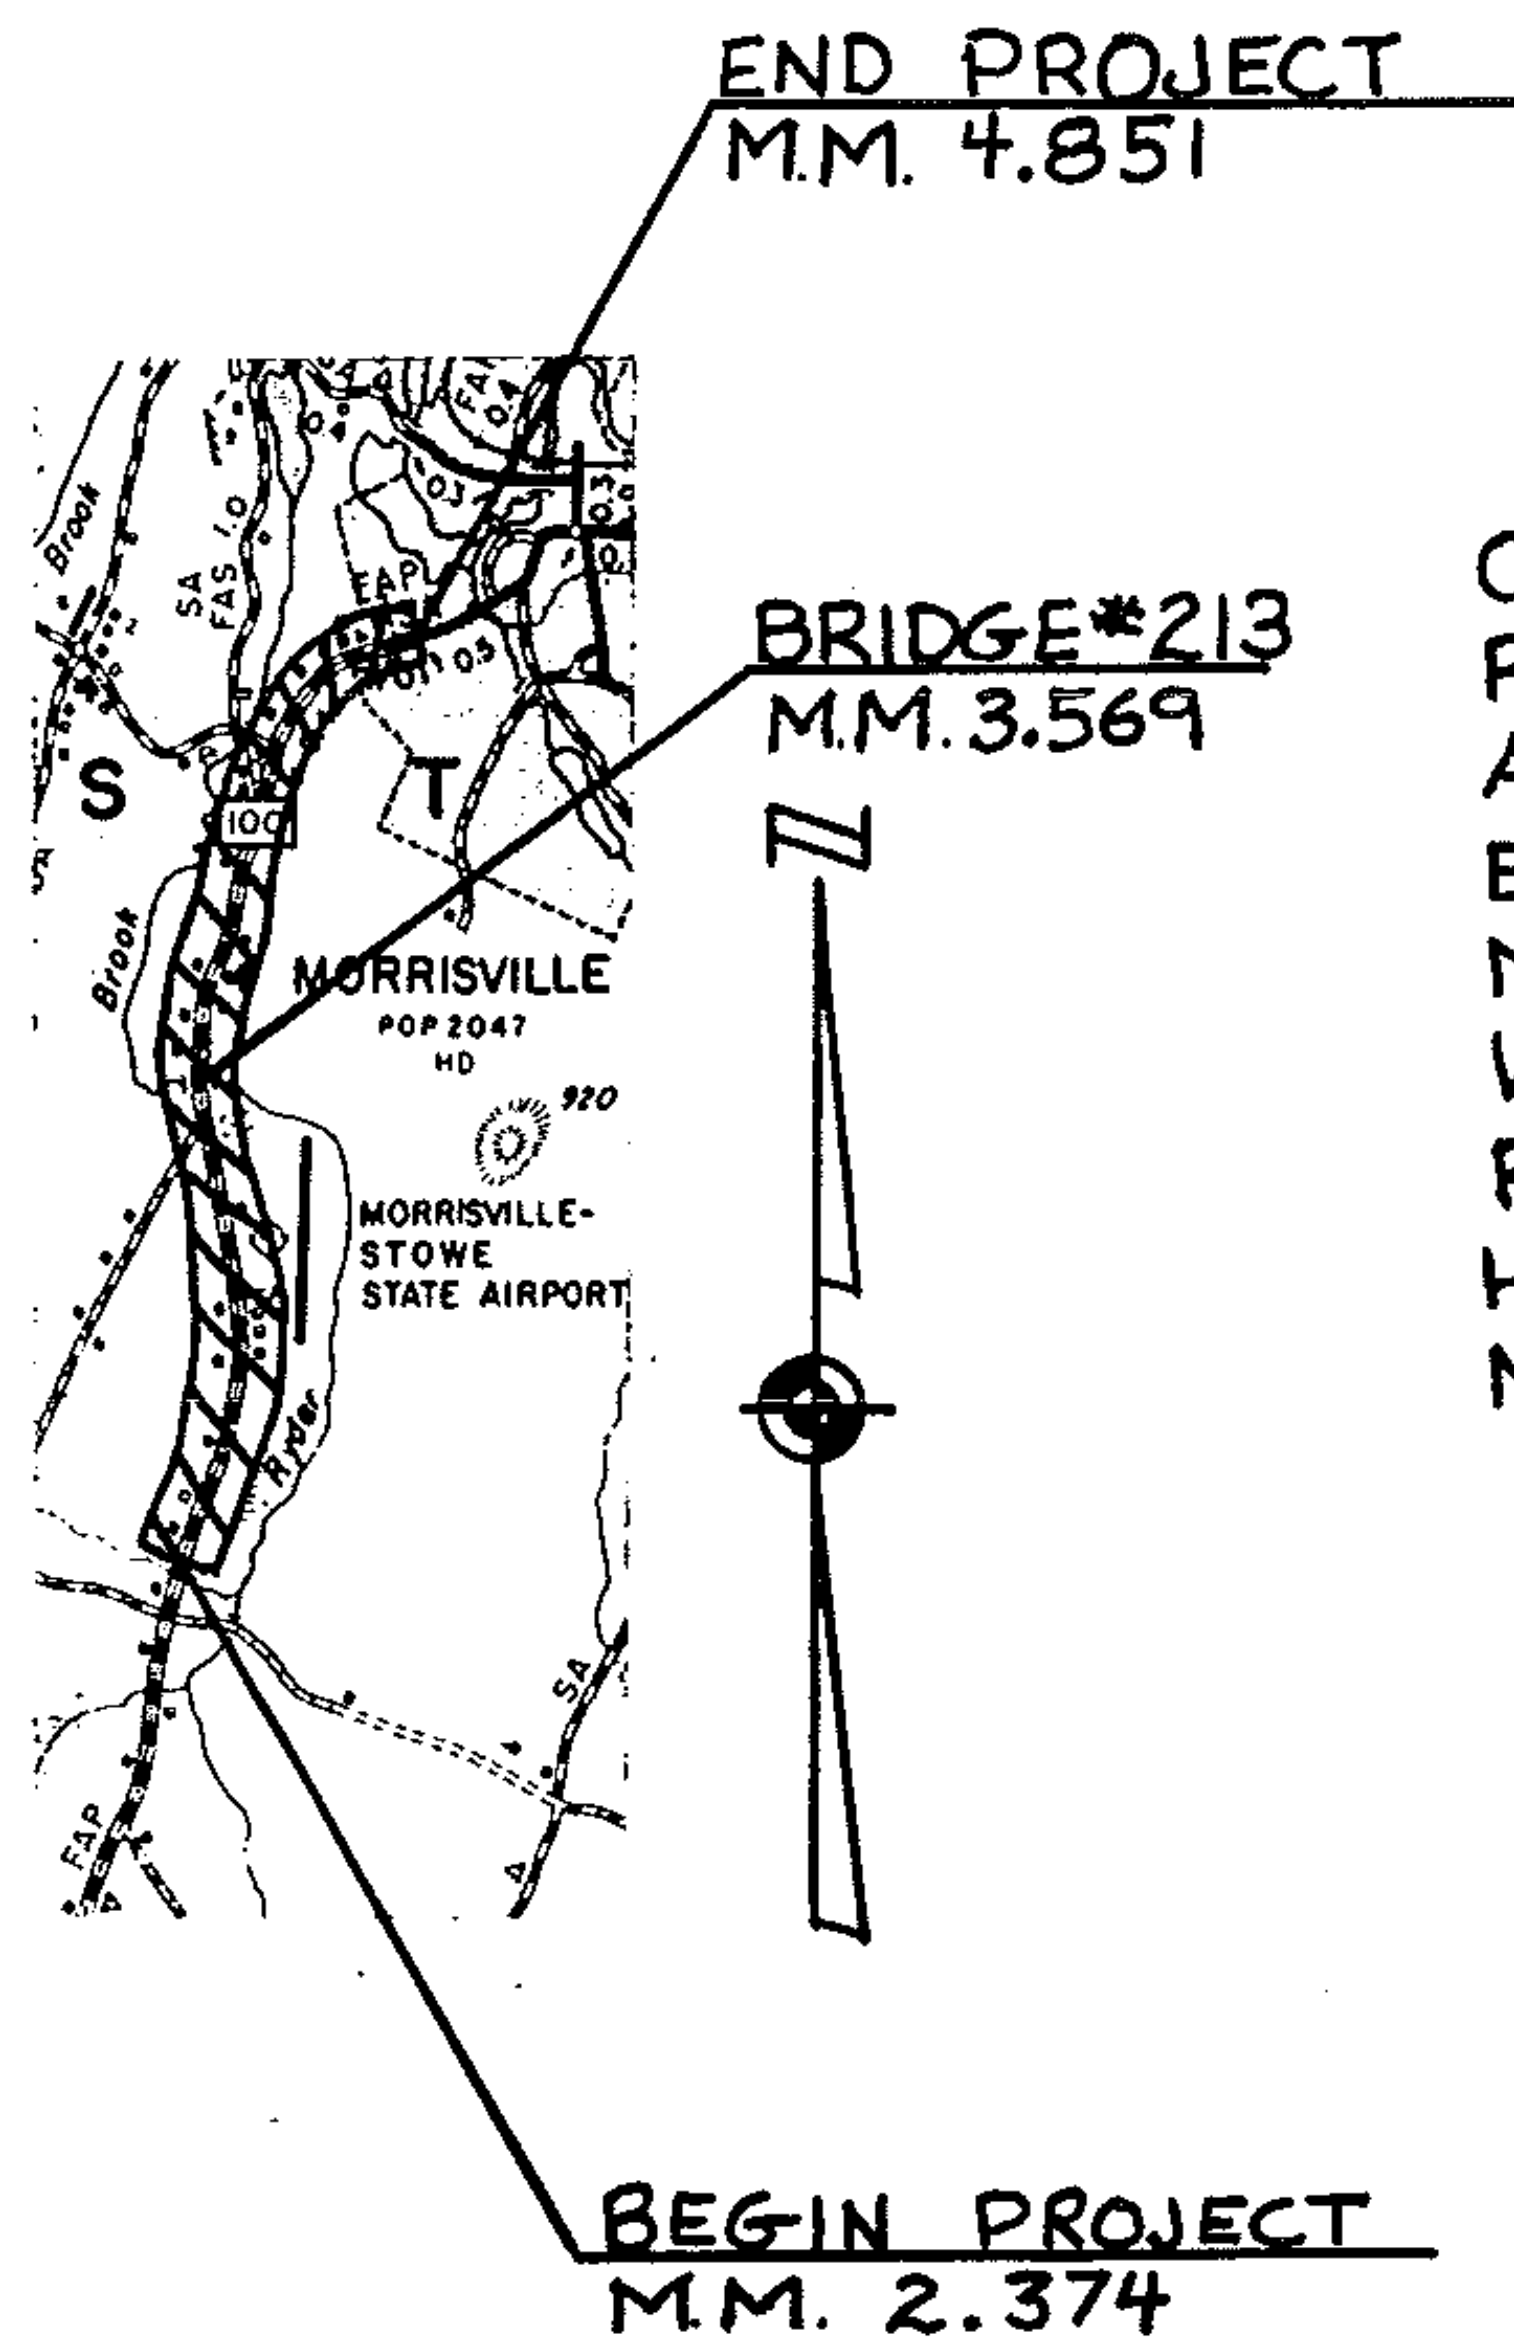

BEGINNING IN THE TOWN OF MORRISTOWN ON ROUTE 100 M.M. 2.374 AND EXTENDING NORTHERLY 2.477 MILES TO M.M. 4.851 IN THE VILLAGE OF MORRISVILLE. RESURFACING OF THE HIGHWAY, NEW PAVEMENT MARKINGS.

SCALE: 1" = 1 MILE

PROJECT MORRISTOWN

NO. HMA 2817

SHEET 29 OF 61 SHEETS