

DESCRIPTION AND LOCATION


PROJECT LENGTH: 0.953 MILES , 5031.84 FEET

1986 A.D.T.: 870

BEGINNING IN THE CITY OF MONTPELIER ON MONTPELIER JUNCTION STATE HIGHWAY AT MEMORIAL DRIVE AND M.M. 0.000 AND EXTENDING WESTERLY AND SOUTHERLY TO M.M. 0.757 AT THE BERLIN TOWN LINE RESURFACING OF THE HIGHWAY AND ITS APPROACHES, NEW PAVEMENT MARKINGS AND SIGN REHABILITATION.

BEGIN PROJECT
M.M. 0.000

END PROJECT M.M. 0.757

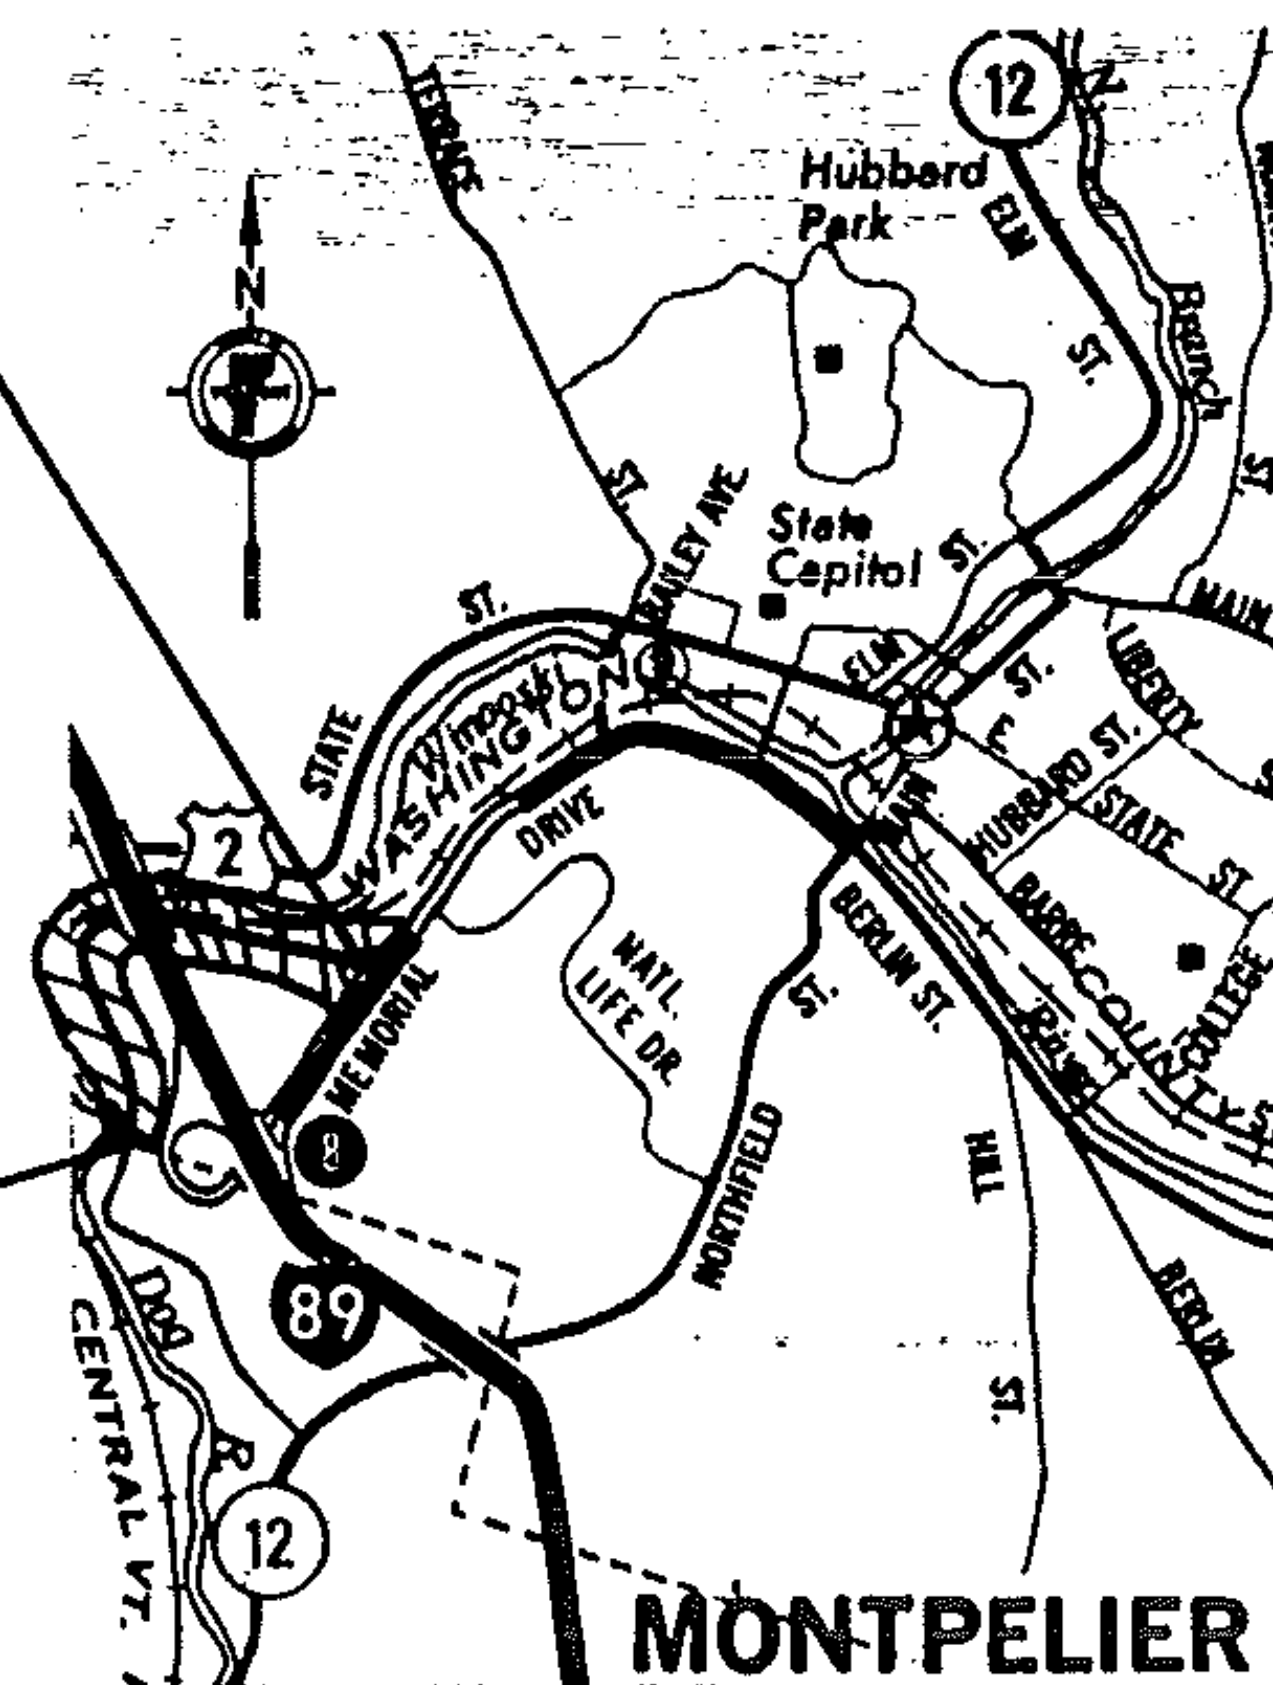

PROJECT MONTPELIER

NO. HMA 282.1

SHEET 39 OF 81 SHEETS