


# TYPICAL SECTIONS & DESIGN DATA

BITUMINOUS CONCRETE PAVEMENT  
 LEVELING COURSE TYPE IV (532 TONS/MILE)  
 AS DIRECTED BY THE ENGINEER.  
 1 1/4" WEARING COURSE TYPE III (±1/4" THICKNESS TOLERANCE)

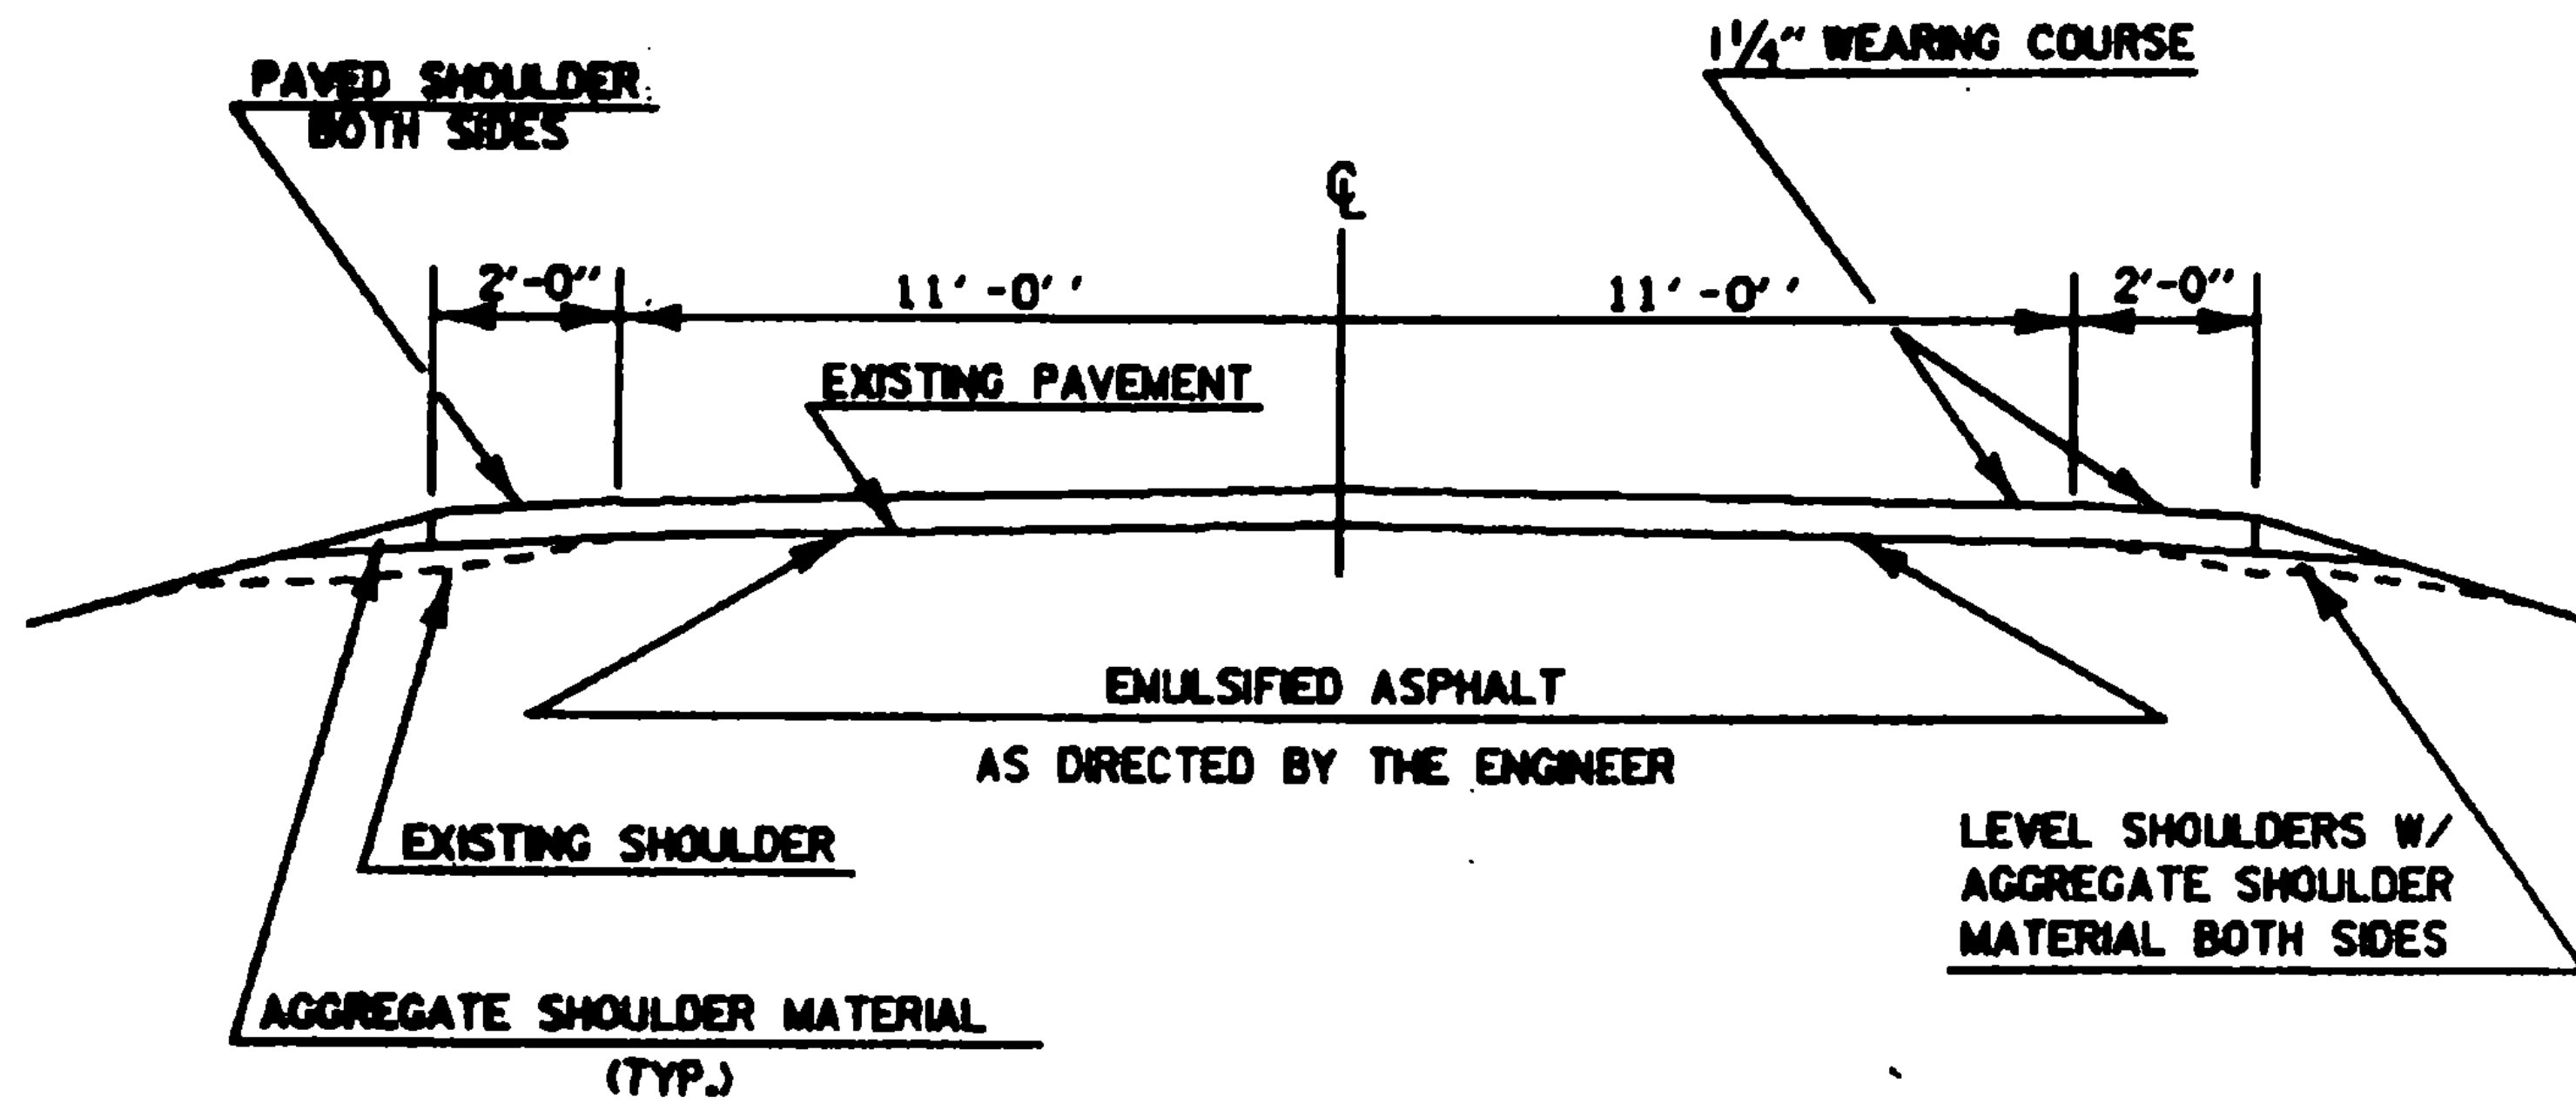

VT. 100 HANCOCK GRANVILLE  
 MM 1.320 ~ MM 0.110

NOTE : WHEN ENCOUNTERING VEGETATION OR POOR MATERIAL IN THE SHOULDER AREA, REMOVE 2" BELOW EXISTING PAVEMENT LEVEL AND REPLACE WITH AGGREGATE SHOULDER MATERIAL. REMOVAL OF THIS MATERIAL WILL BE PAID FOR UNDER THE ITEM 'ALL PURPOSE EXCAVATOR RENTAL' OR 'GRADER RENTAL'.

PROJECT HANCOCK-GRANVILLE

NO. HMA 2823  
 SHEET 4 OF 10 SHEETS  
 SHEET 16 OF 38 SHEETS