



PAVING LIMITS FOR DRIVES & TOWN ROADS

PAVING LIMITS FOR TOWN ROADS

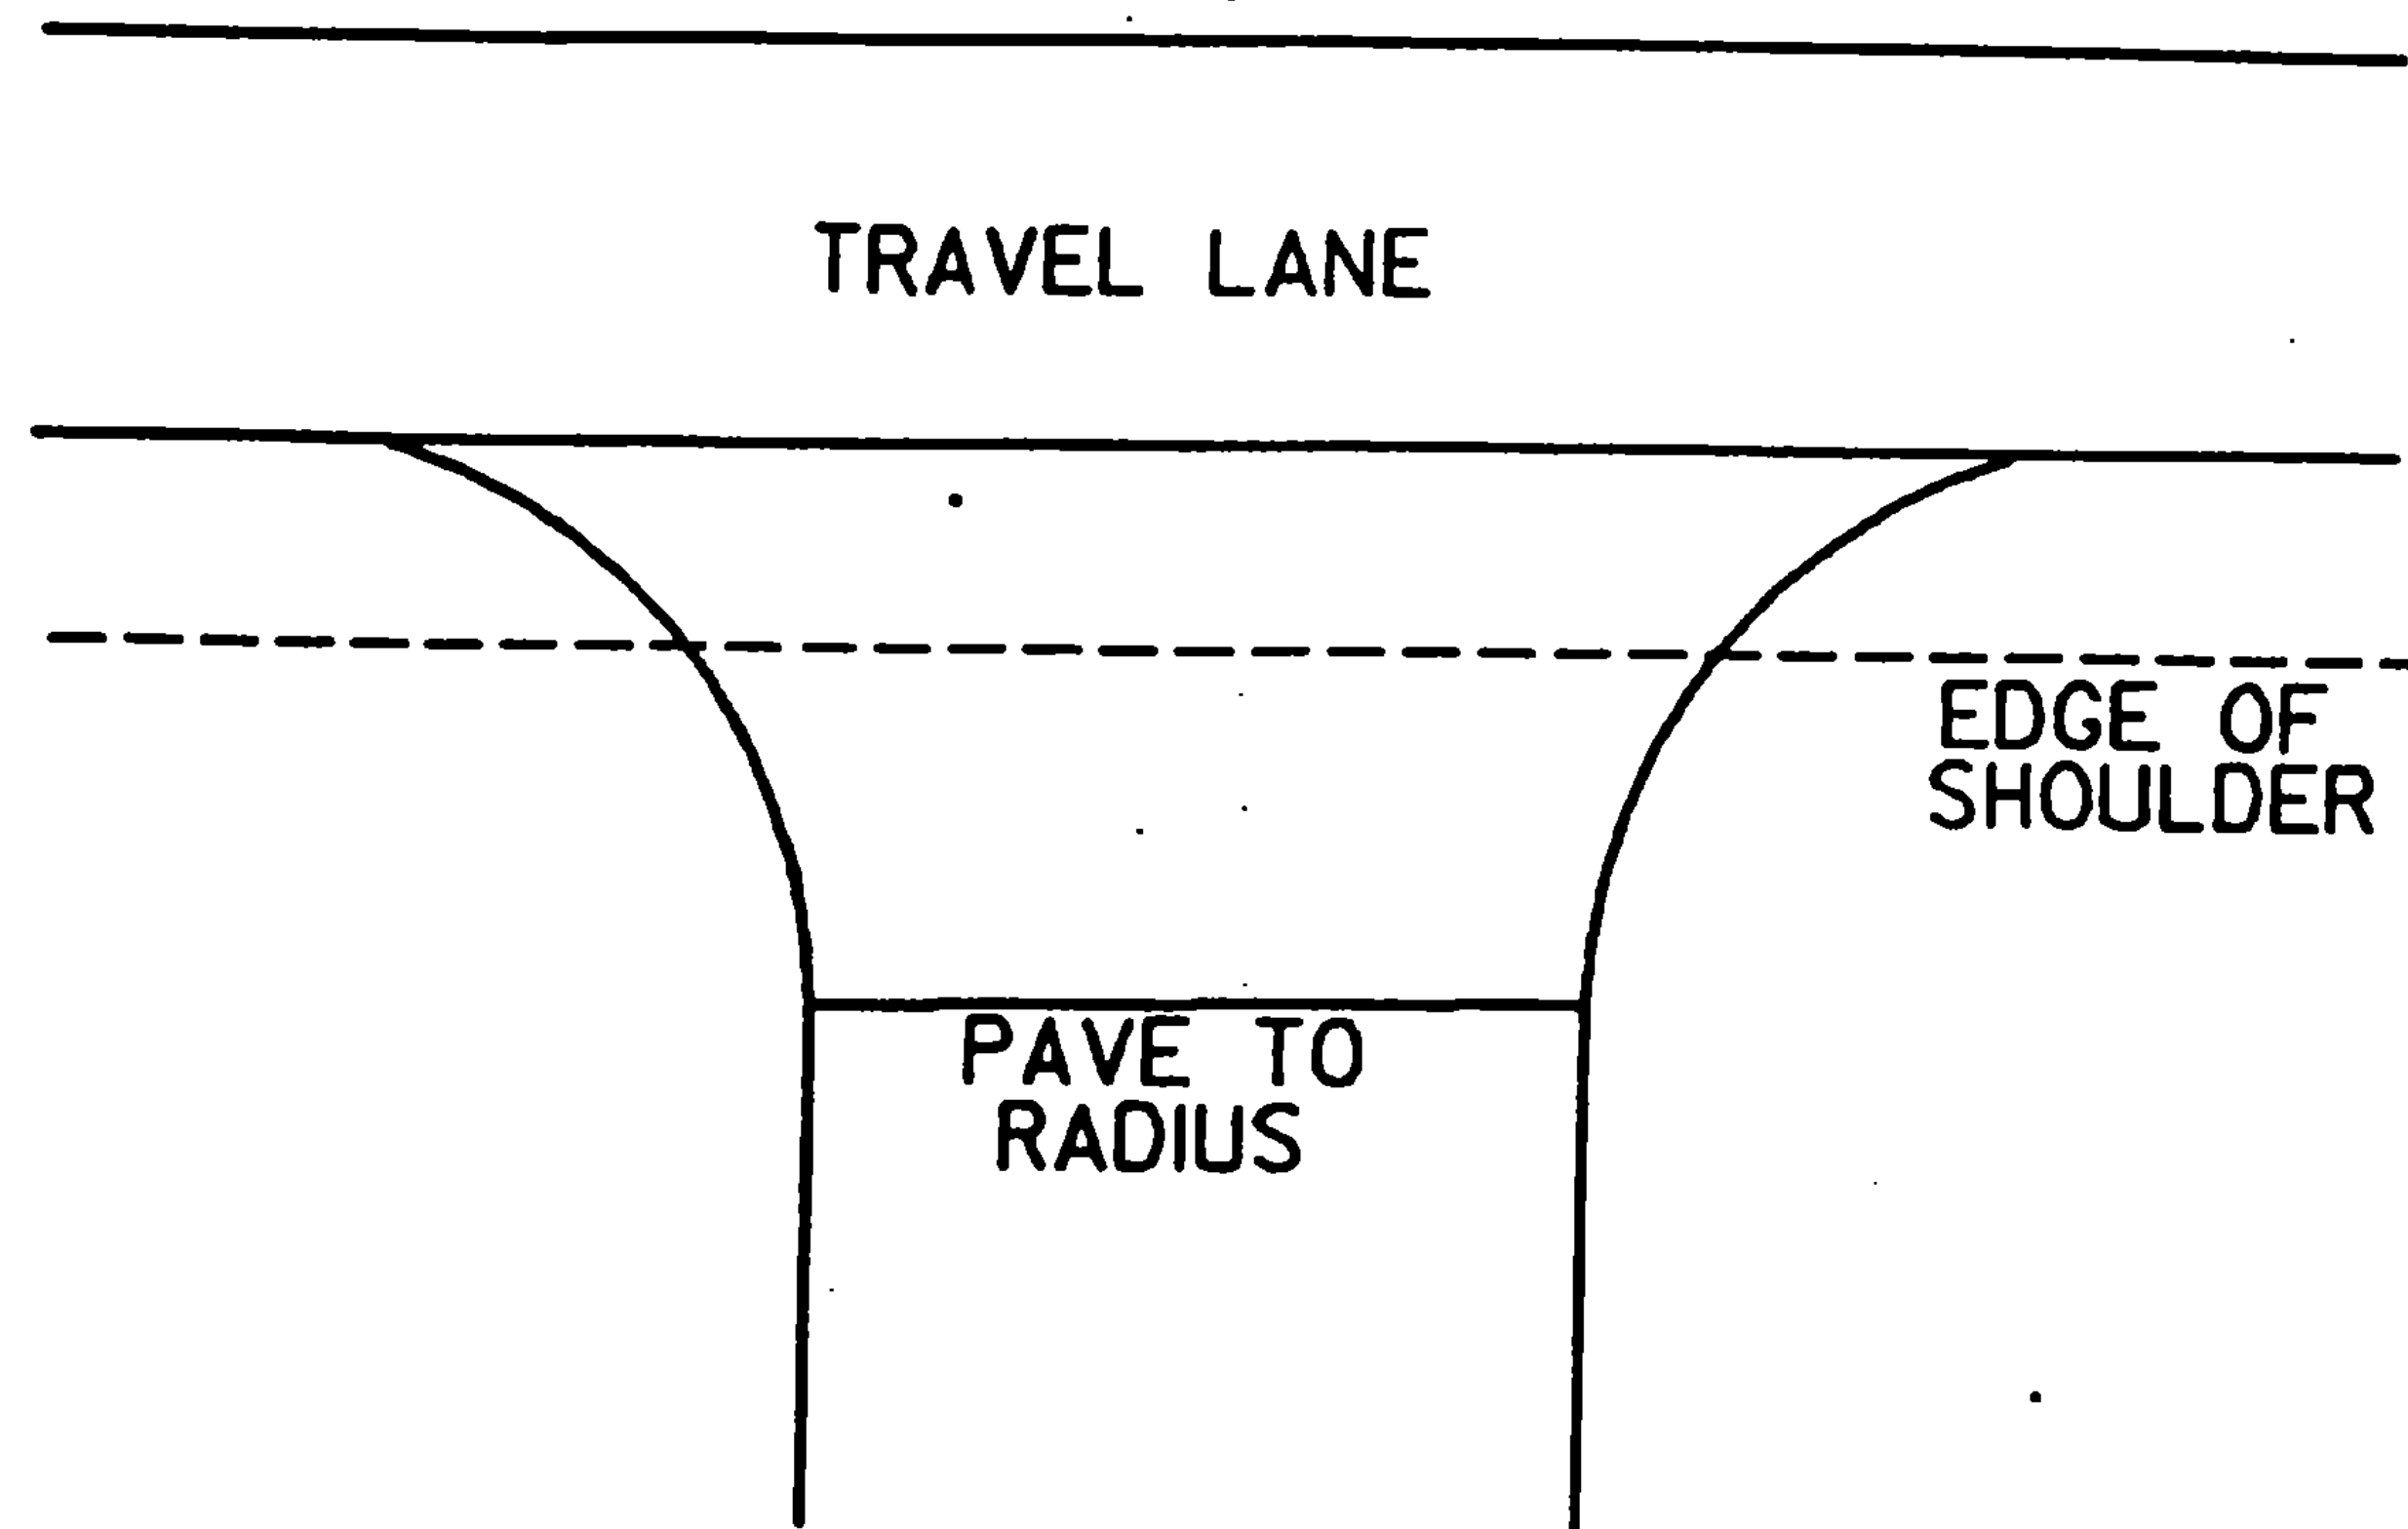

PAVING LIMITS FOR DRIVES

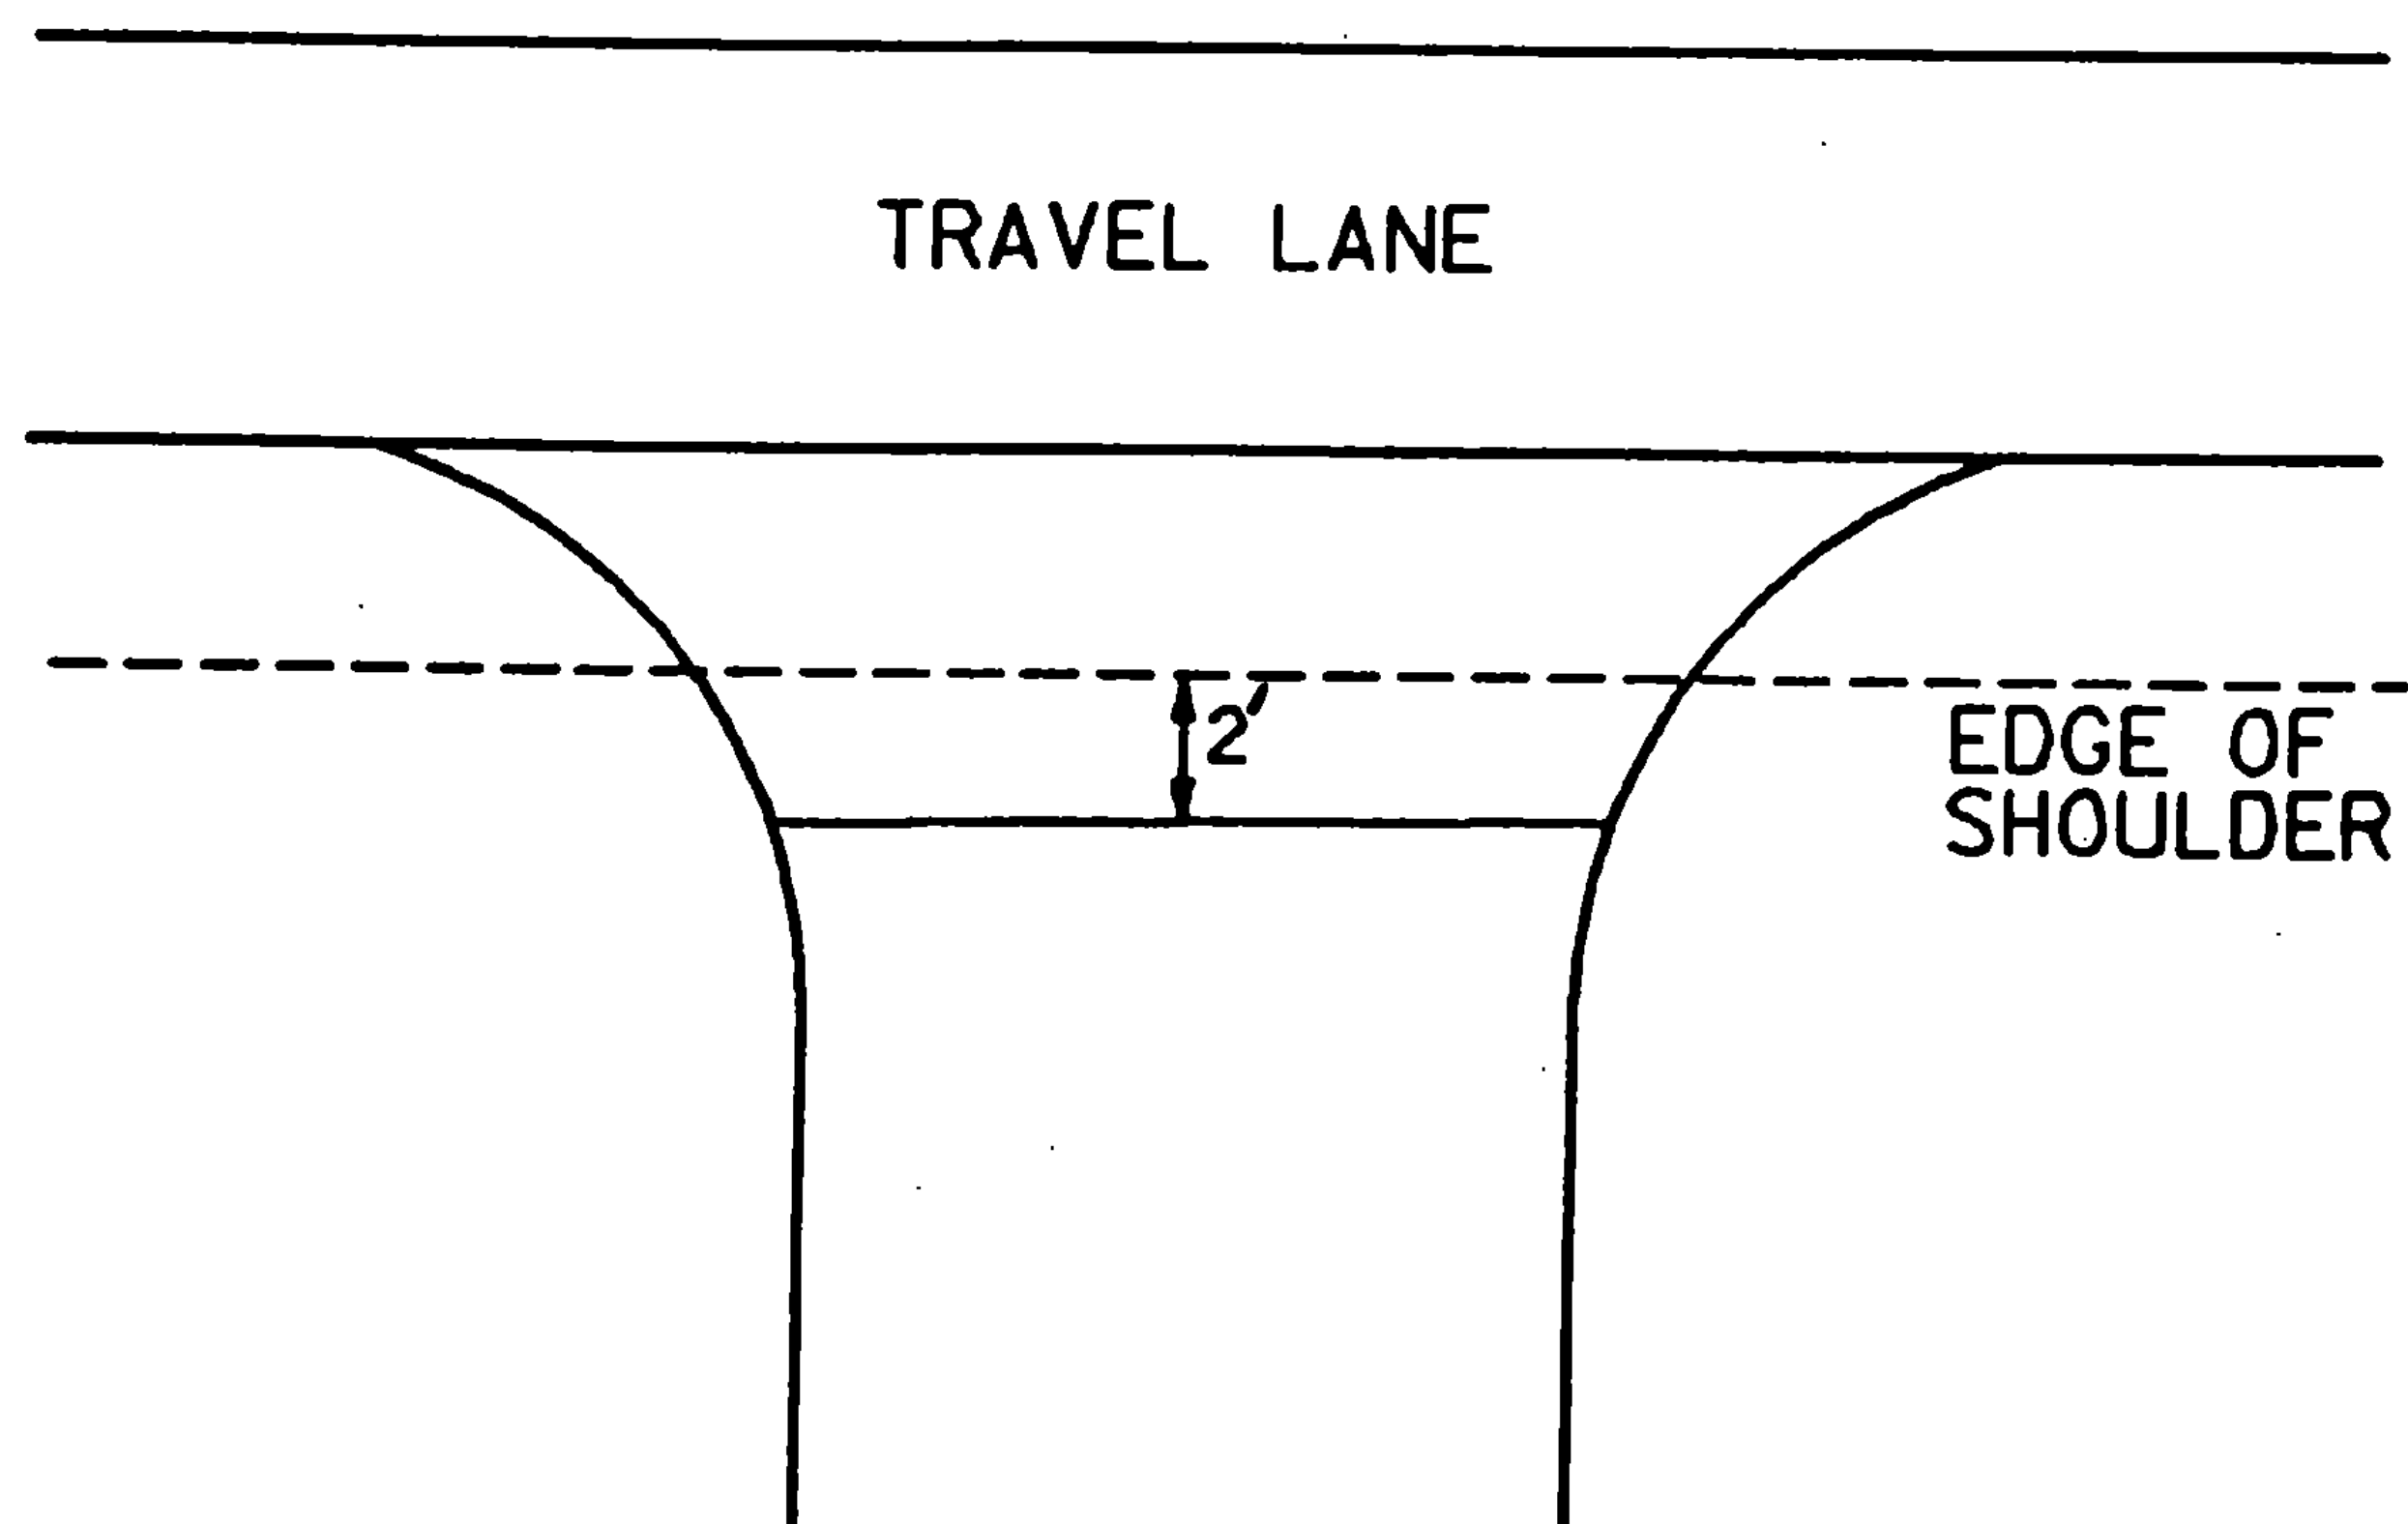

PROJECT Hancock - Granville

NO. HMA 2823

SHEET 5 OF 10 SHEETS

SHEET 17 OF 38 SHEETS