



**MARKING AT INTERSECTING  
SIDE ROAD**

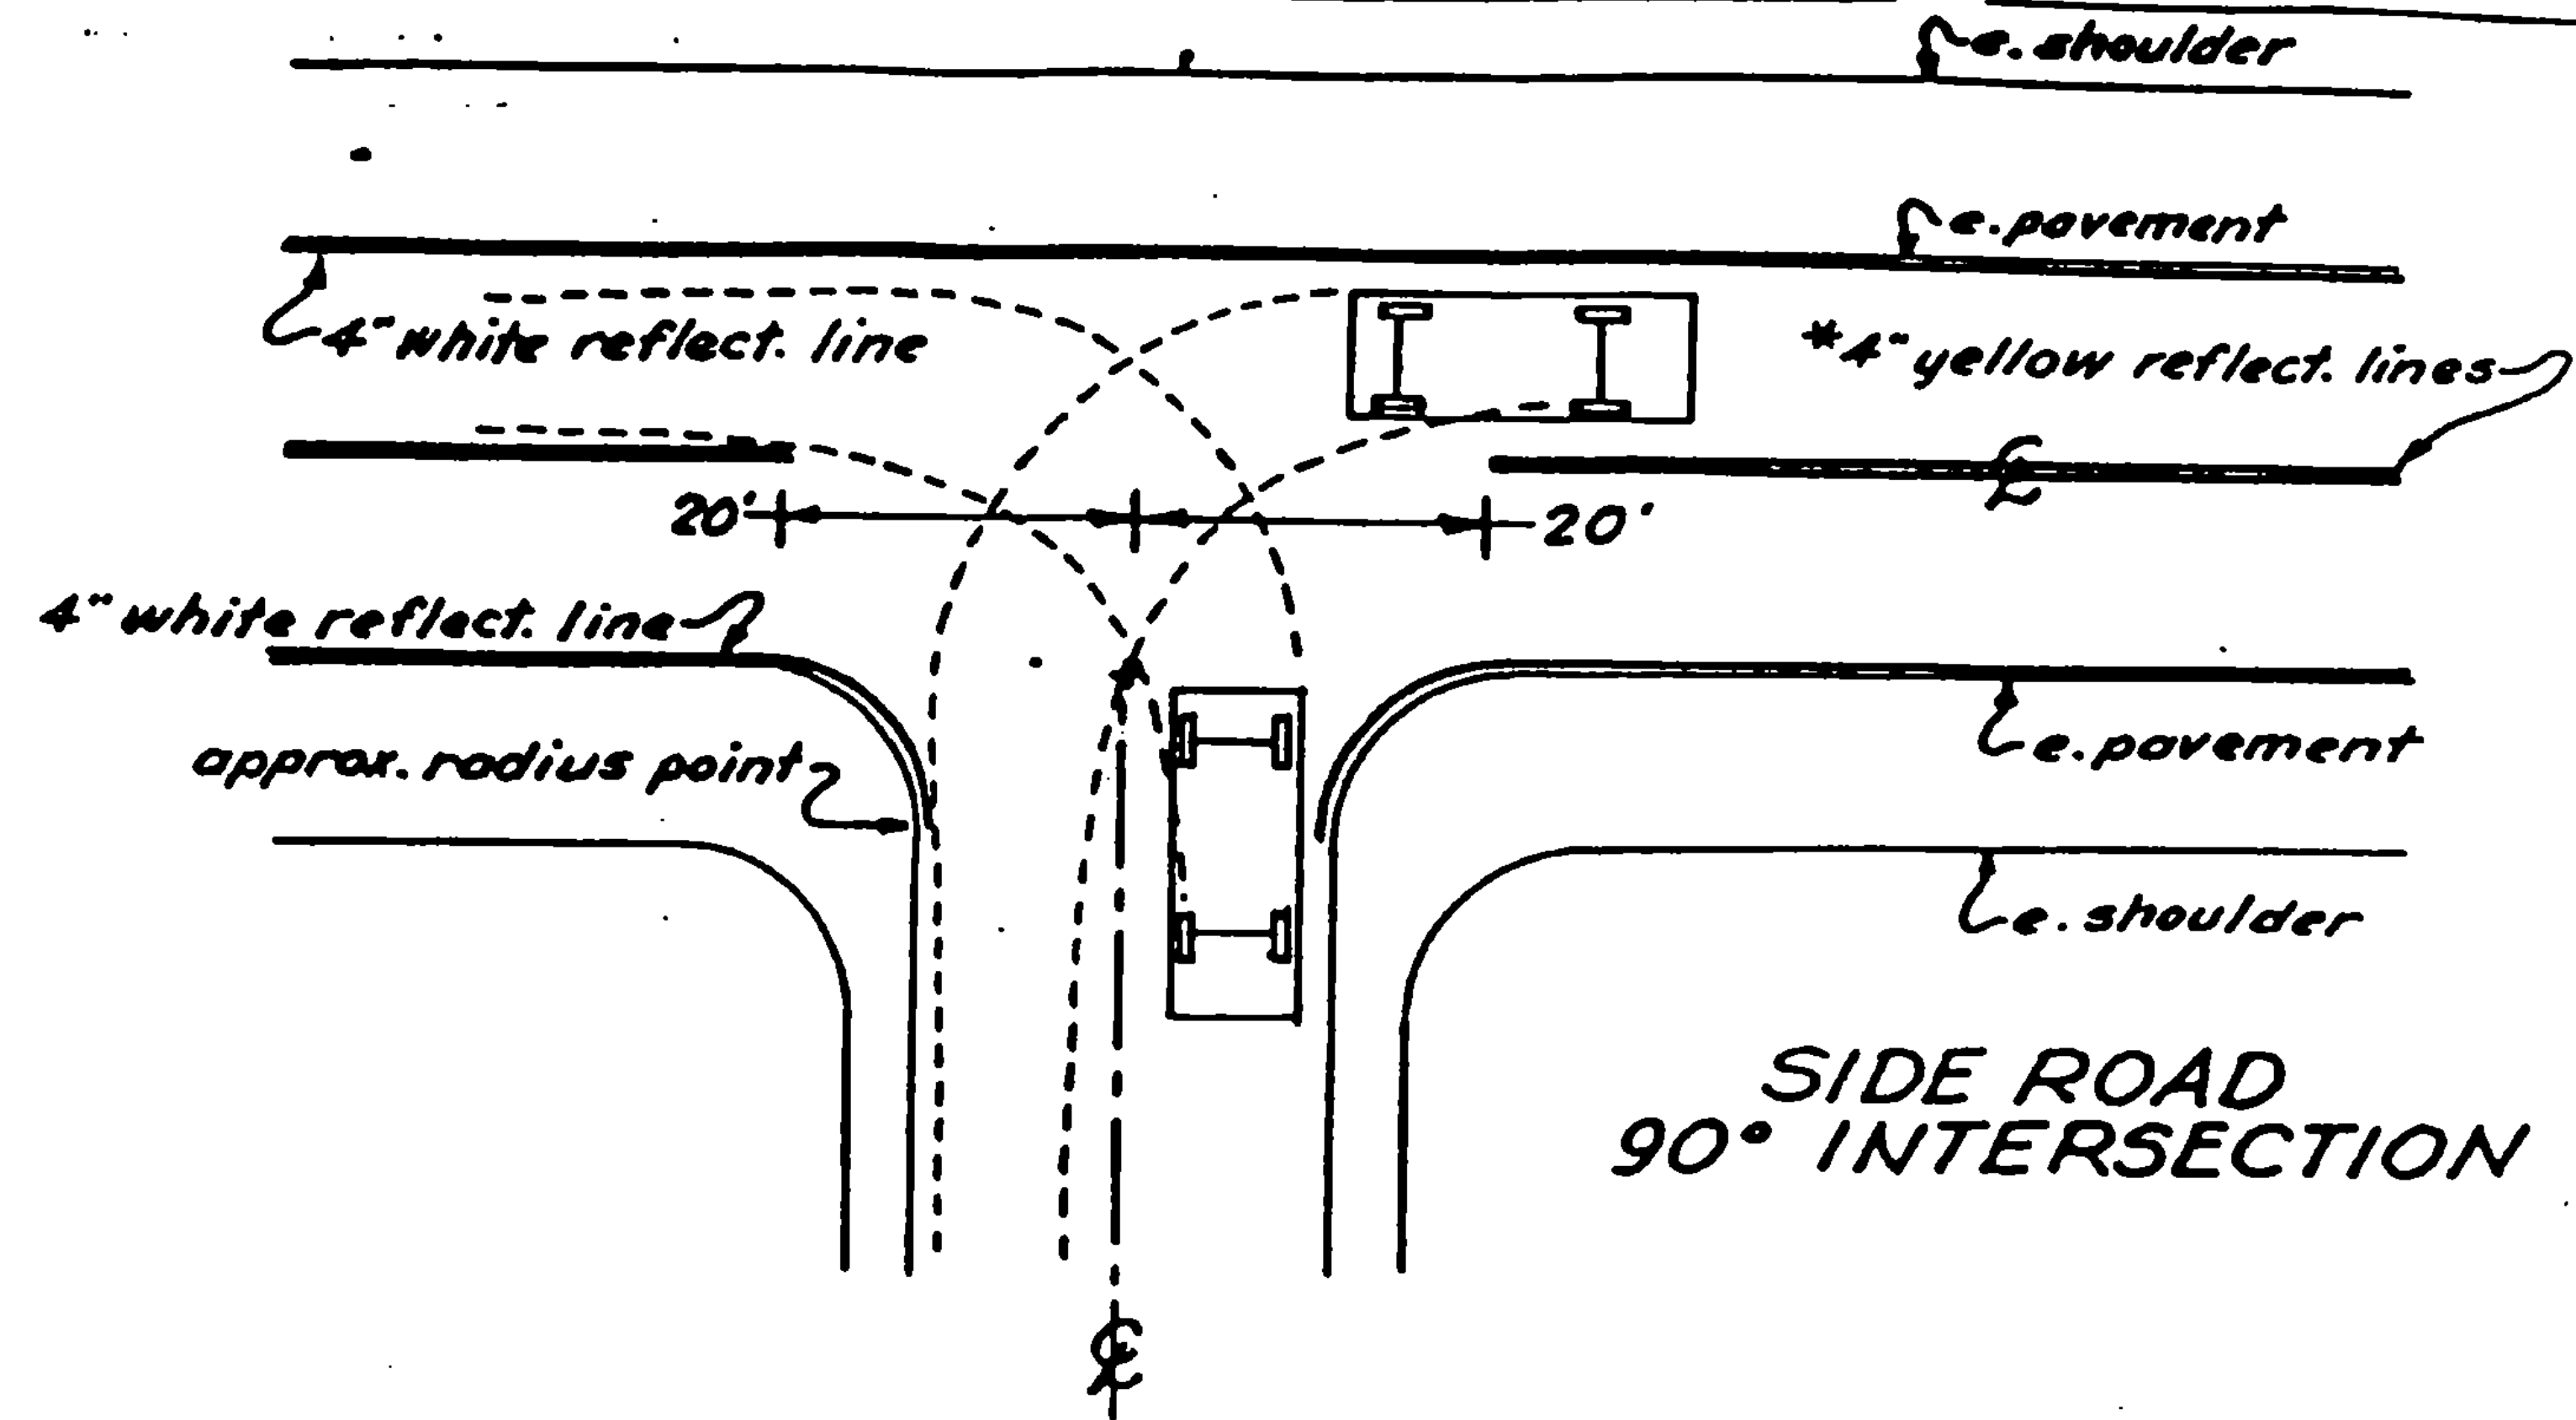

\* Centerline treatment shall consist of a minimum of 400 feet of solid line in advance of the intersection and shall be paired with either a solid or dashed line depending on sight distance availability in the opposing lane.

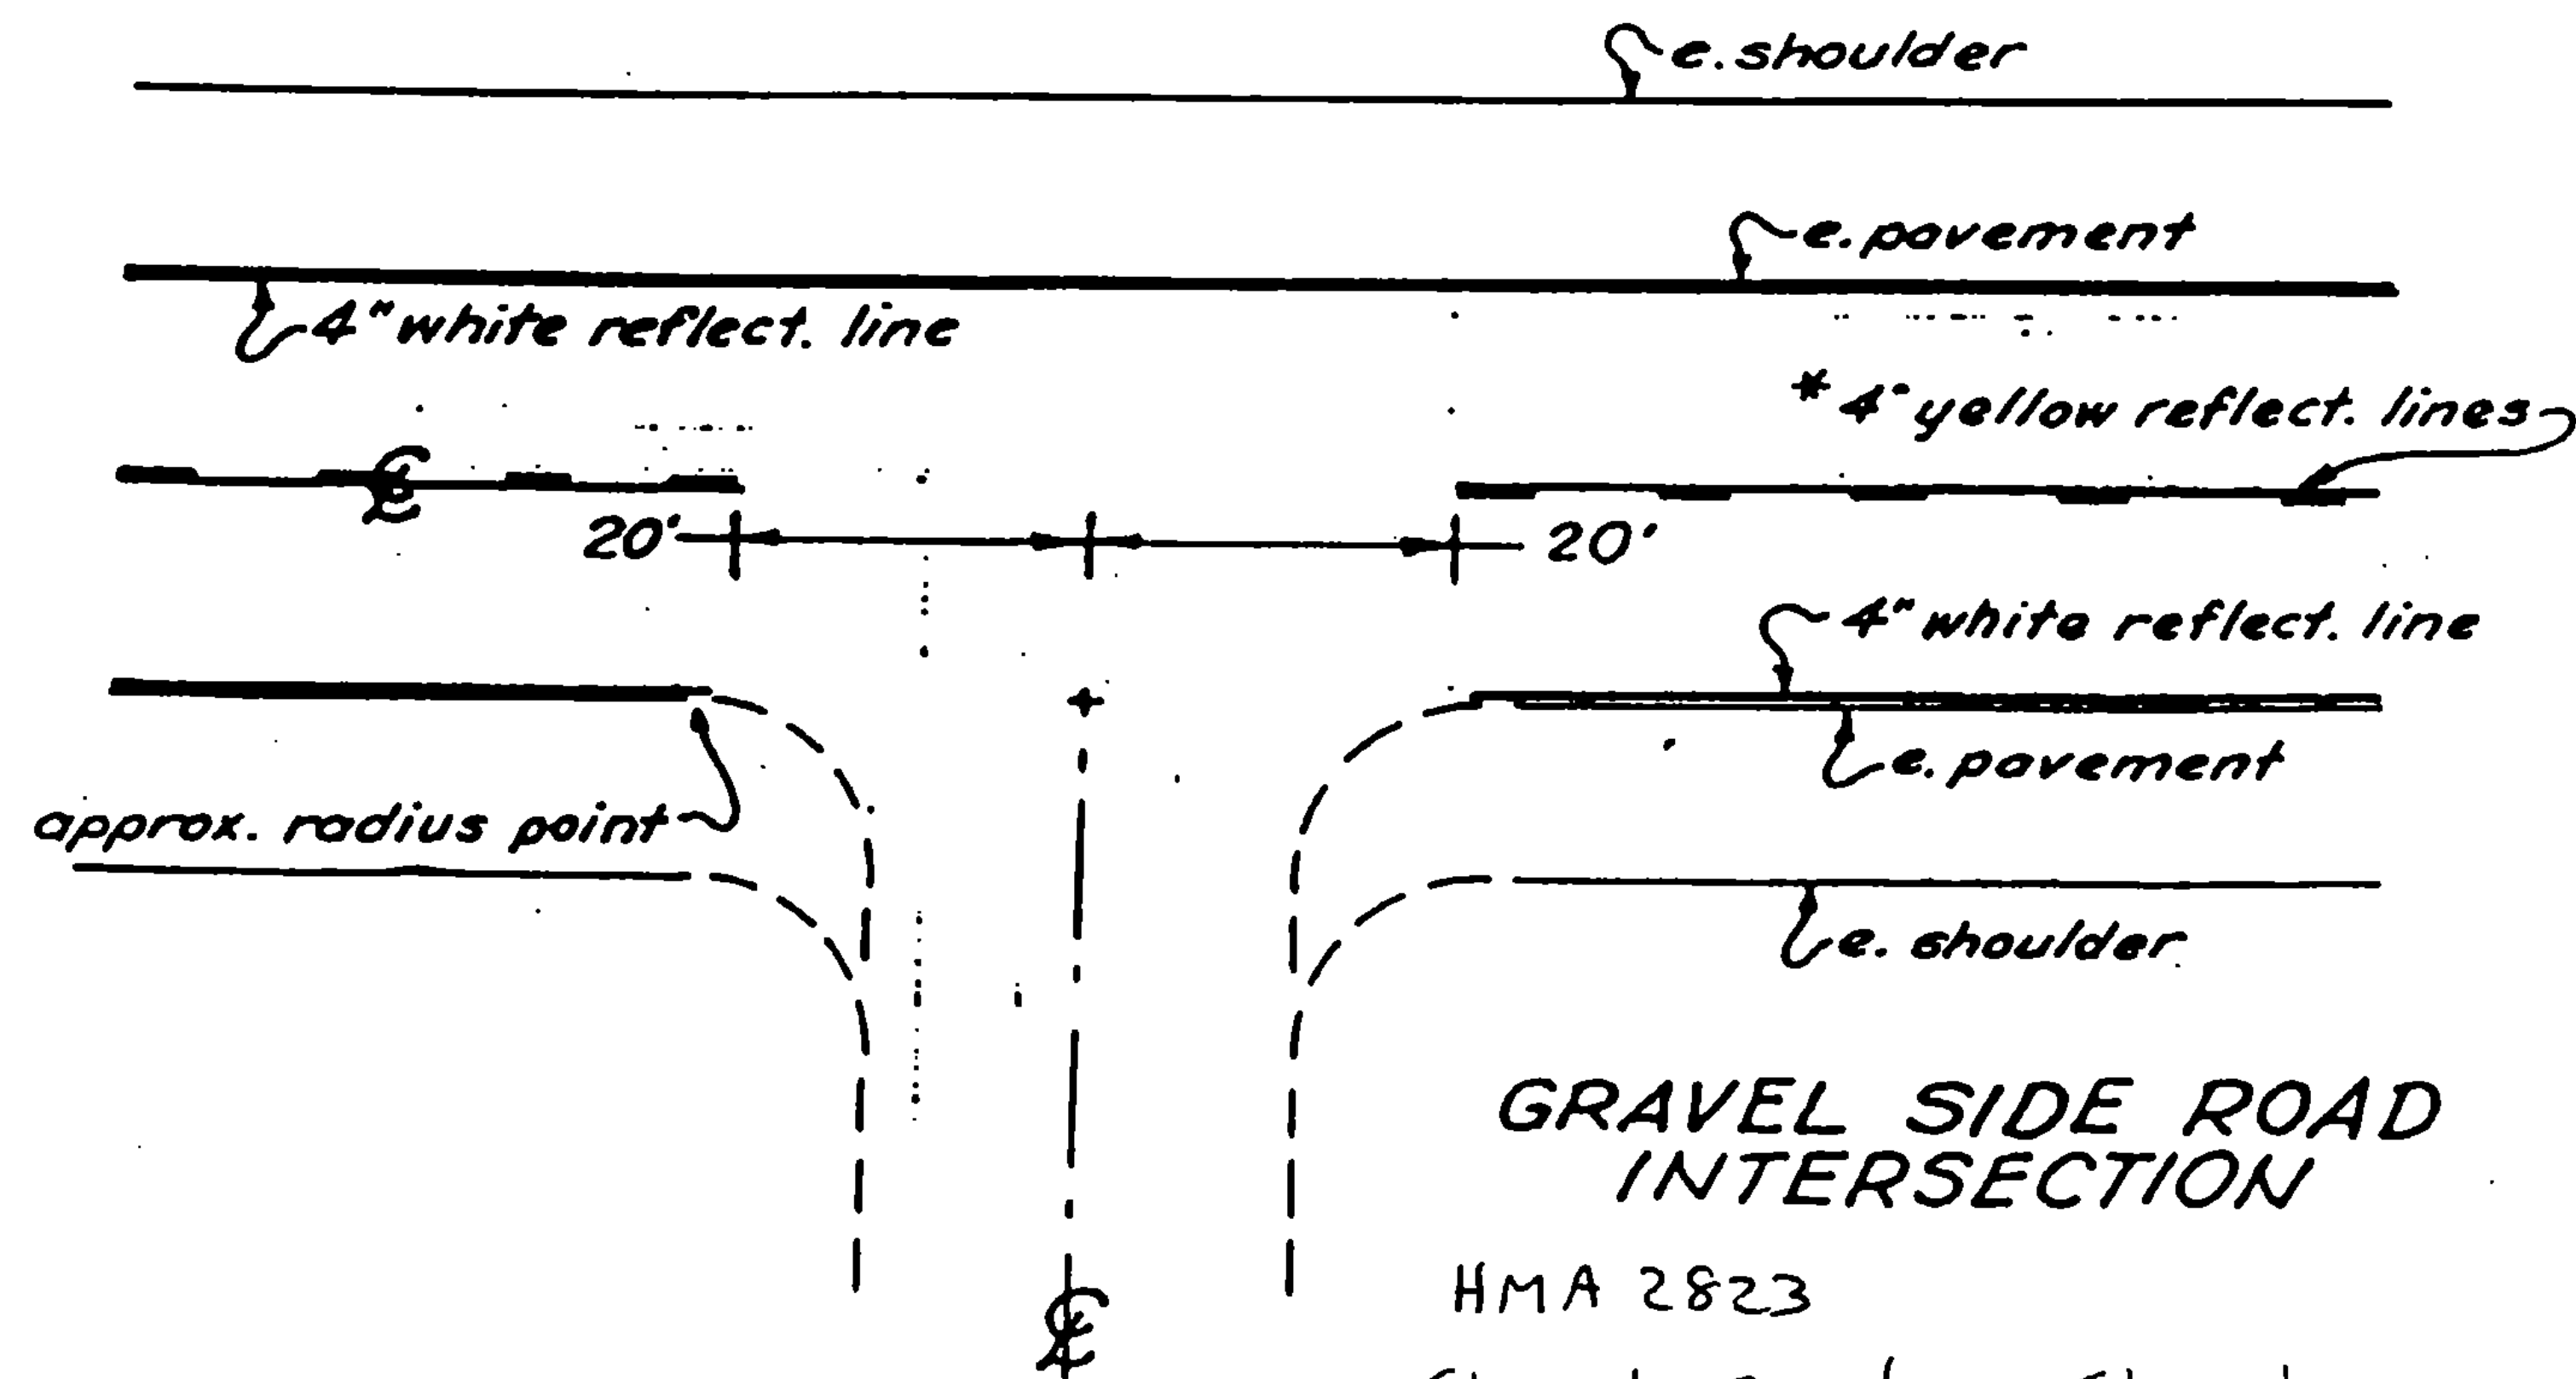

**GRAVEL SIDE ROAD  
INTERSECTION**

HMA 2823

Sheet 8 of 10 Sheets

Sheet 20 of 38 Sheets