


STATE OF VERMONT
 AGENCY OF TRANSPORTATION

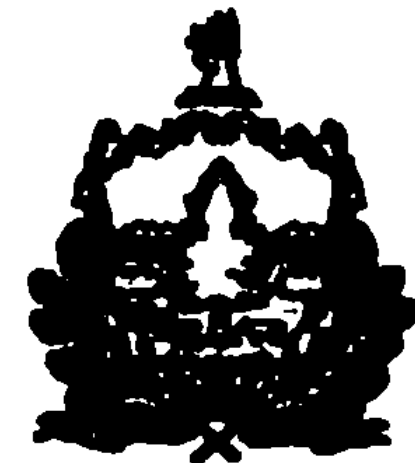


PROPOSED IMPROVEMENT

TOWN OF Rochester - Hancock

COUNTY OF Windsor - Addison

ROUTE NO. VT 100

ROUTE CLASS FAP

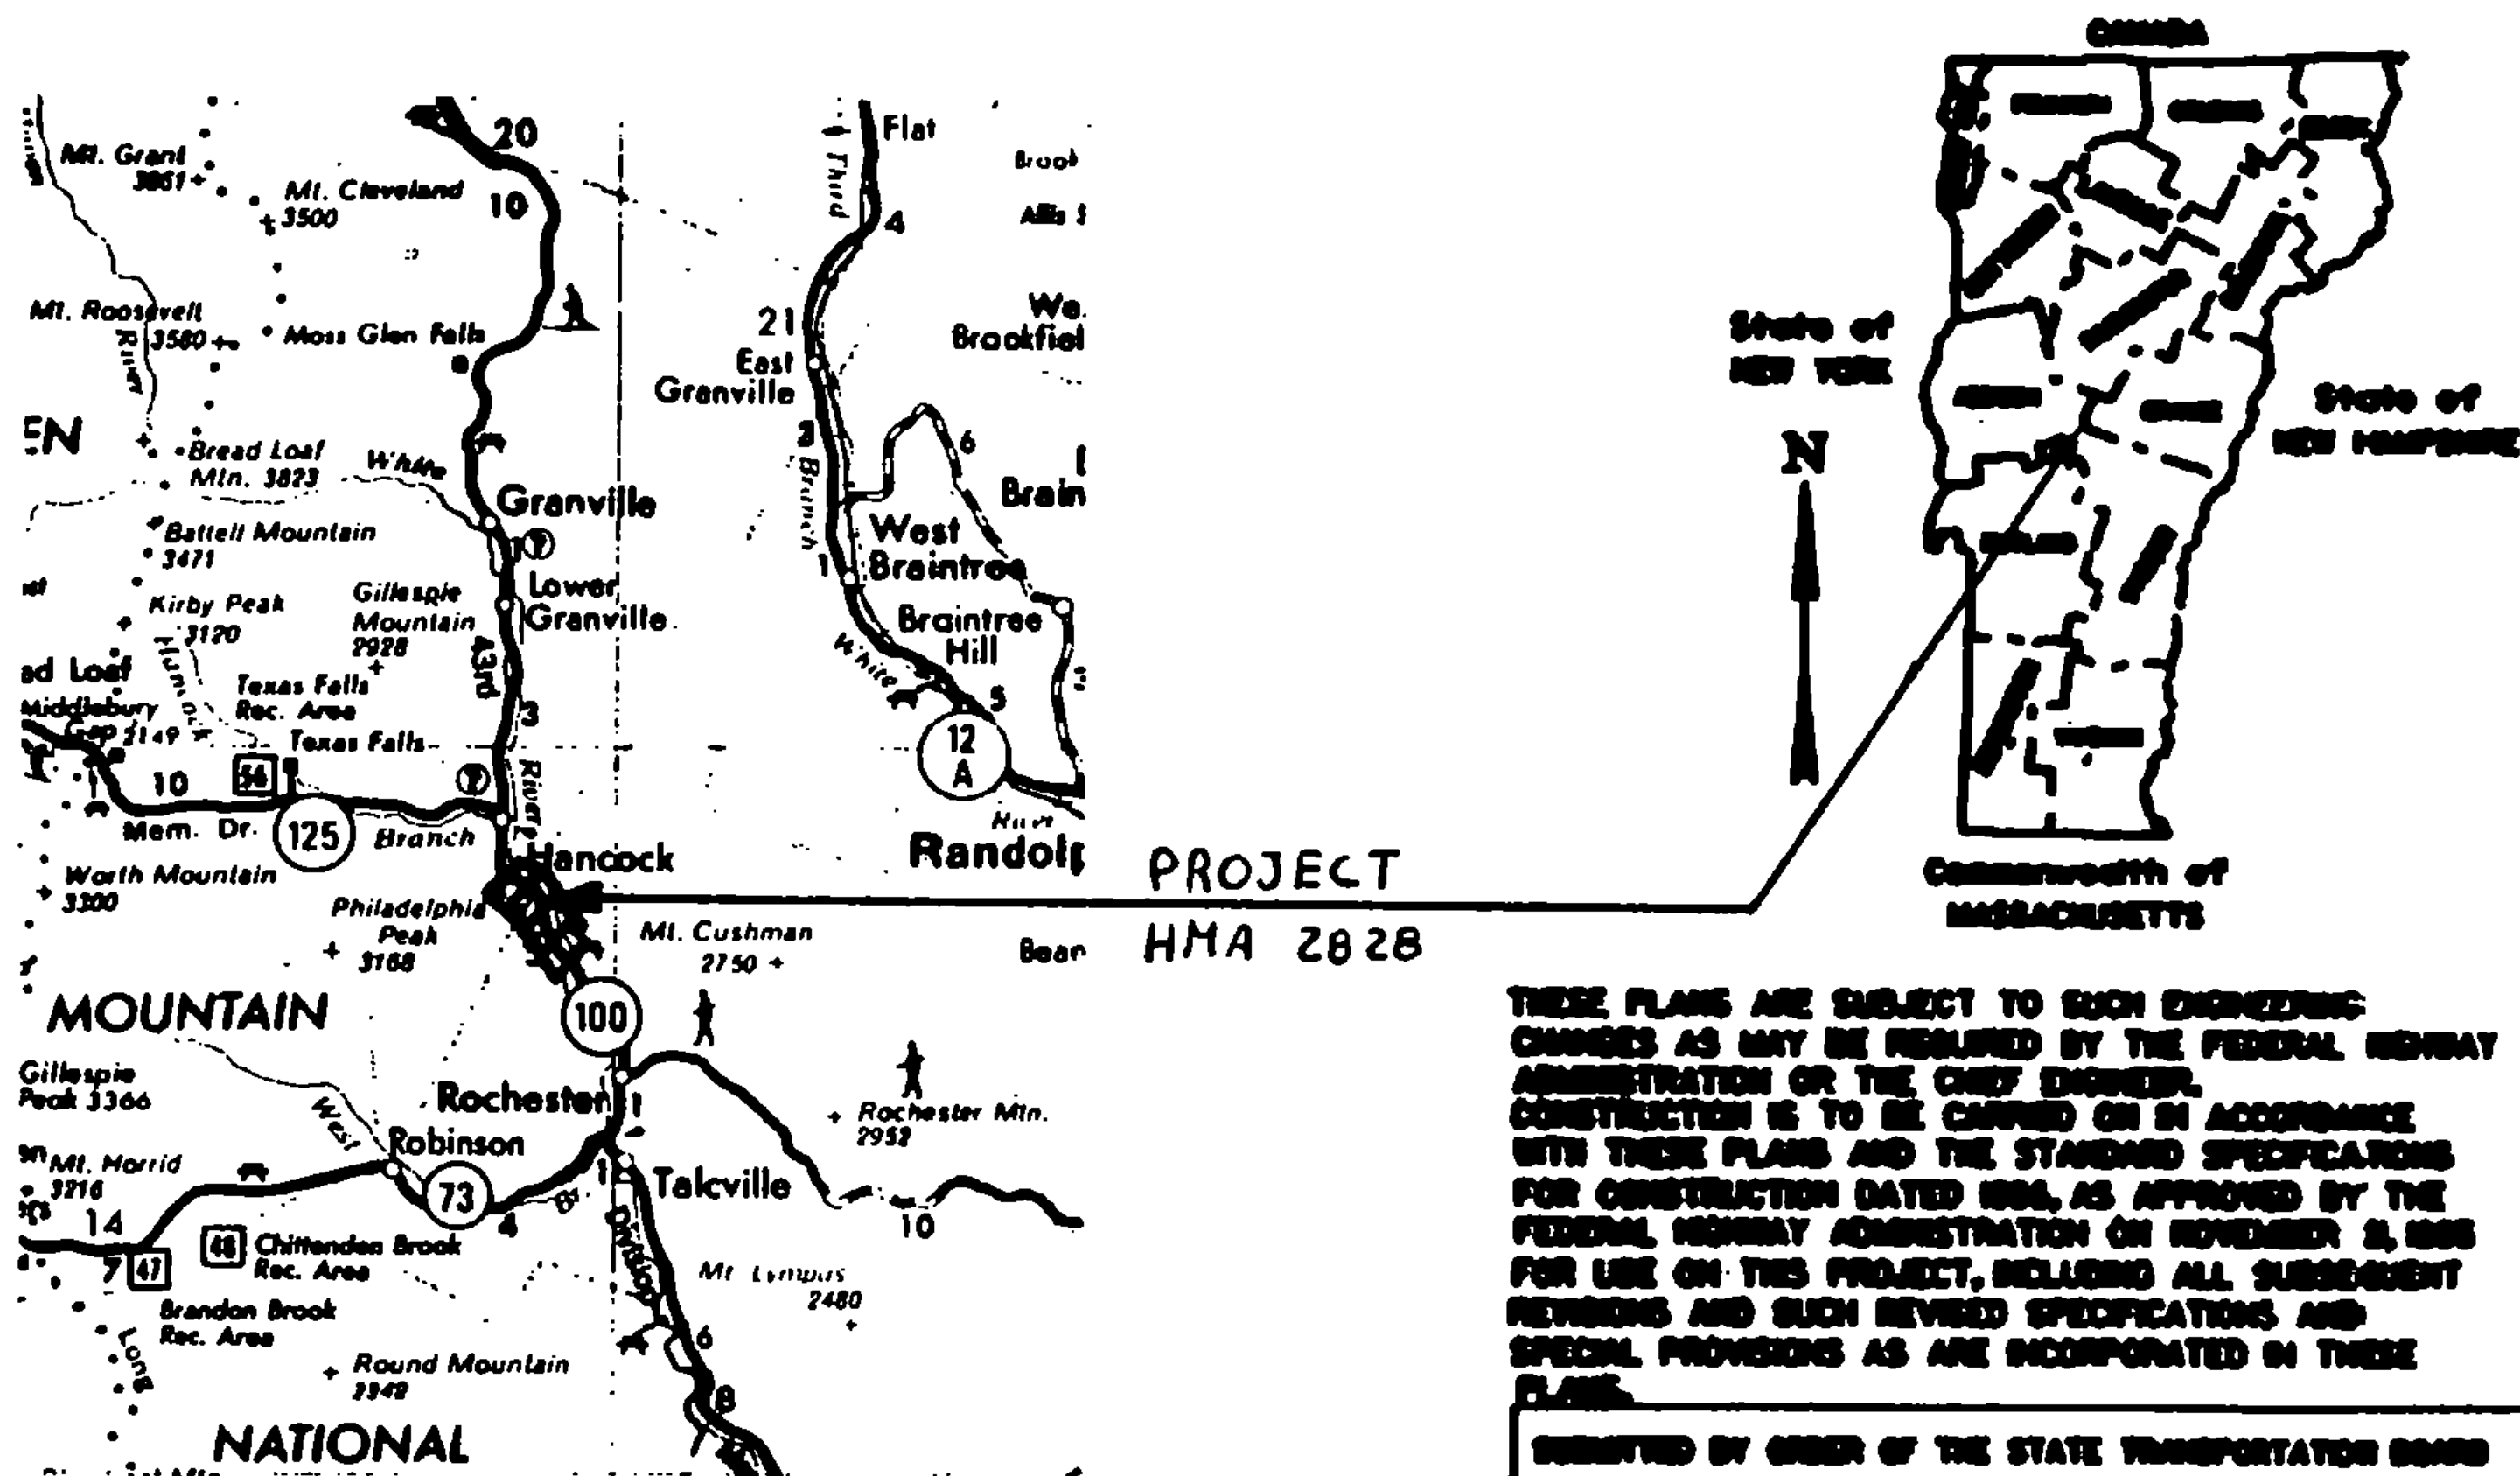

PROJECT
 HMA 2828

THESE PLANS ARE SUBJECT TO SUCH ENGINEERING CHANGES AS MAY BE REQUIRED BY THE FEDERAL HIGHWAY ADMINISTRATION OR THE CHIEF ENGINEER. CONSTRUCTION IS TO BE CARRIED ON IN ACCORDANCE WITH THESE PLANS AND THE STANDARD SPECIFICATIONS FOR CONSTRUCTION DATED 1964, AS APPROVED BY THE FEDERAL HIGHWAY ADMINISTRATION ON NOVEMBER 8, 1965 FOR USE ON THIS PROJECT, INCLUDING ALL SUBSEQUENT REVISIONS AND SUCH REVISED SPECIFICATIONS AND SPECIAL PROVISIONS AS ARE INCORPORATED IN THESE PLANS.

ORDERED BY ORDER OF THE STATE TRANSPORTATION BOARD

APPROVED _____ DATE _____
 CHIEF ENGINEER

DEPARTMENT OF TRANSPORTATION
 FEDERAL HIGHWAY ADMINISTRATION

APPROVED _____ DATE _____
 DIVISION ADMINISTRATOR

Rochester - Hancock
 PROJECT HMA 2828

SHEET 10 OF 10 SHEETS

See Sheet 1 For Index

SHEET 23 OF 38 SHEETS