


DESCRIPTION AND LOCATION

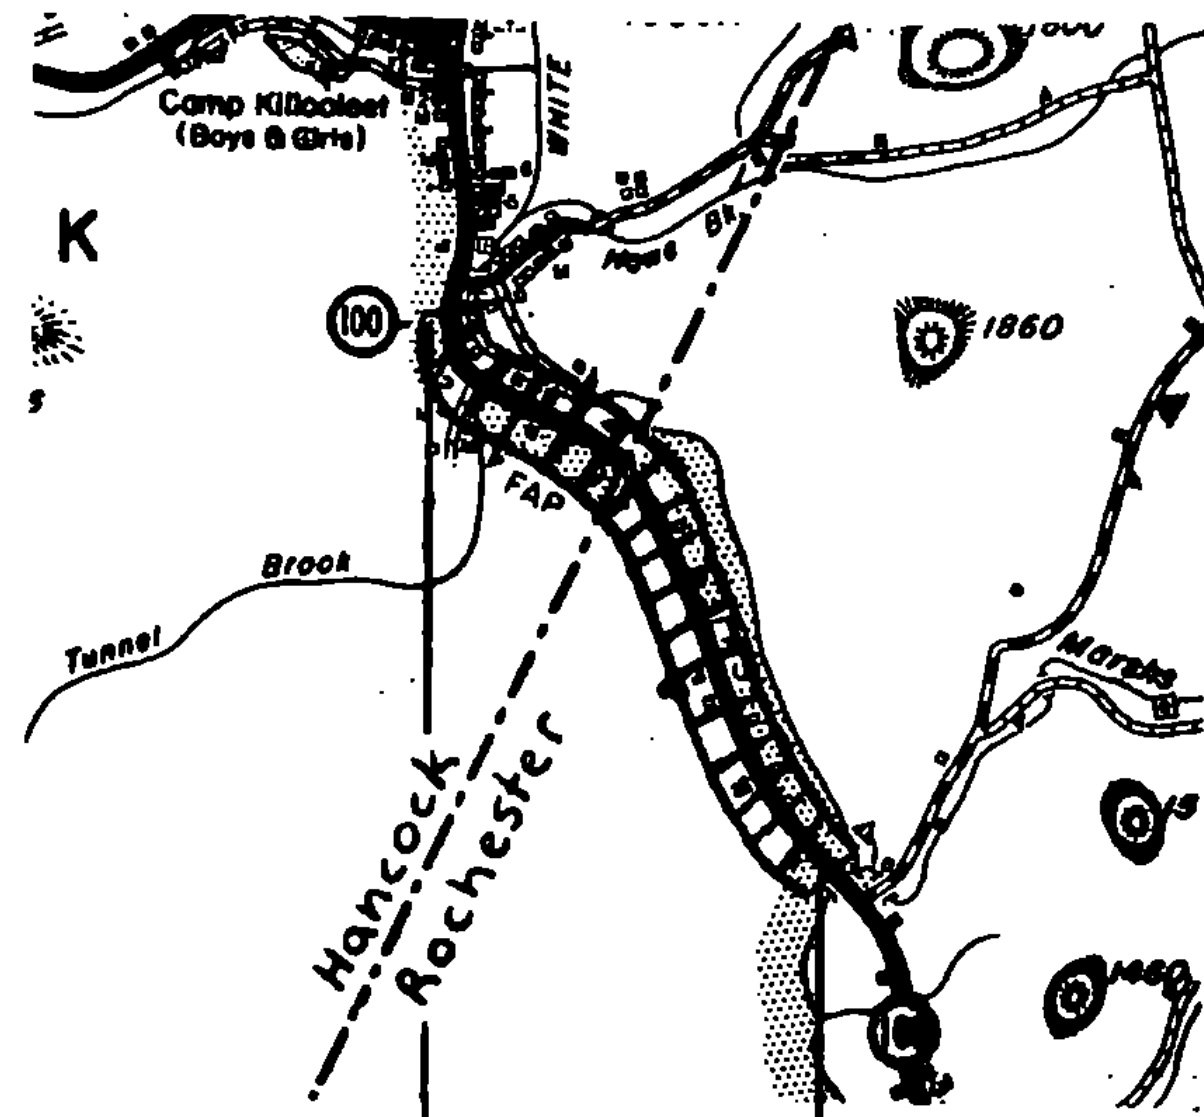

Scale: 1" = 1 mile

End Project HMA 2828
MM 0.650

Begin Project HMA 2828
MM 7.273

Beginning at a point on UT 100, 1.080 miles southerly of the Rochester-Hancock town line and extending northerly 1.730 miles to MM 0.650 in the town of Hancock

Work consists of resurfacing of the highway, including shoulders, and new pavement markings.

1986 ADT 2410

Length Of Project

1.730 miles

9134 feet

PROJECT Rochester-Hancock

NO. HMA 2828

SHEET 3 OF 10 SHEETS

SHEET 25 OF 38 SHEETS