


TYPICAL SECTIONS & DESIGN DATA

ITEM 406.25 BITUMINOUS CONCRETE PAVEMENT
LEVELING COURSE TYPE IV (VARIES FROM 300/350 TONS/MILE)
1/4" WEARING COURSE TYPE III (±1/4")
AS DIRECTED BY THE ENGINEER

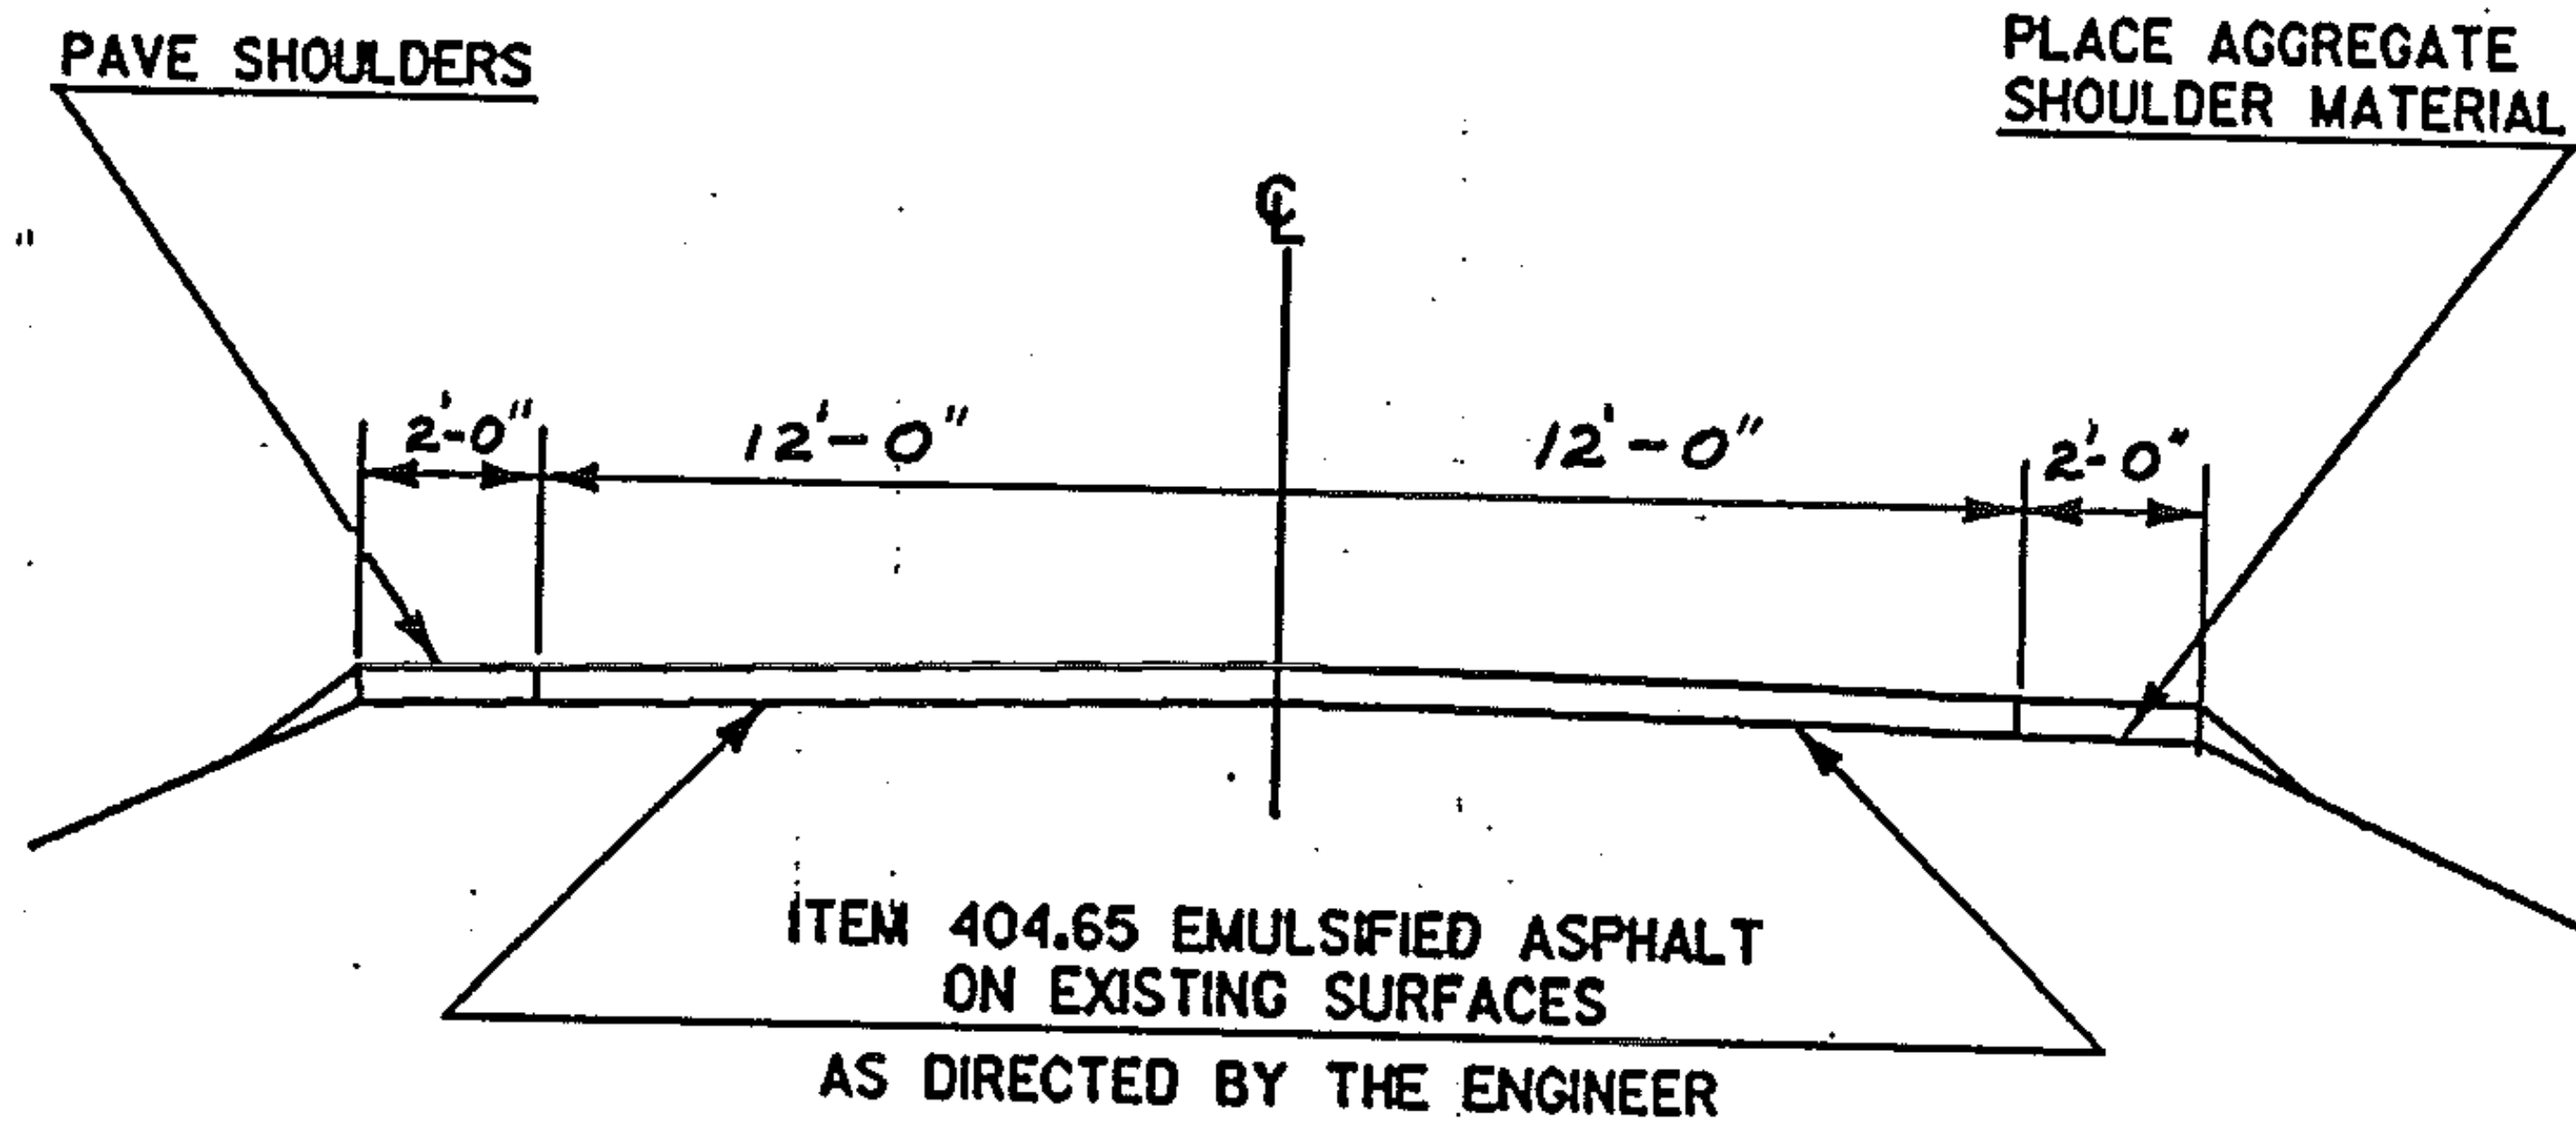

AVERAGE WIDTH OF ROADWAY IS 24 FT.

AVERAGE WIDTH OF SHOULDER IS 2 FT. HOWEVER IT VARIES THROUGHOUT THE PROJECT.

IF GRAVEL OR DETERIORATED SHOULDERS EXIST REFER TO TYPICAL ON SHEET 8 OF 34 AS DIRECTED BY THE ENGINEER

GENERAL NOTE: RESURFACE EXISTING BITUMINOUS CONCRETE SURFACE WHICH INCLUDES TRUCK CLIMBING LANES AND ACCELERATION LANES.

PROJECT SHAFTSBURY - ARLINGTON

NO. HMA 2824

SHEET 7 OF 34 SHEETS