



PAVING LIMITS FOR DRIVES & TOWN ROADS

PAVING LIMITS FOR TOWN ROADS

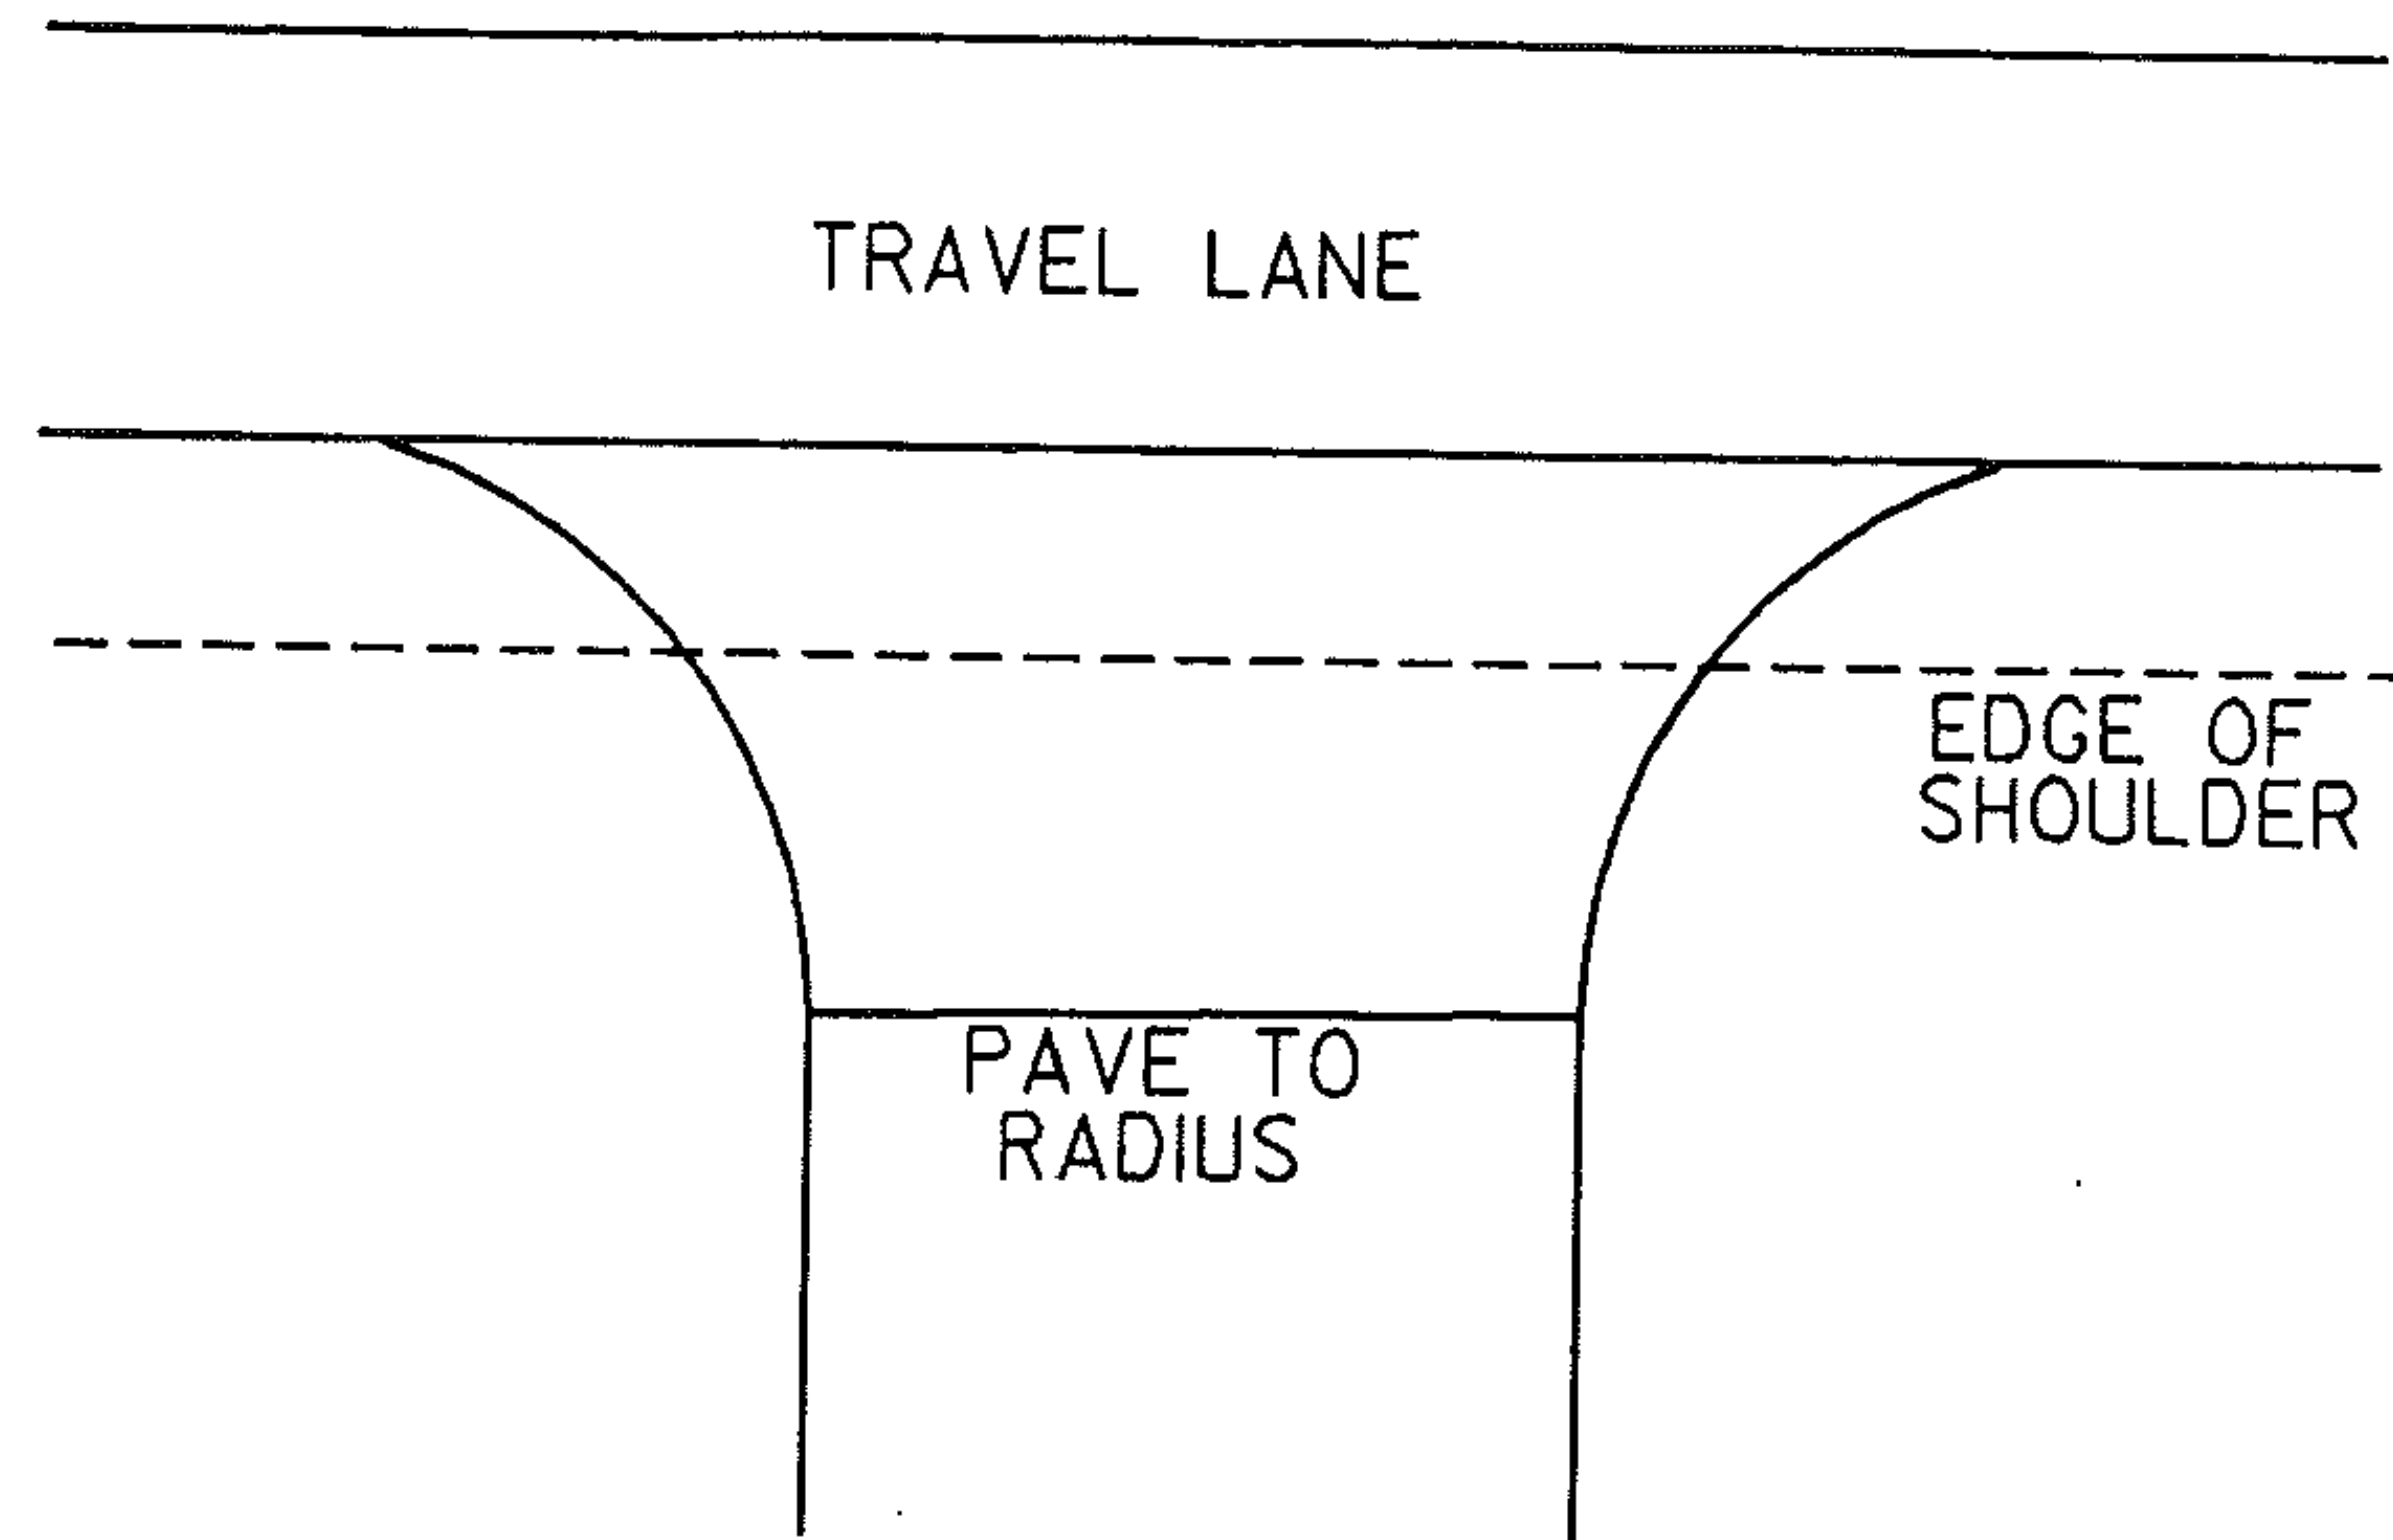

PAVING LIMITS FOR DRIVES

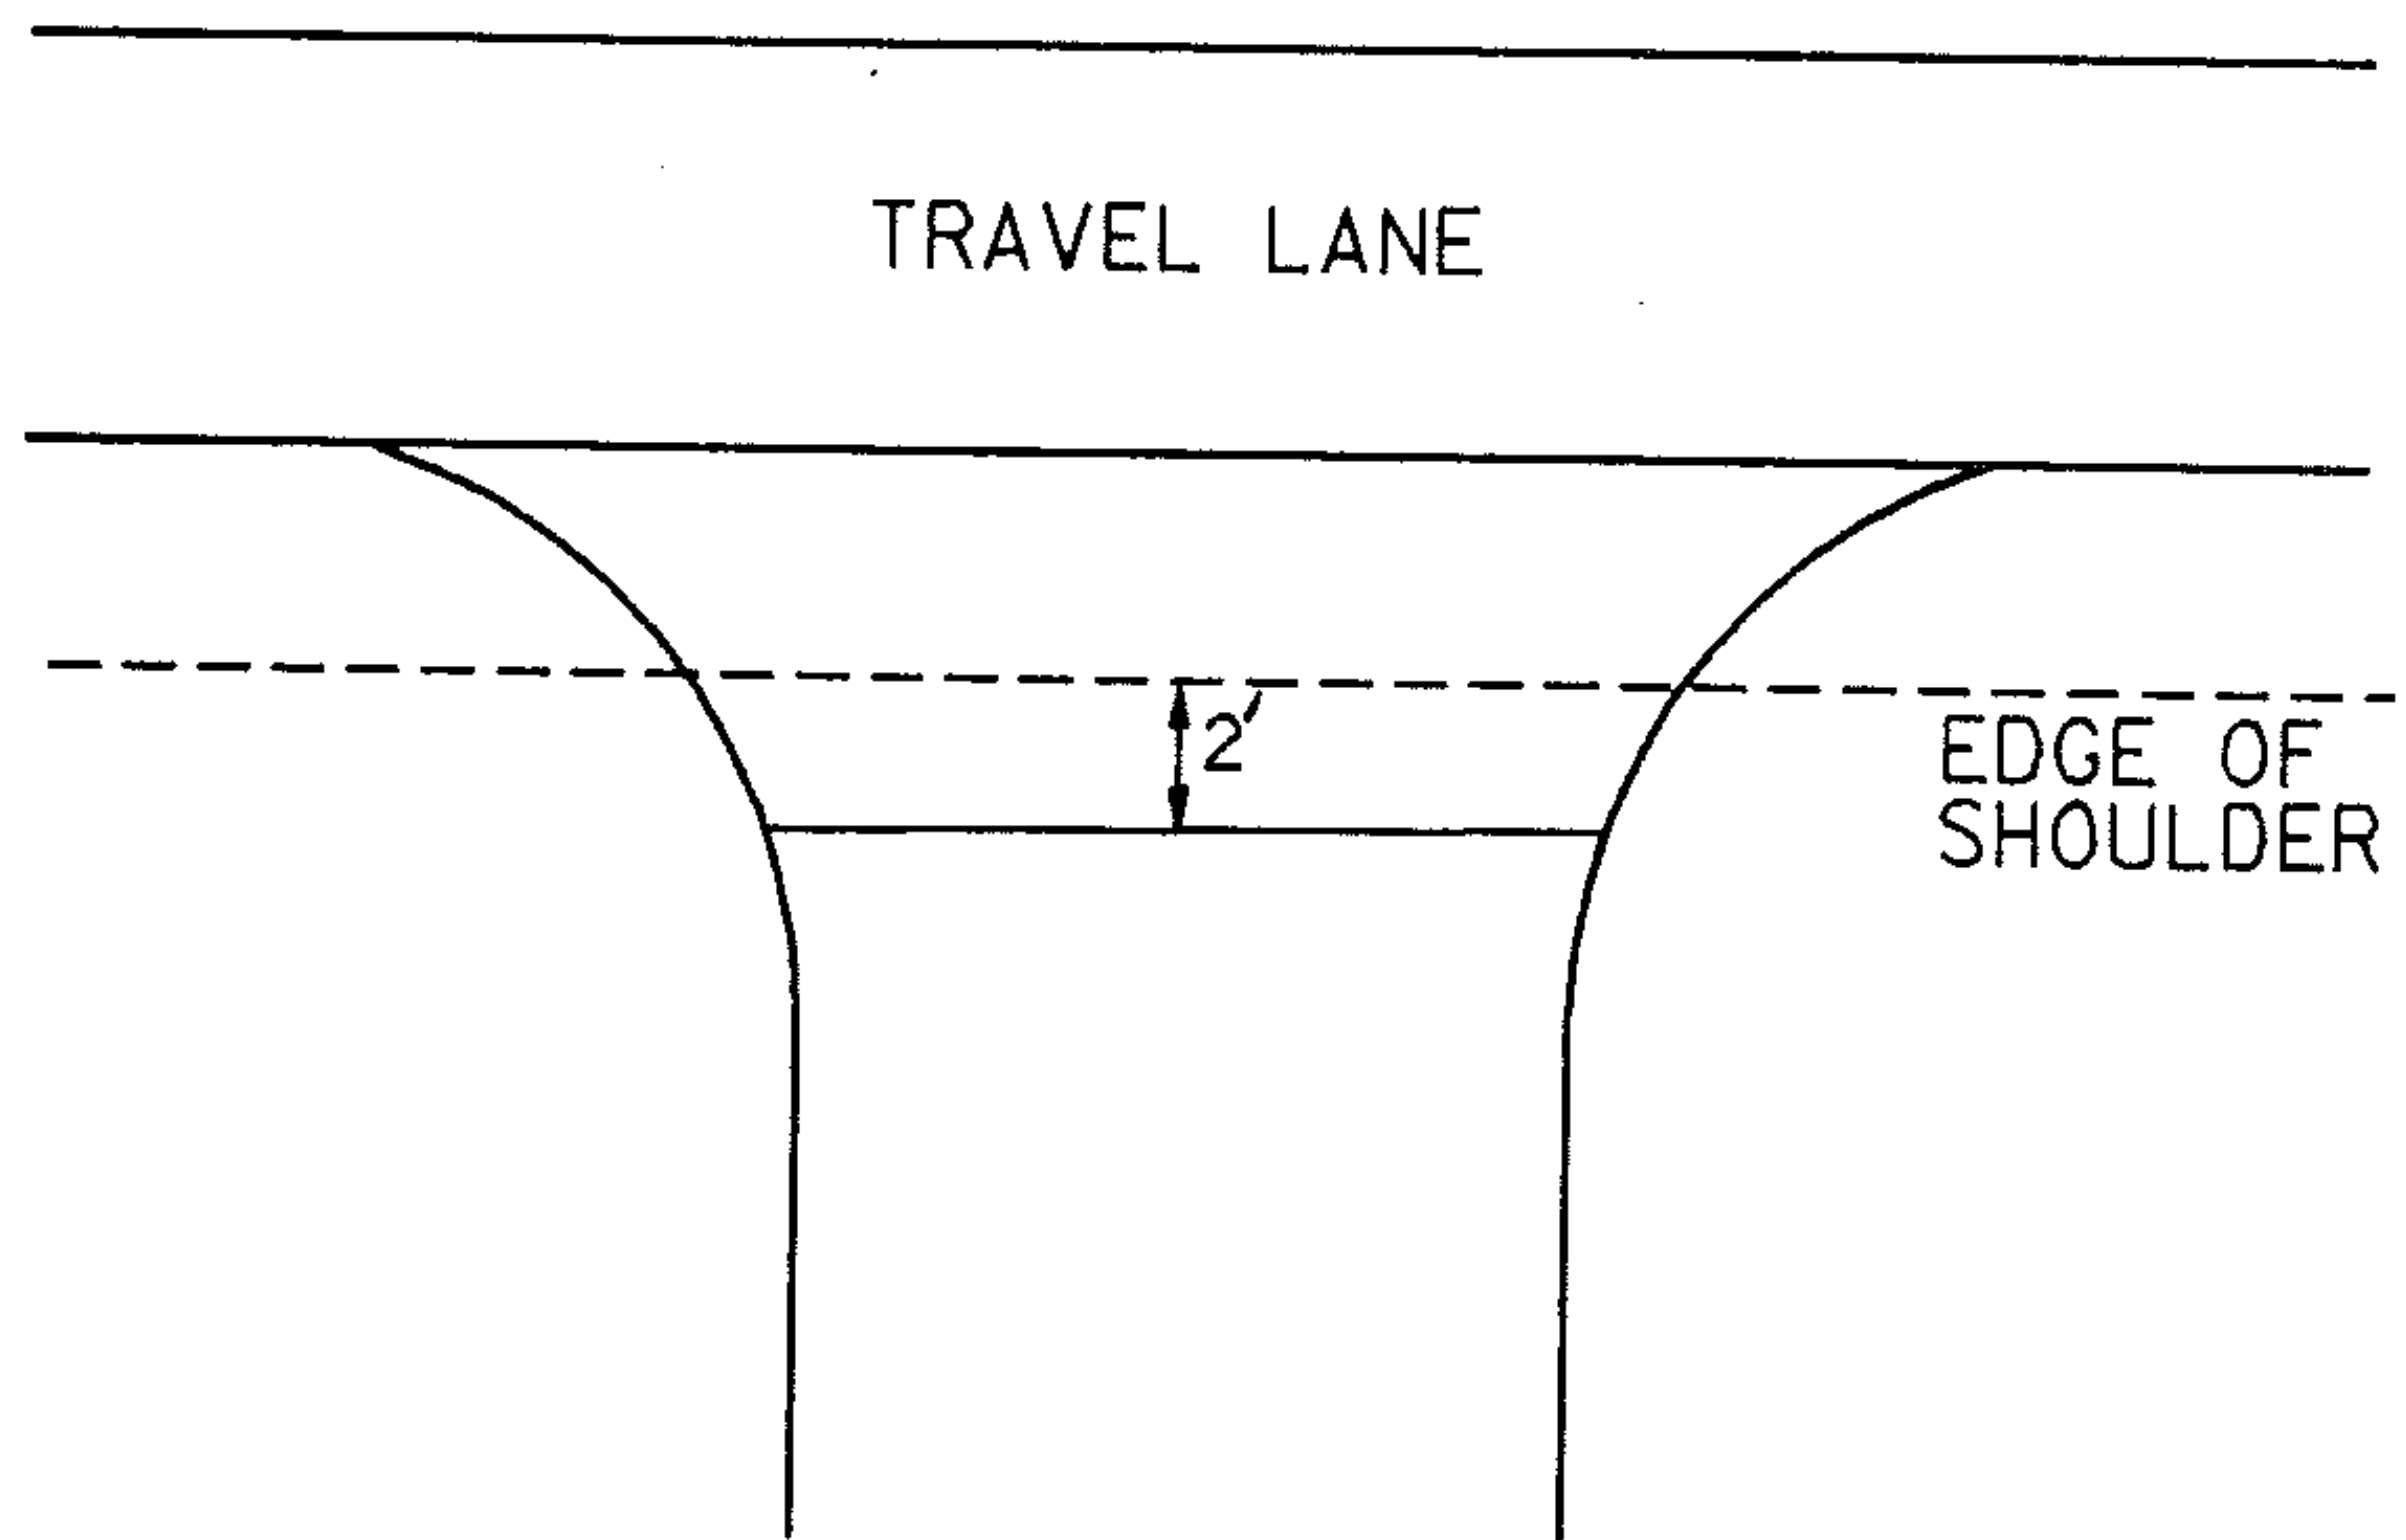

PROJECT SHAFTSBURY-ARLINGTON

NO. HMA 2024

SHEET 9 OF 34 SHEETS