


DESCRIPTION AND LOCATION

PROJECT LENGTH: 0.102 MILE , 538.56 FEET
1986 A.D.T. : 2160

BEGINNING IN THE TOWN OF ARLINGTON ON VT. 313 AT M.M. 6.532 AND EXTENDING EASTERLY 0.102 MILE TO M.M. 6.634. RESURFACING OF THE HIGHWAY AND ITS APPROACHES, NEW PAVEMENT MARKINGS.

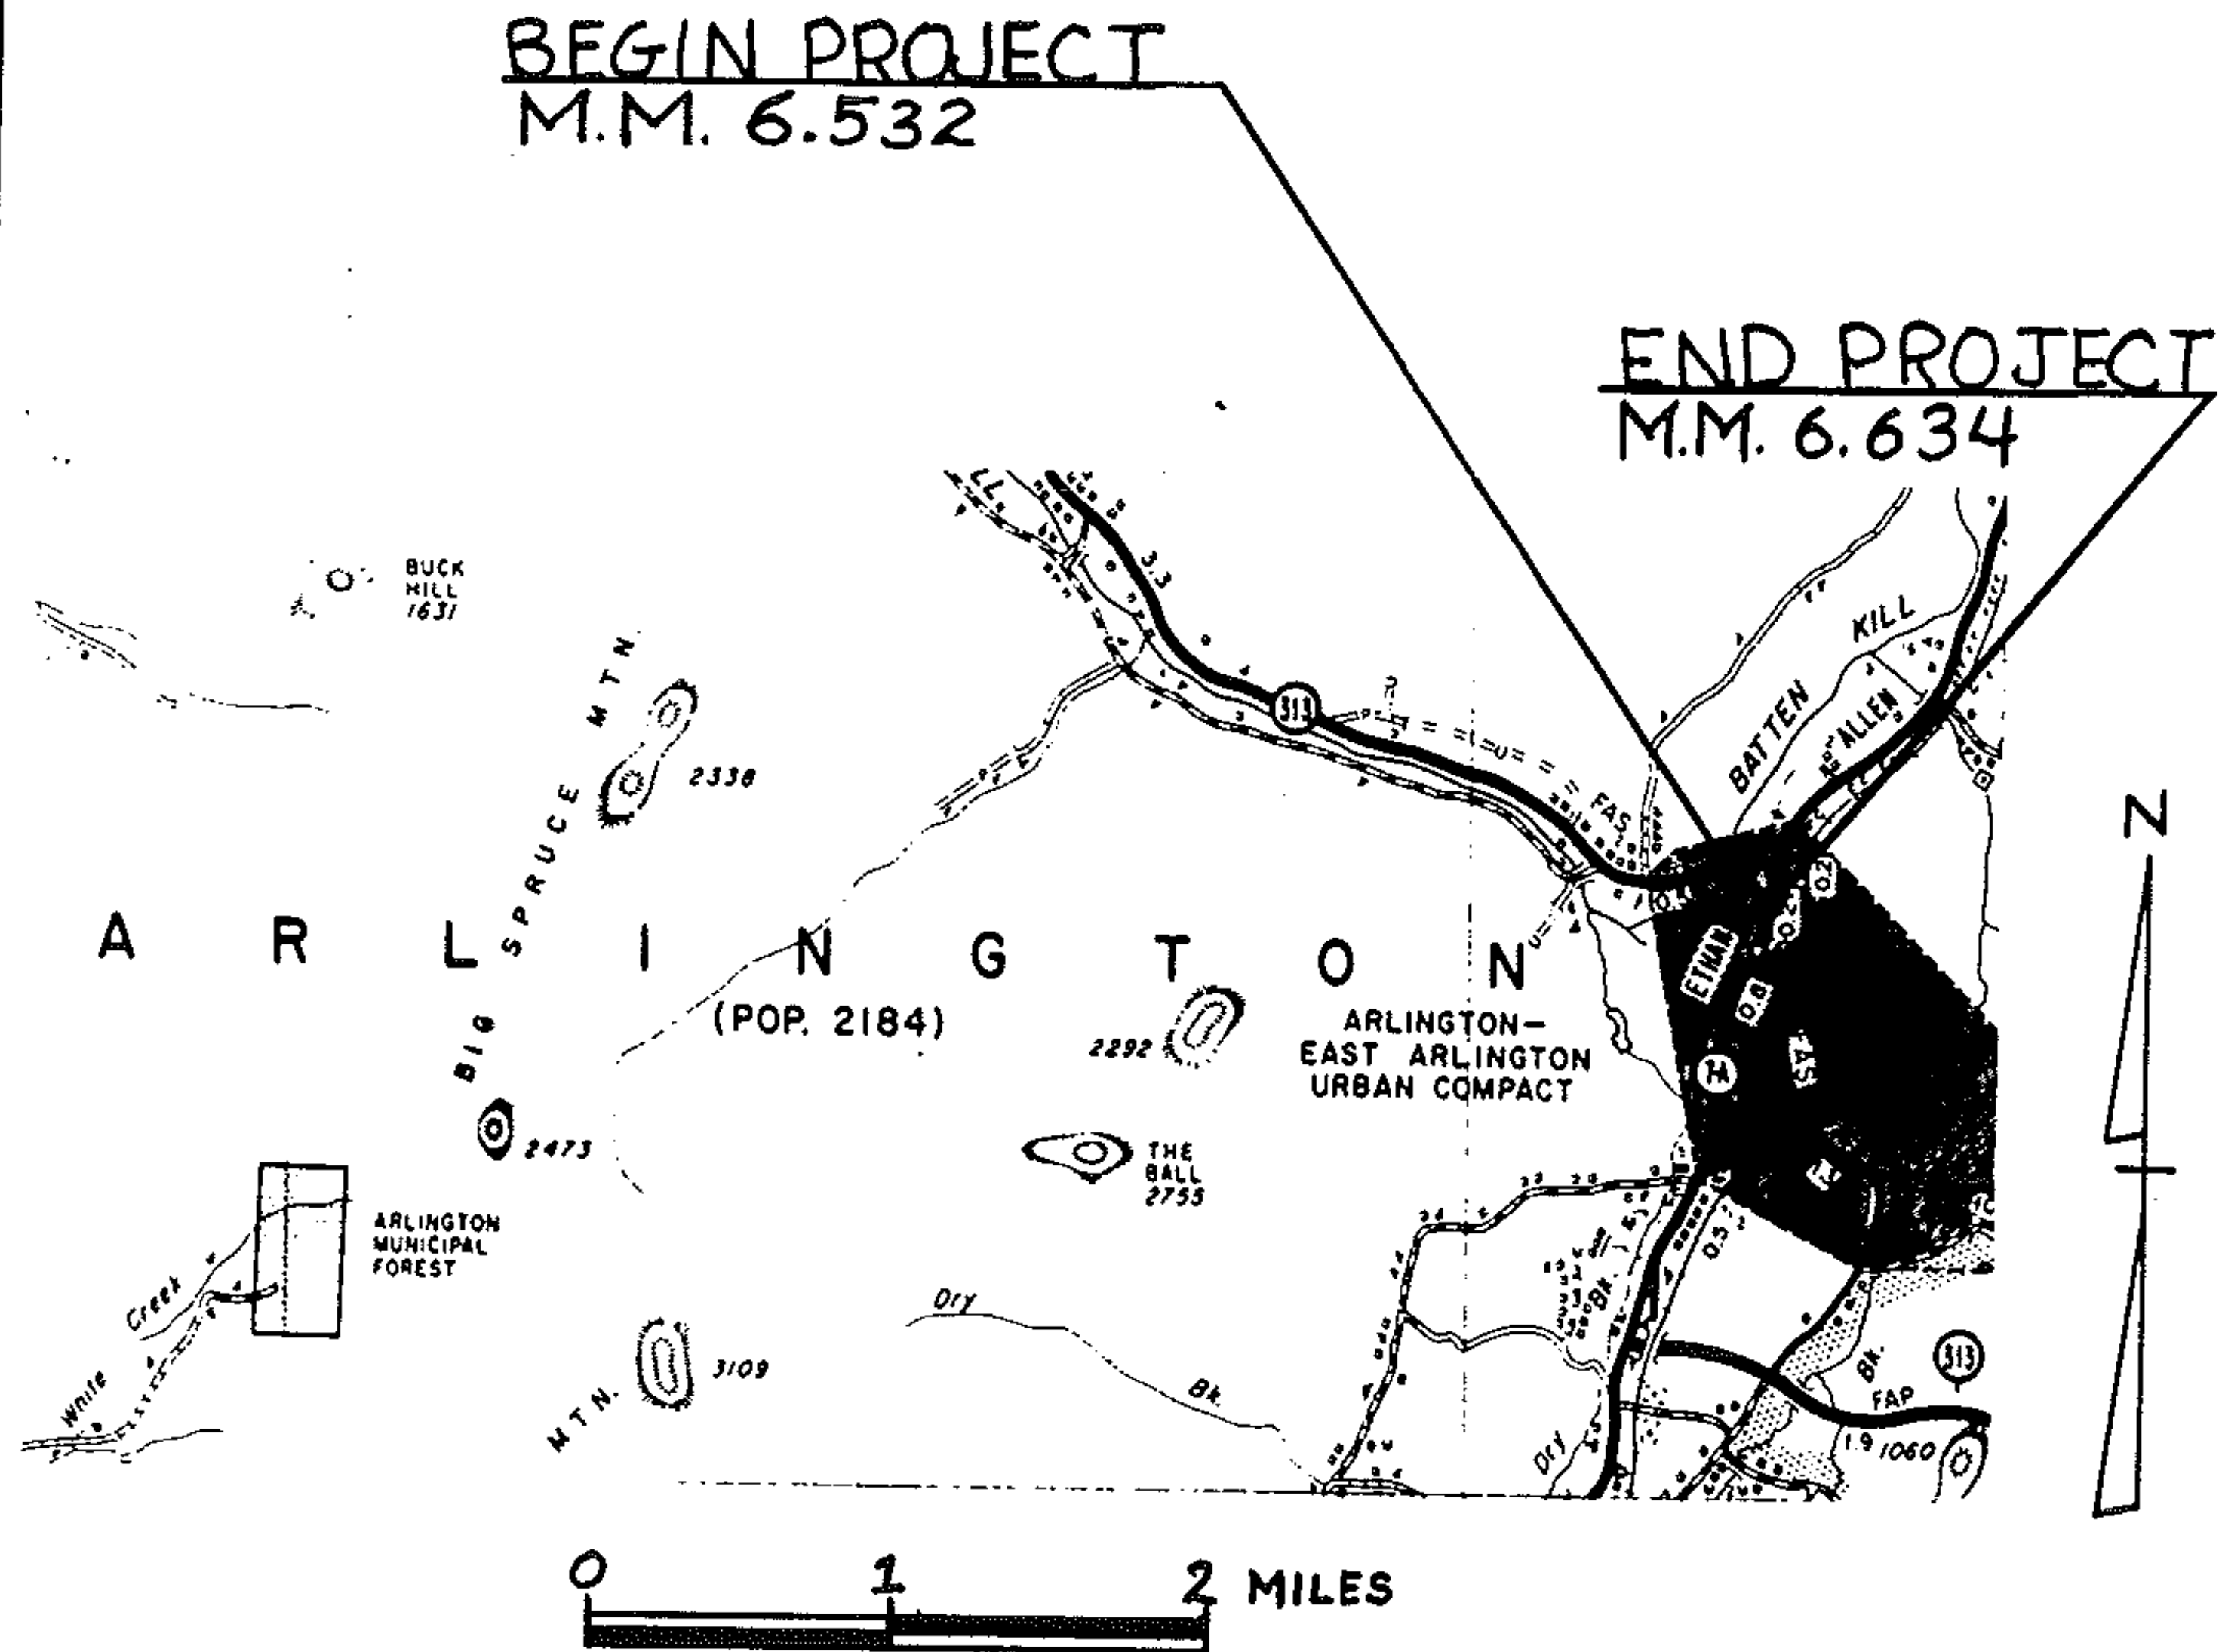

PROJECT ARLINGTON

NO. HMA 2852

SHEET 18 OF 34 SHEETS