



TYPICAL SECTIONS & DESIGN DATA

BITUMINOUS CONCRETE PAVEMENT
 LEVELING COURSE TYPE IV (273* & 358** TONS/MILE)
 AS DIRECTED BY THE ENGINEER.
 1 1/2" WEARING COURSE TYPE III (± 1/4" THICKNESS TOLERANCE)

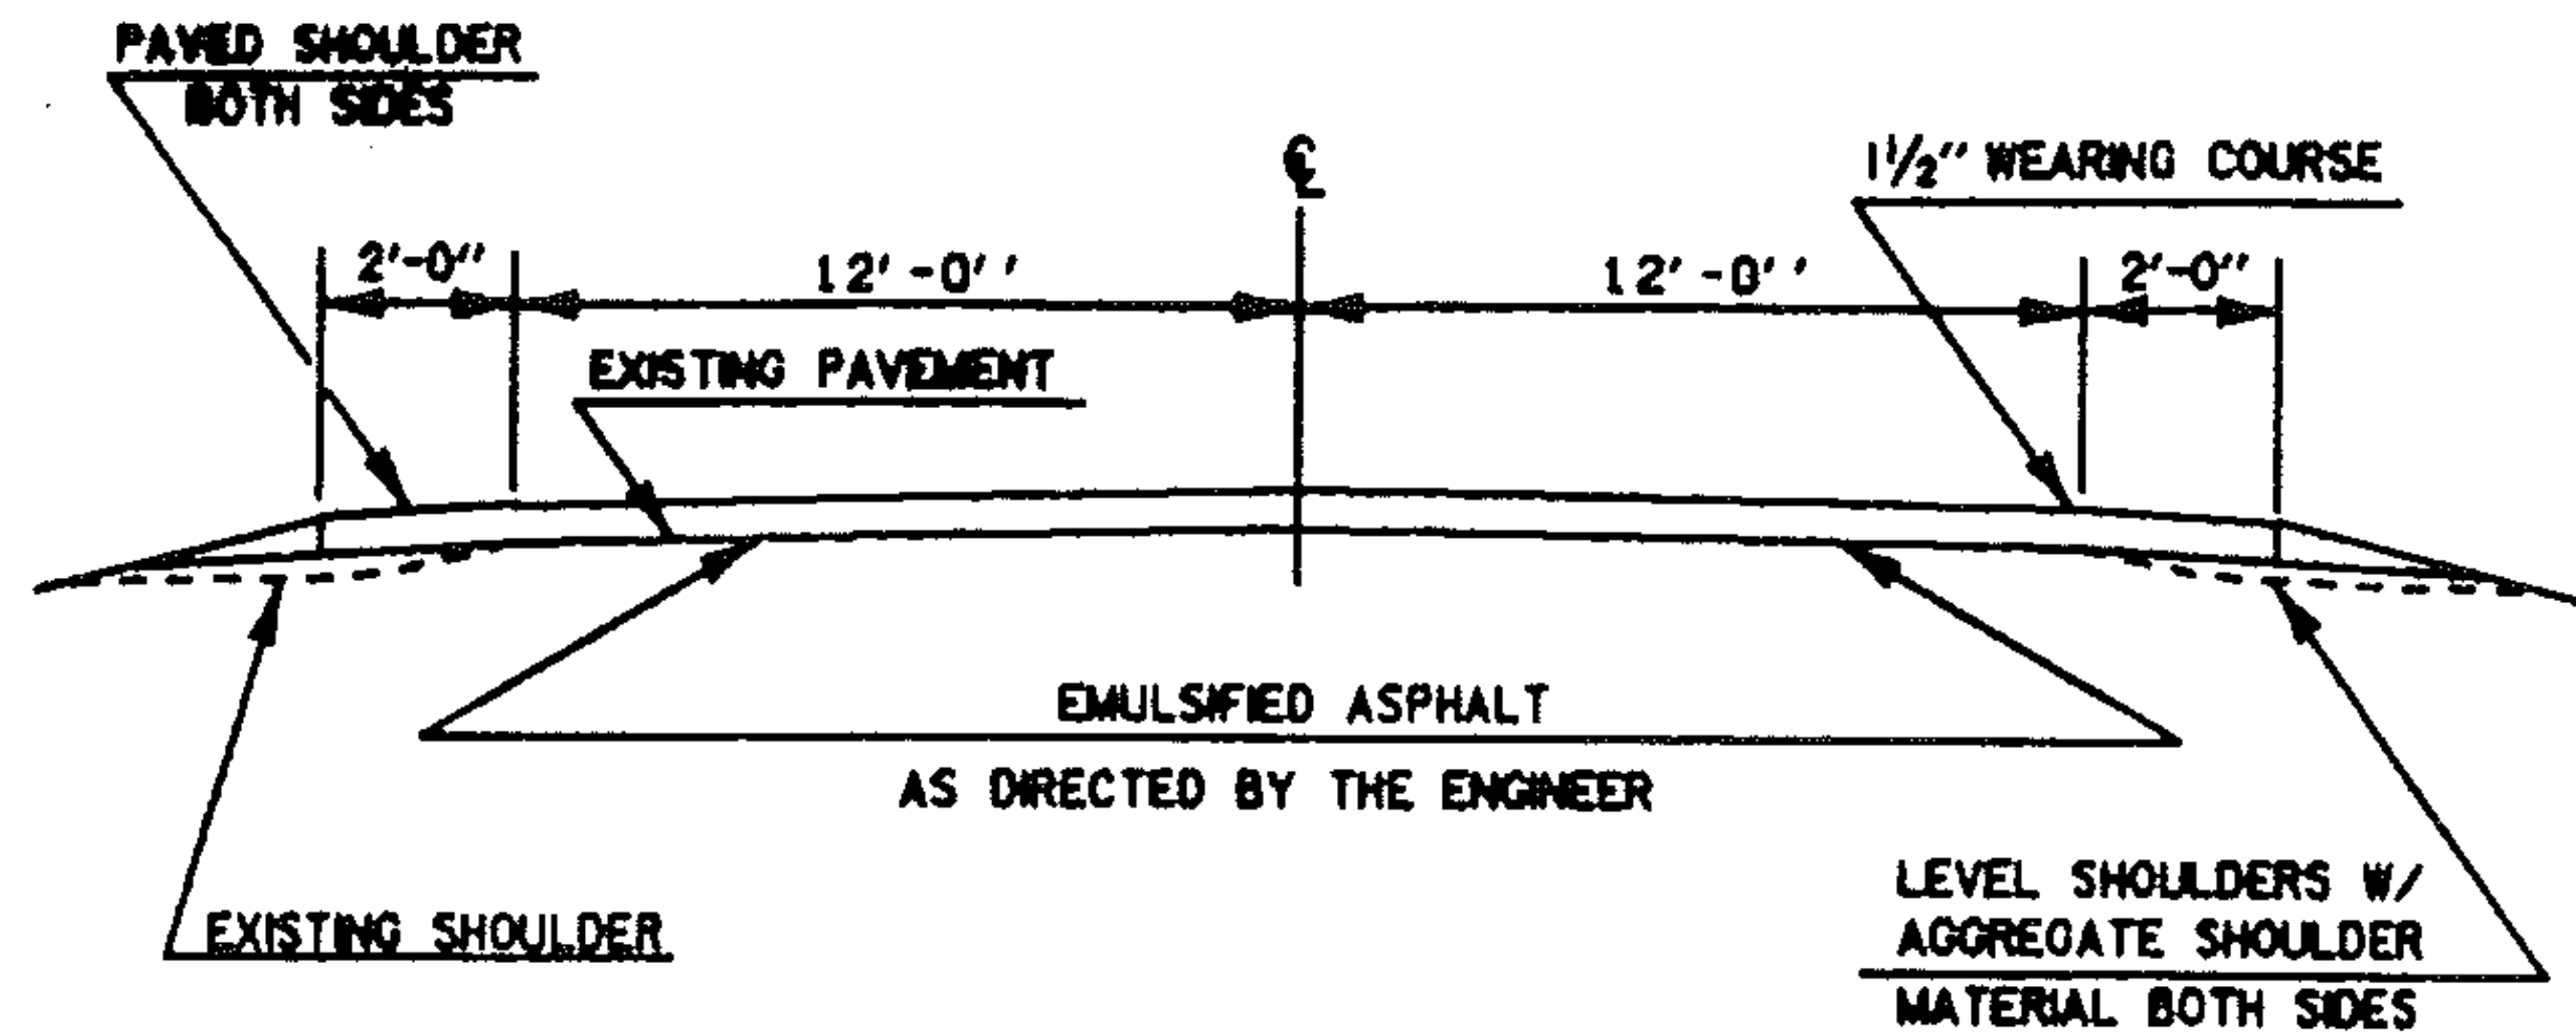

U.S. 7 MM 2.807 ~ MM 2.873*

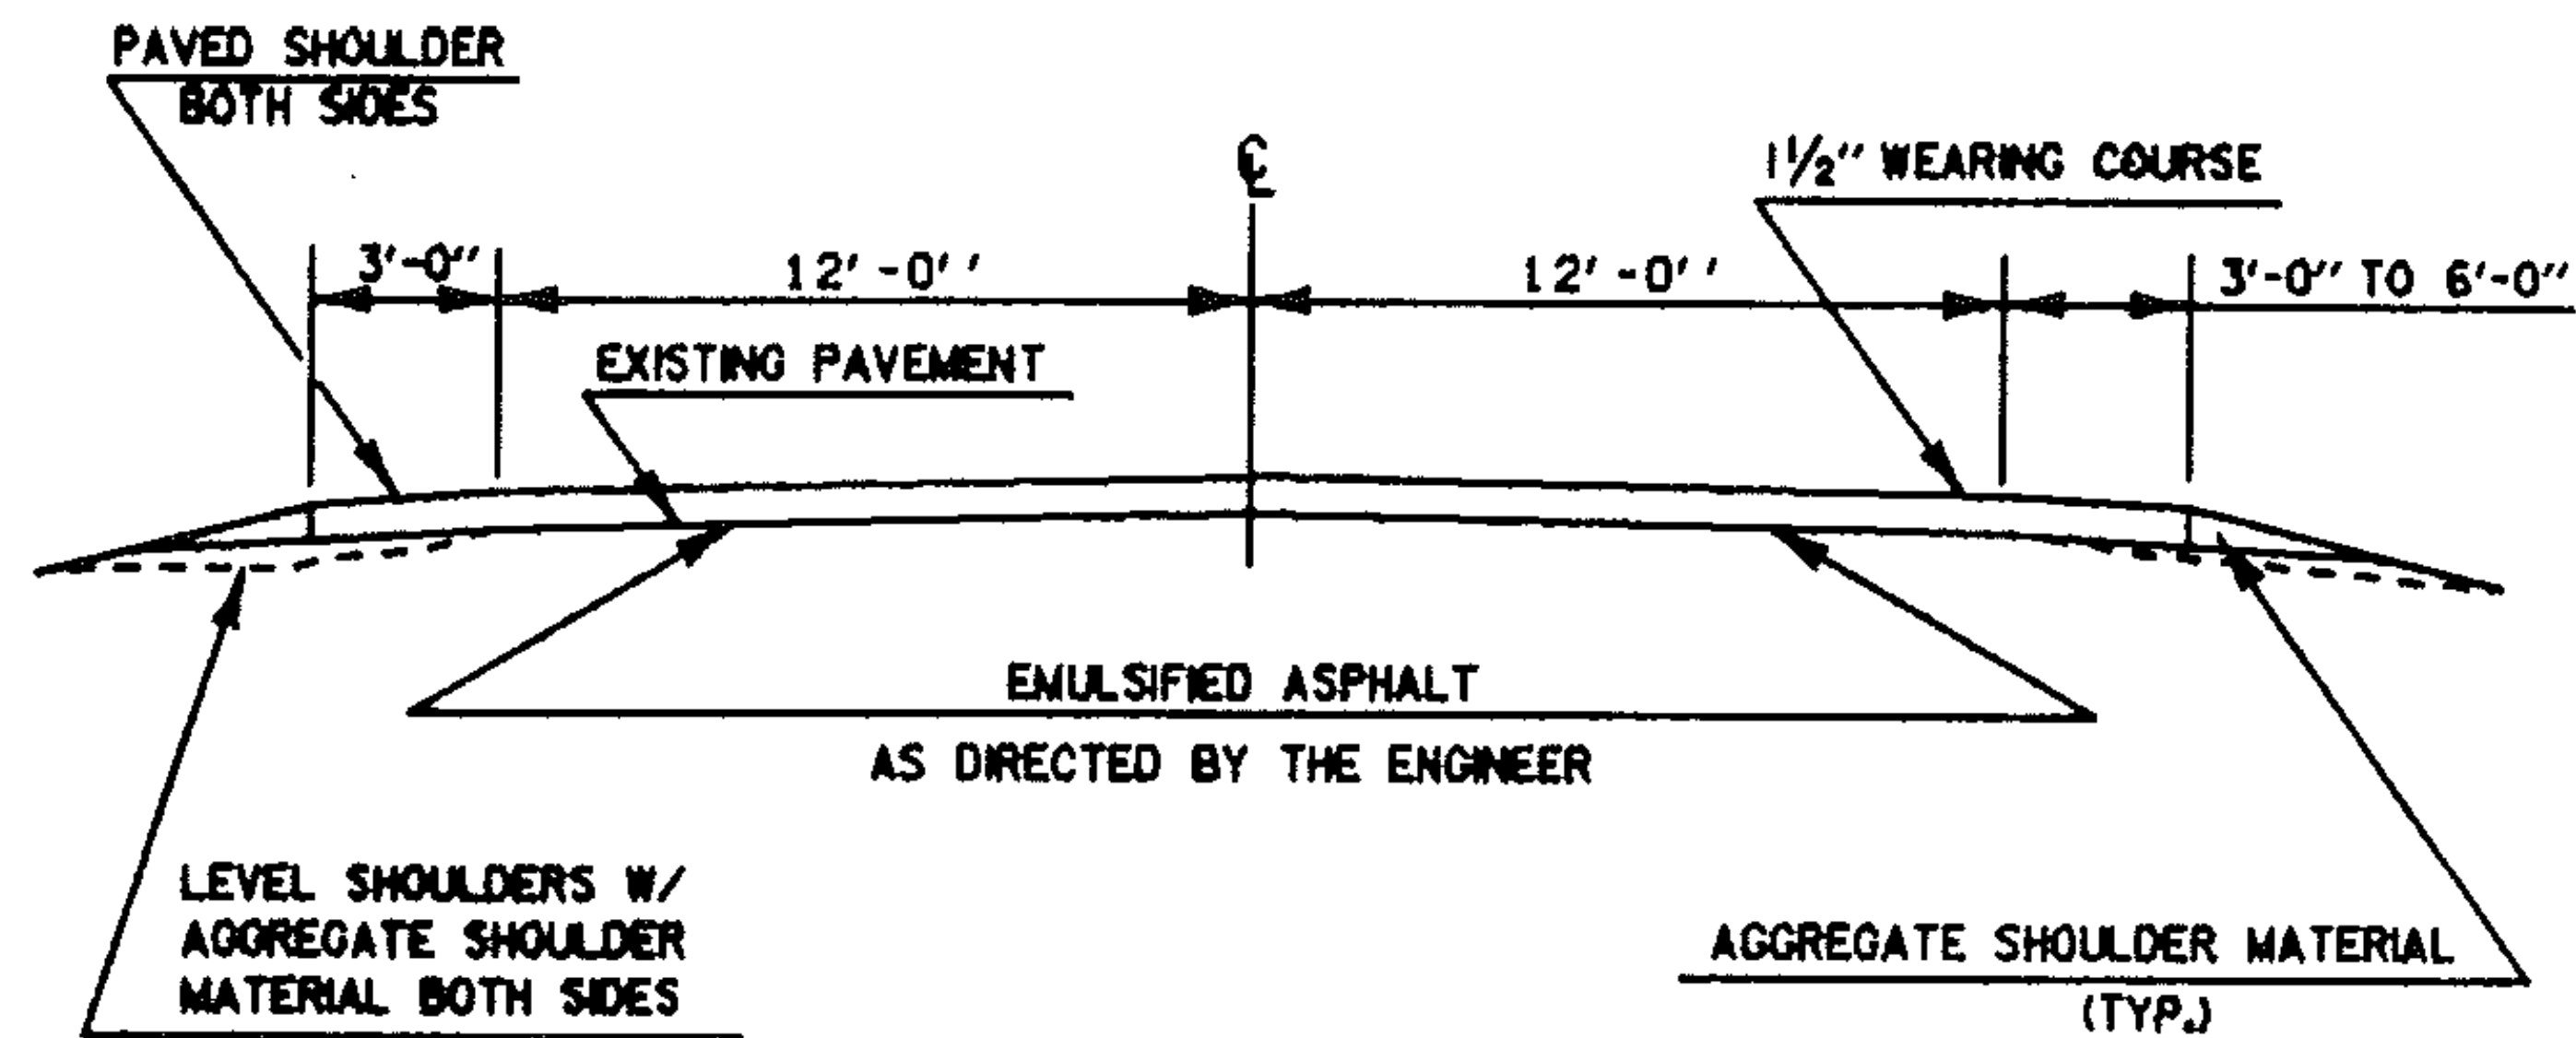

U.S. 7 MM 2.873 ~ MM 3.357**

NOTE : WHEN ENCOUNTERING VEGETATION OR POOR MATERIAL IN THE SHOULDER AREA, REMOVE 2" BELOW EXISTING PAVEMENT LEVEL AND REPLACE WITH AGGREGATE SHOULDER MATERIAL. REMOVAL OF THIS MATERIAL WILL BE PAID FOR UNDER THE ITEM 'ALL PURPOSE EXCAVATOR RENTAL' OR 'GRADER RENTAL'.

PROJECT BRANDON

NO. HMA 2812
 SHEET 4 OF 7 SHEETS
 SHEET 17 OF 75 SHEETS