



# TYPICAL SECTIONS & DESIGN DATA

BITUMINOUS CONCRETE PAVEMENT  
 LEVELING COURSE TYPE IV (295\* & 227\*\* TONS/MILE)  
 AS DIRECTED BY THE ENGINEER.  
 1 1/4" WEARING COURSE TYPE III (±1/4" THICKNESS TOLERANCE)

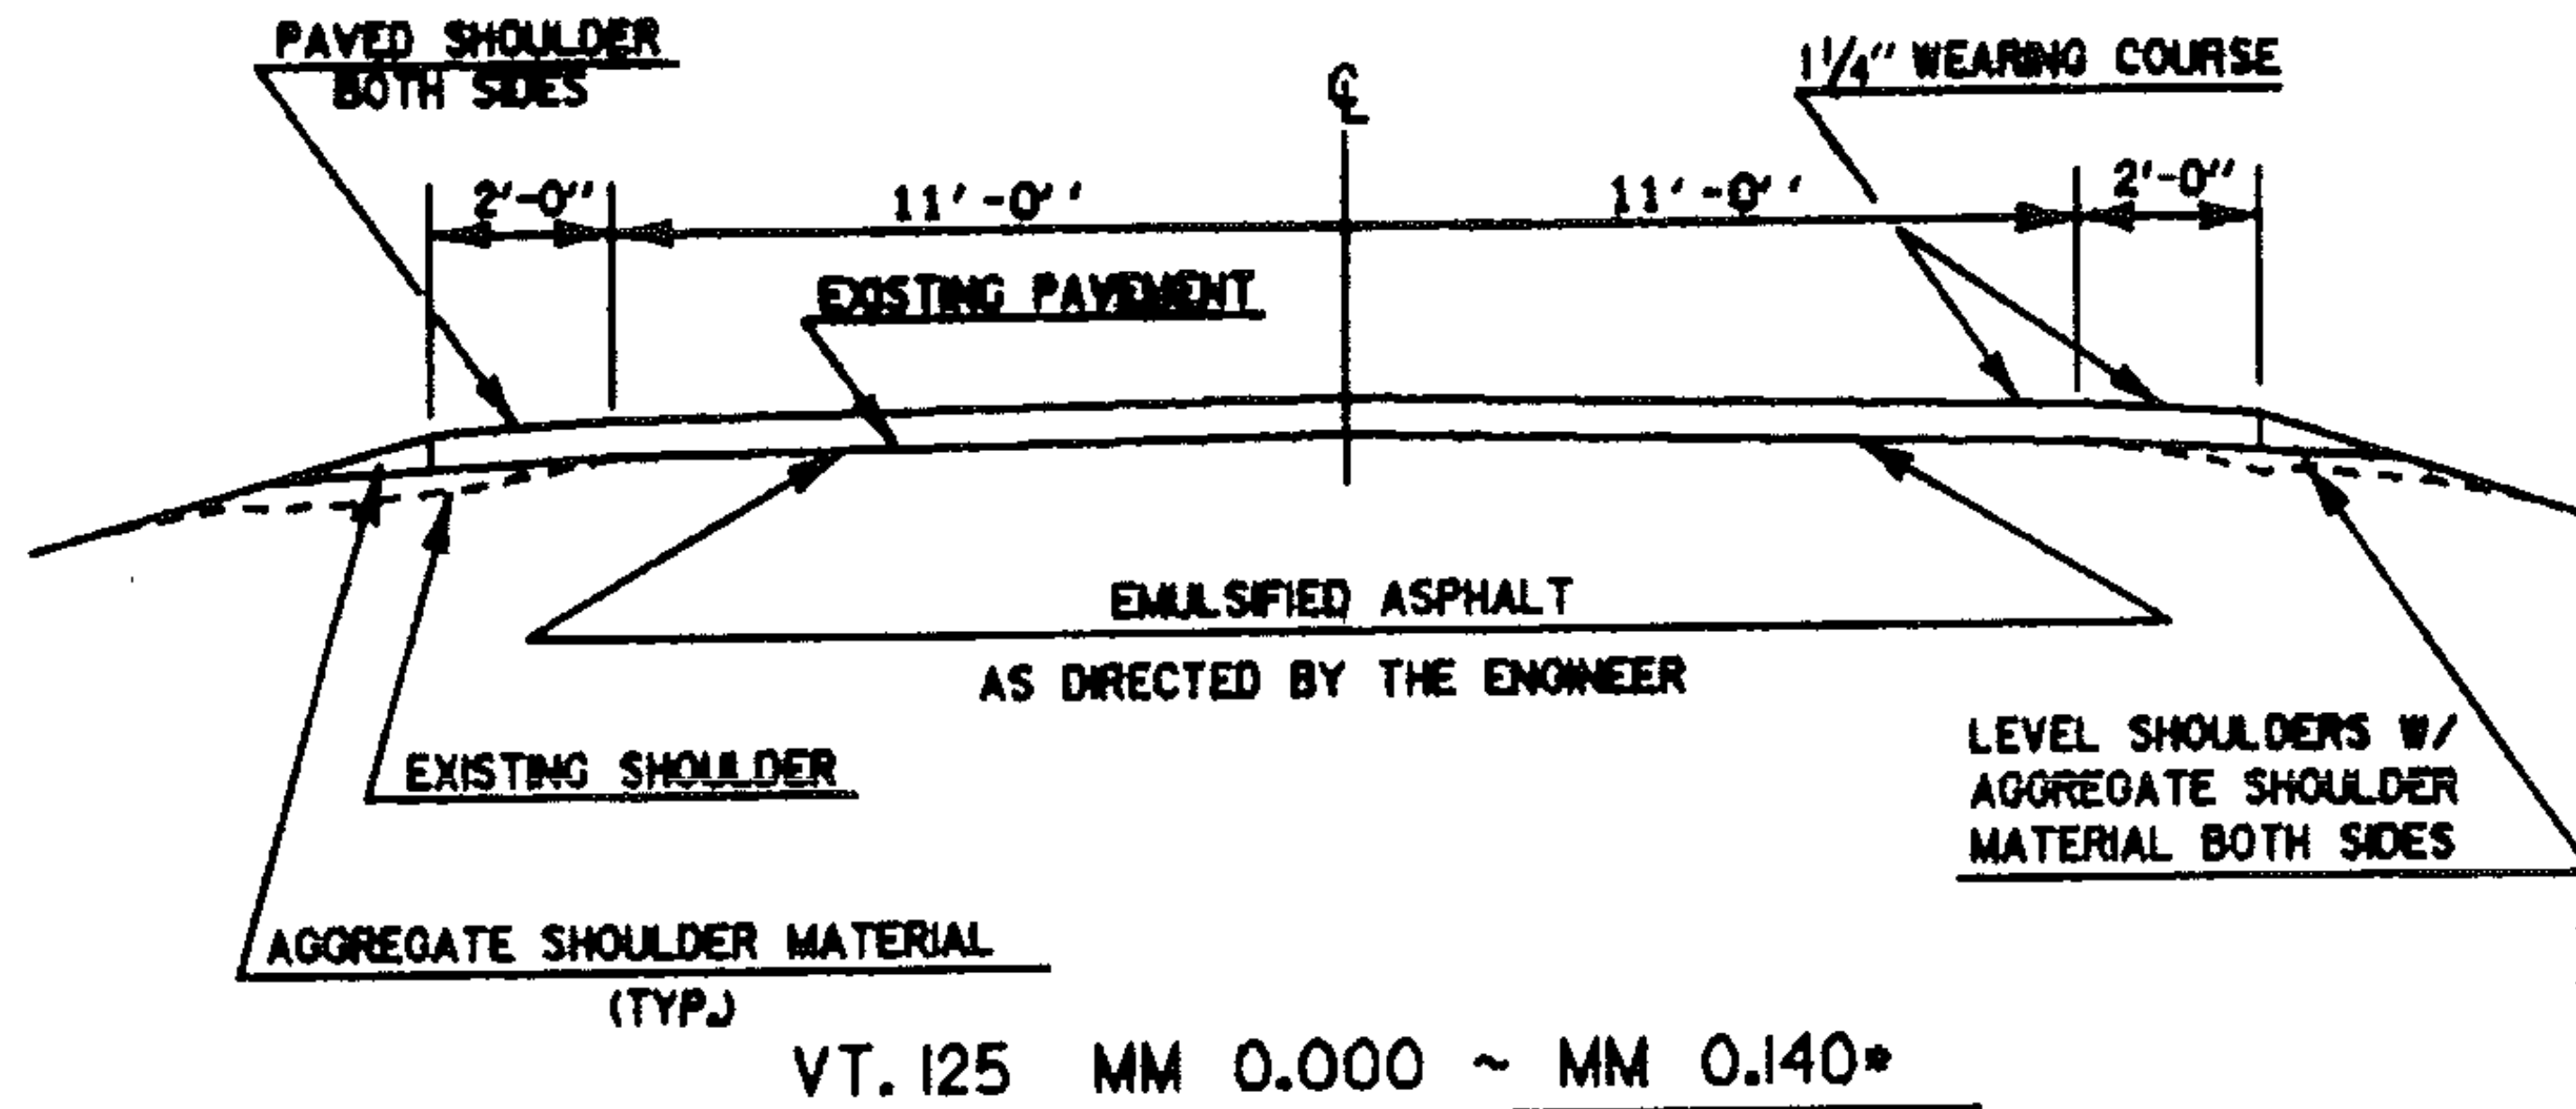

NOTE : WHEN ENCOUNTERING VEGETATION OR POOR MATERIAL IN THE SHOULDER AREA, REMOVE 2" BELOW EXISTING PAVEMENT LEVEL AND REPLACE WITH AGGREGATE SHOULDER MATERIAL. REMOVAL OF THIS MATERIAL WILL BE PAID FOR UNDER THE ITEM 'ALL PURPOSE EXCAVATOR RENTAL' OR 'GRADER RENTAL'.

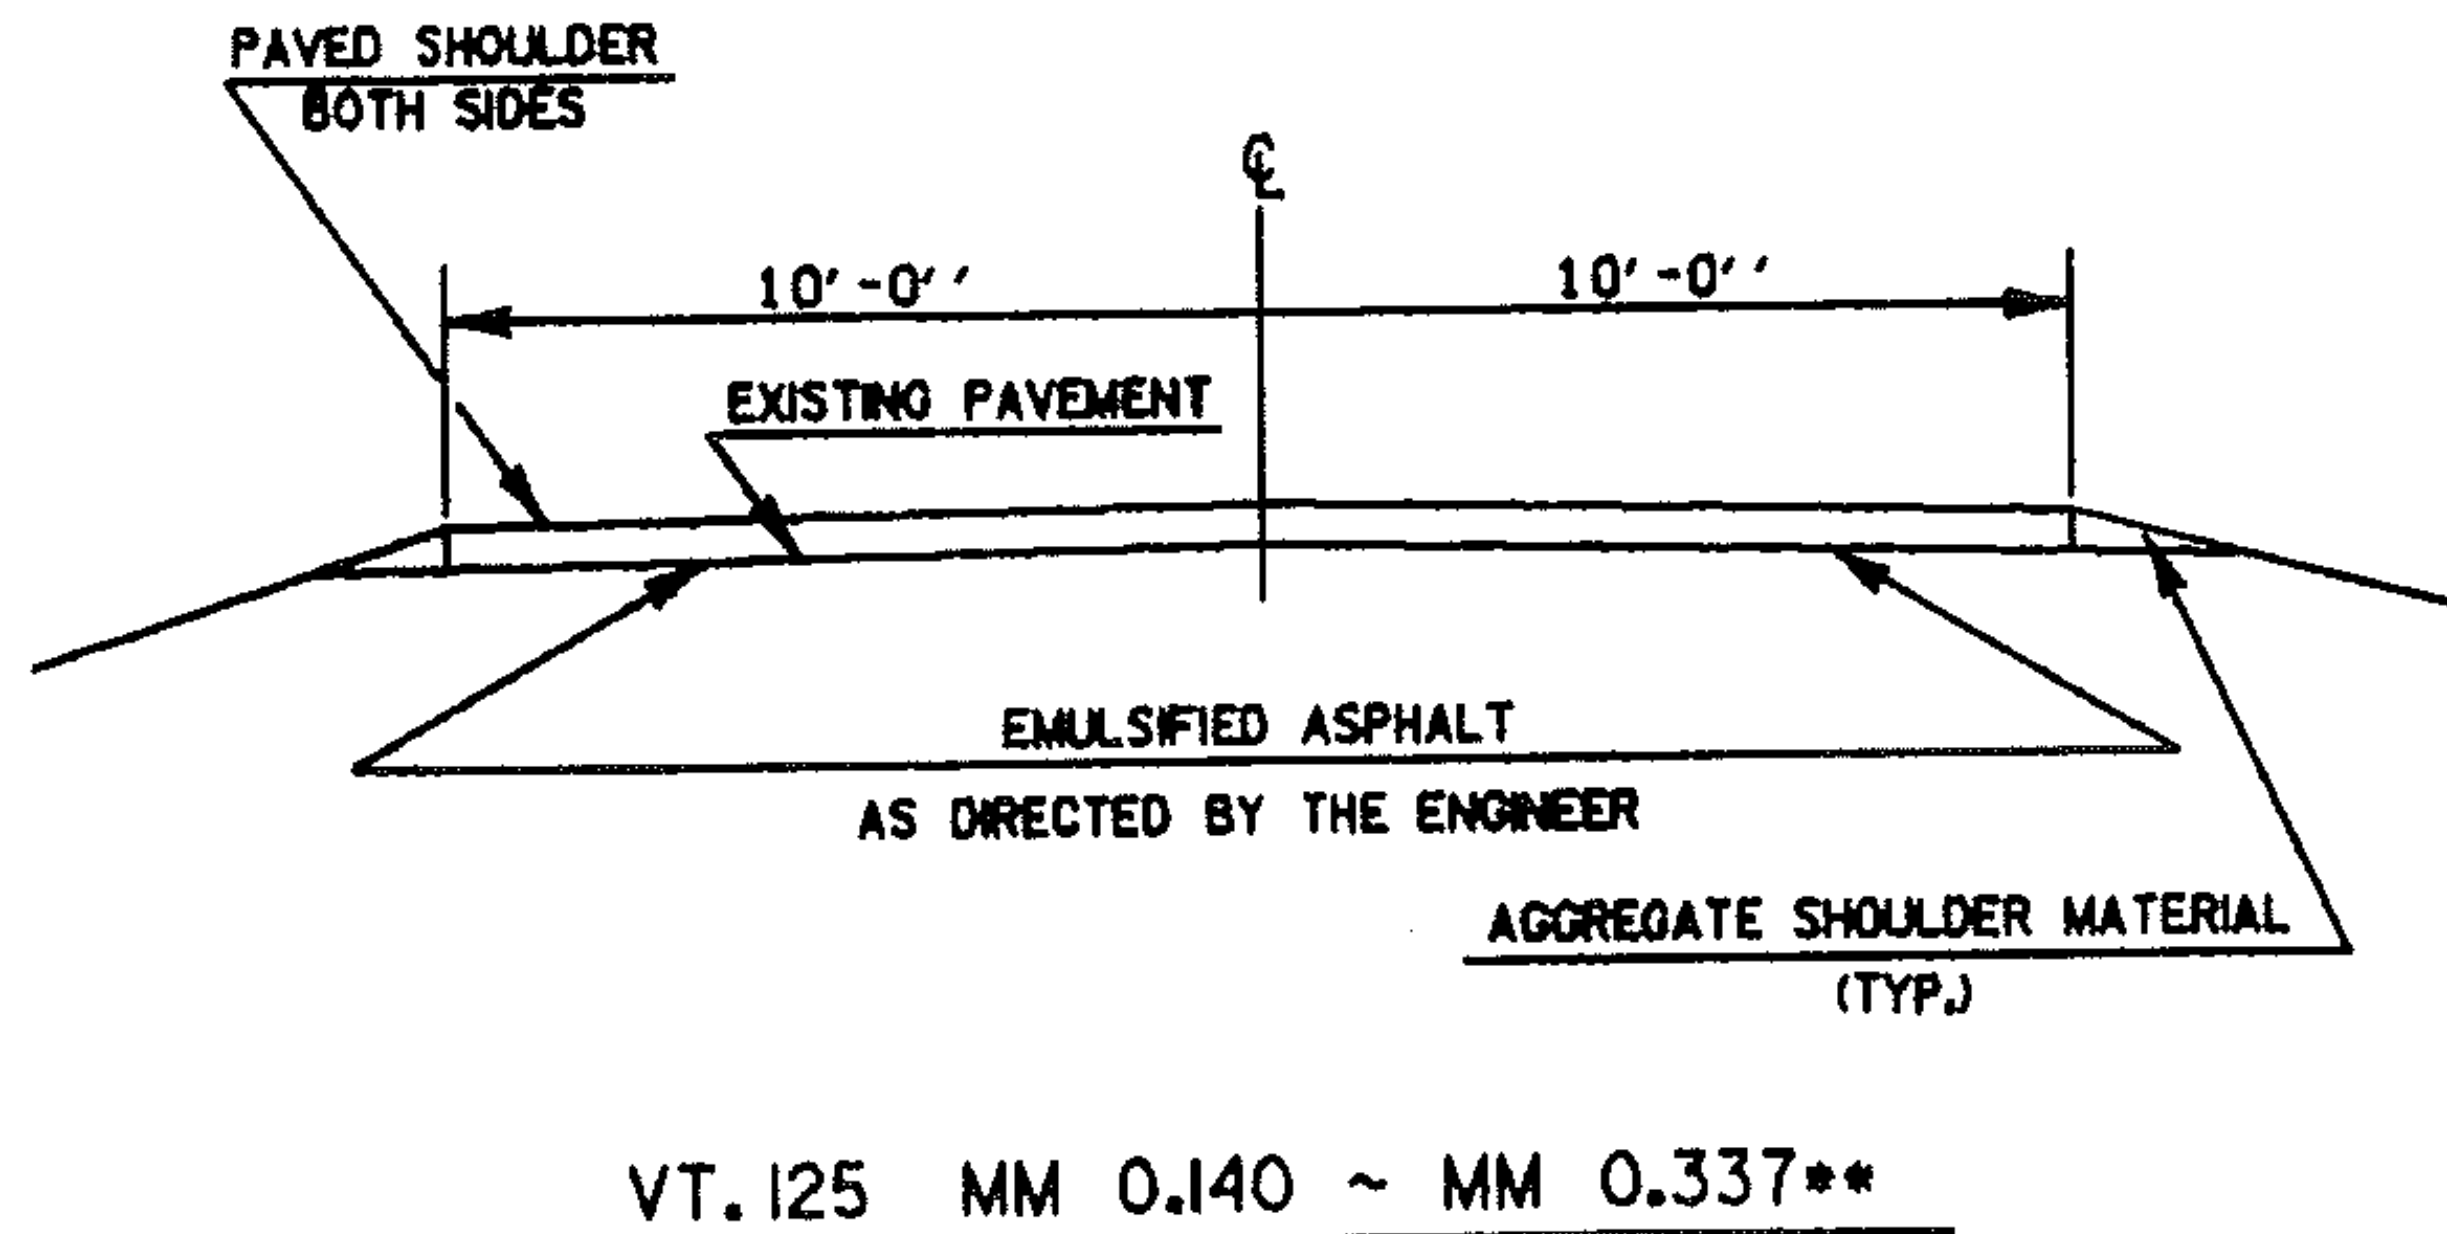

PROJECT RIPTON

NO. HMA 2864  
 SHEET 4 OF 8 SHEETS  
 SHEET 52 OF 75 SHEETS