
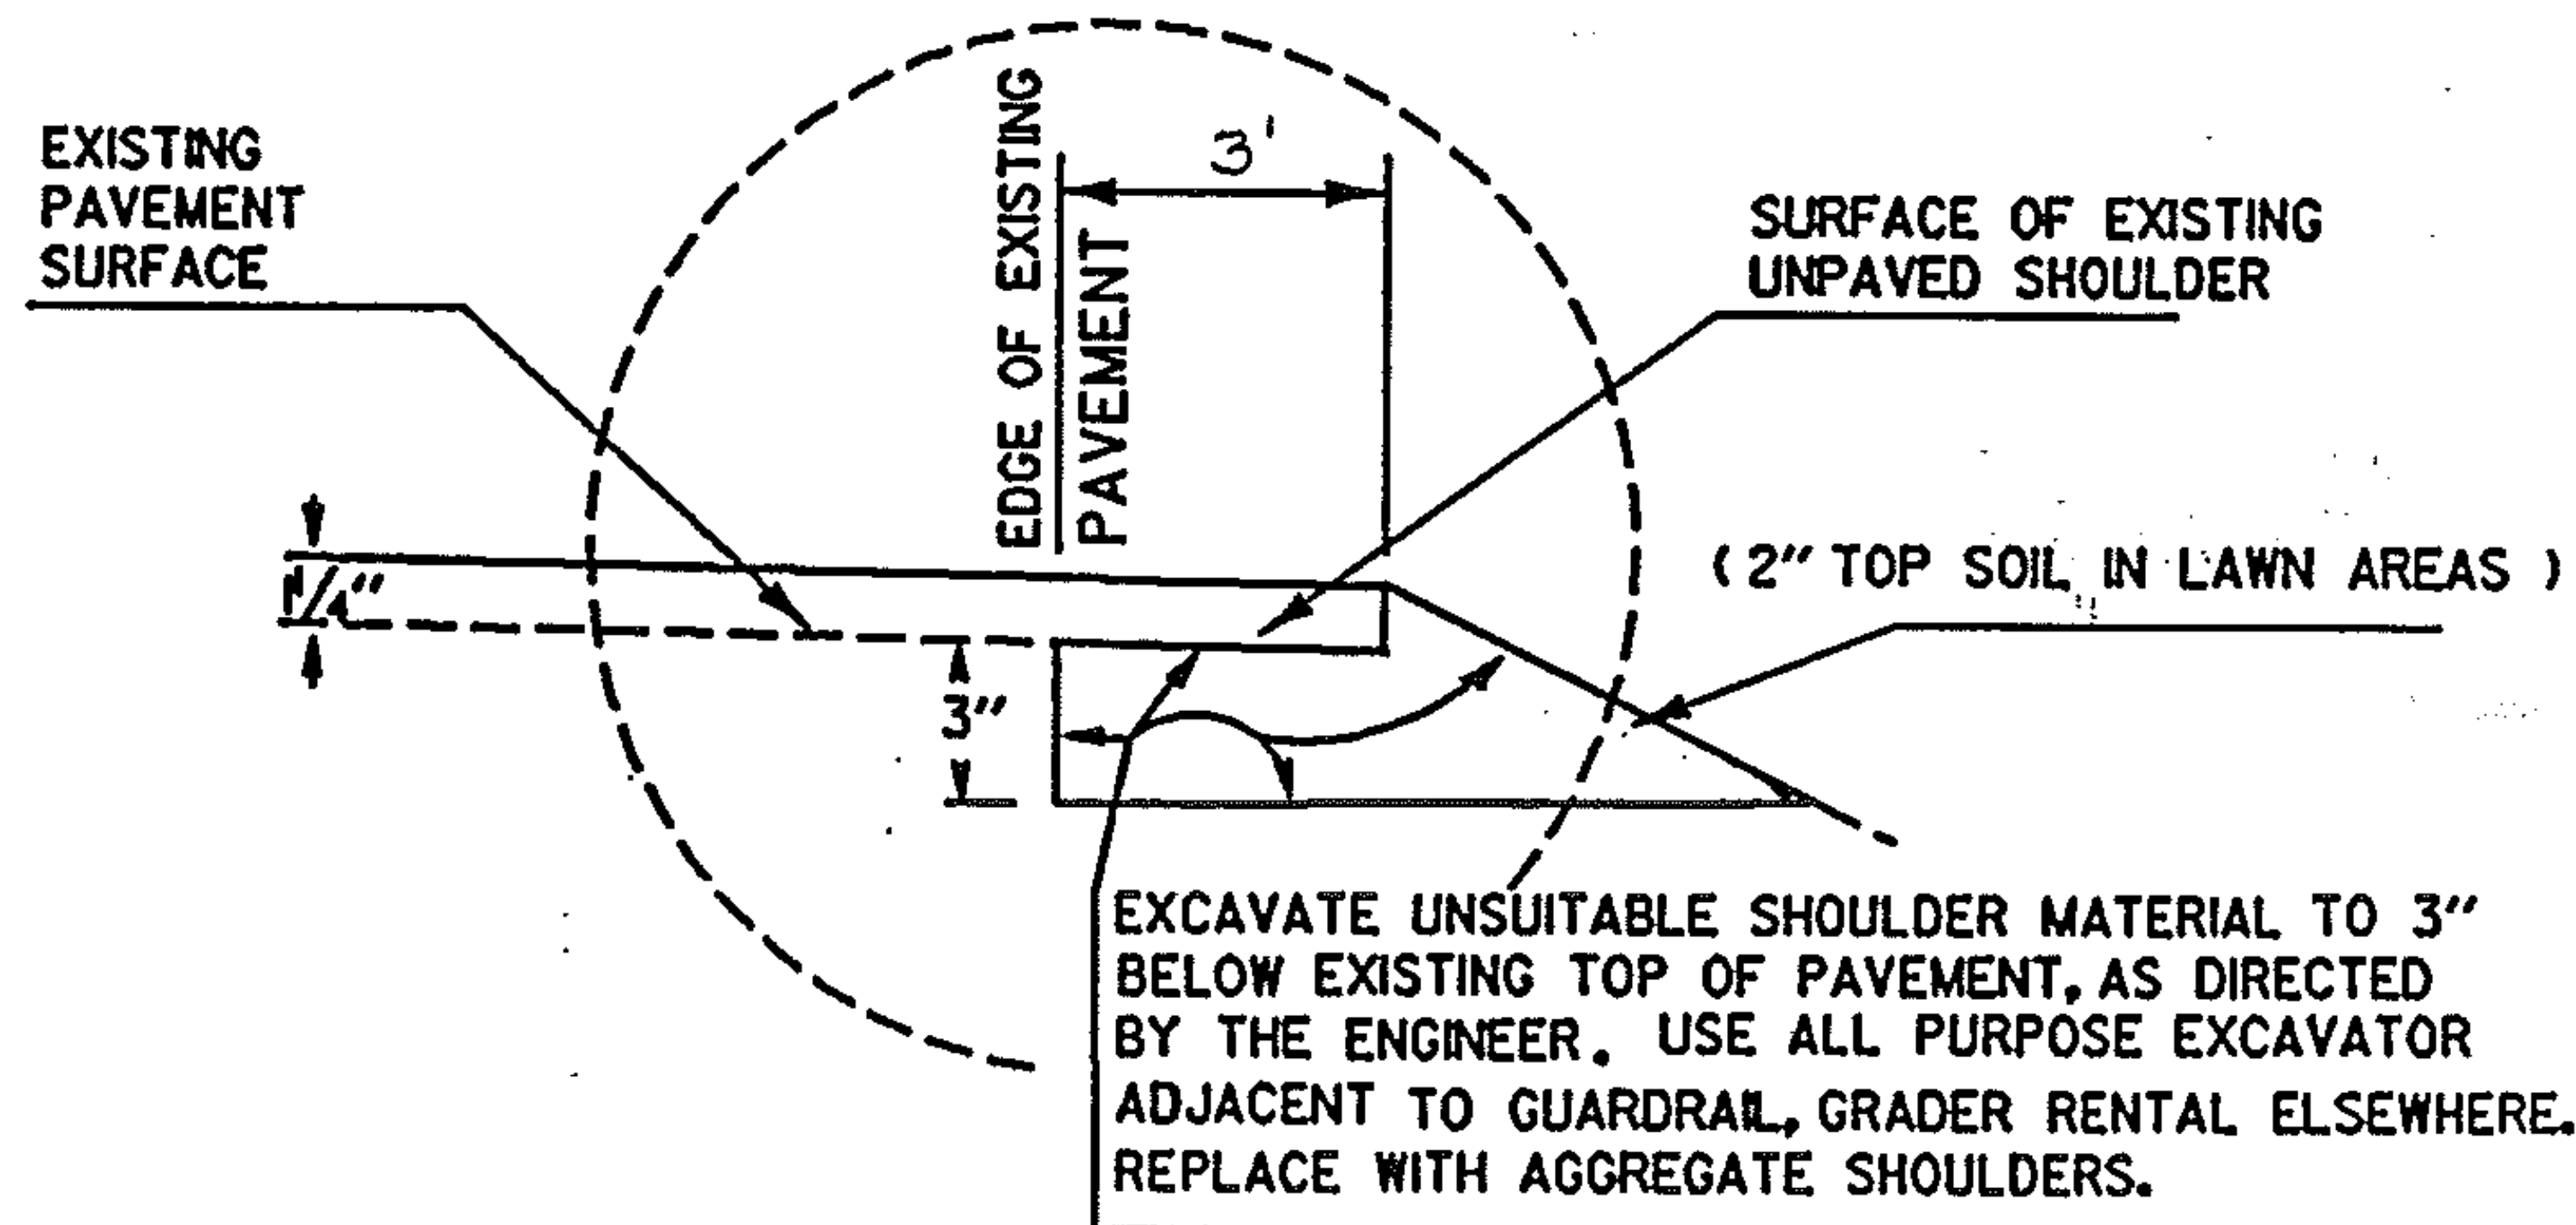


# TYPICAL SECTIONS & DESIGN DATA

ITEM 406.25 BITUMINOUS CONCRETE PAVEMENT  
 AGGREGATE SHOULDERS ( $\pm 1/2''$ )  
 LEVELING COURSE TYPE IV (250 TONS/MILE)  
 1 1/4" WEARING COURSE TYPE III ( $\pm 1/4''$ )  
 AS DIRECTED BY THE ENGINEER

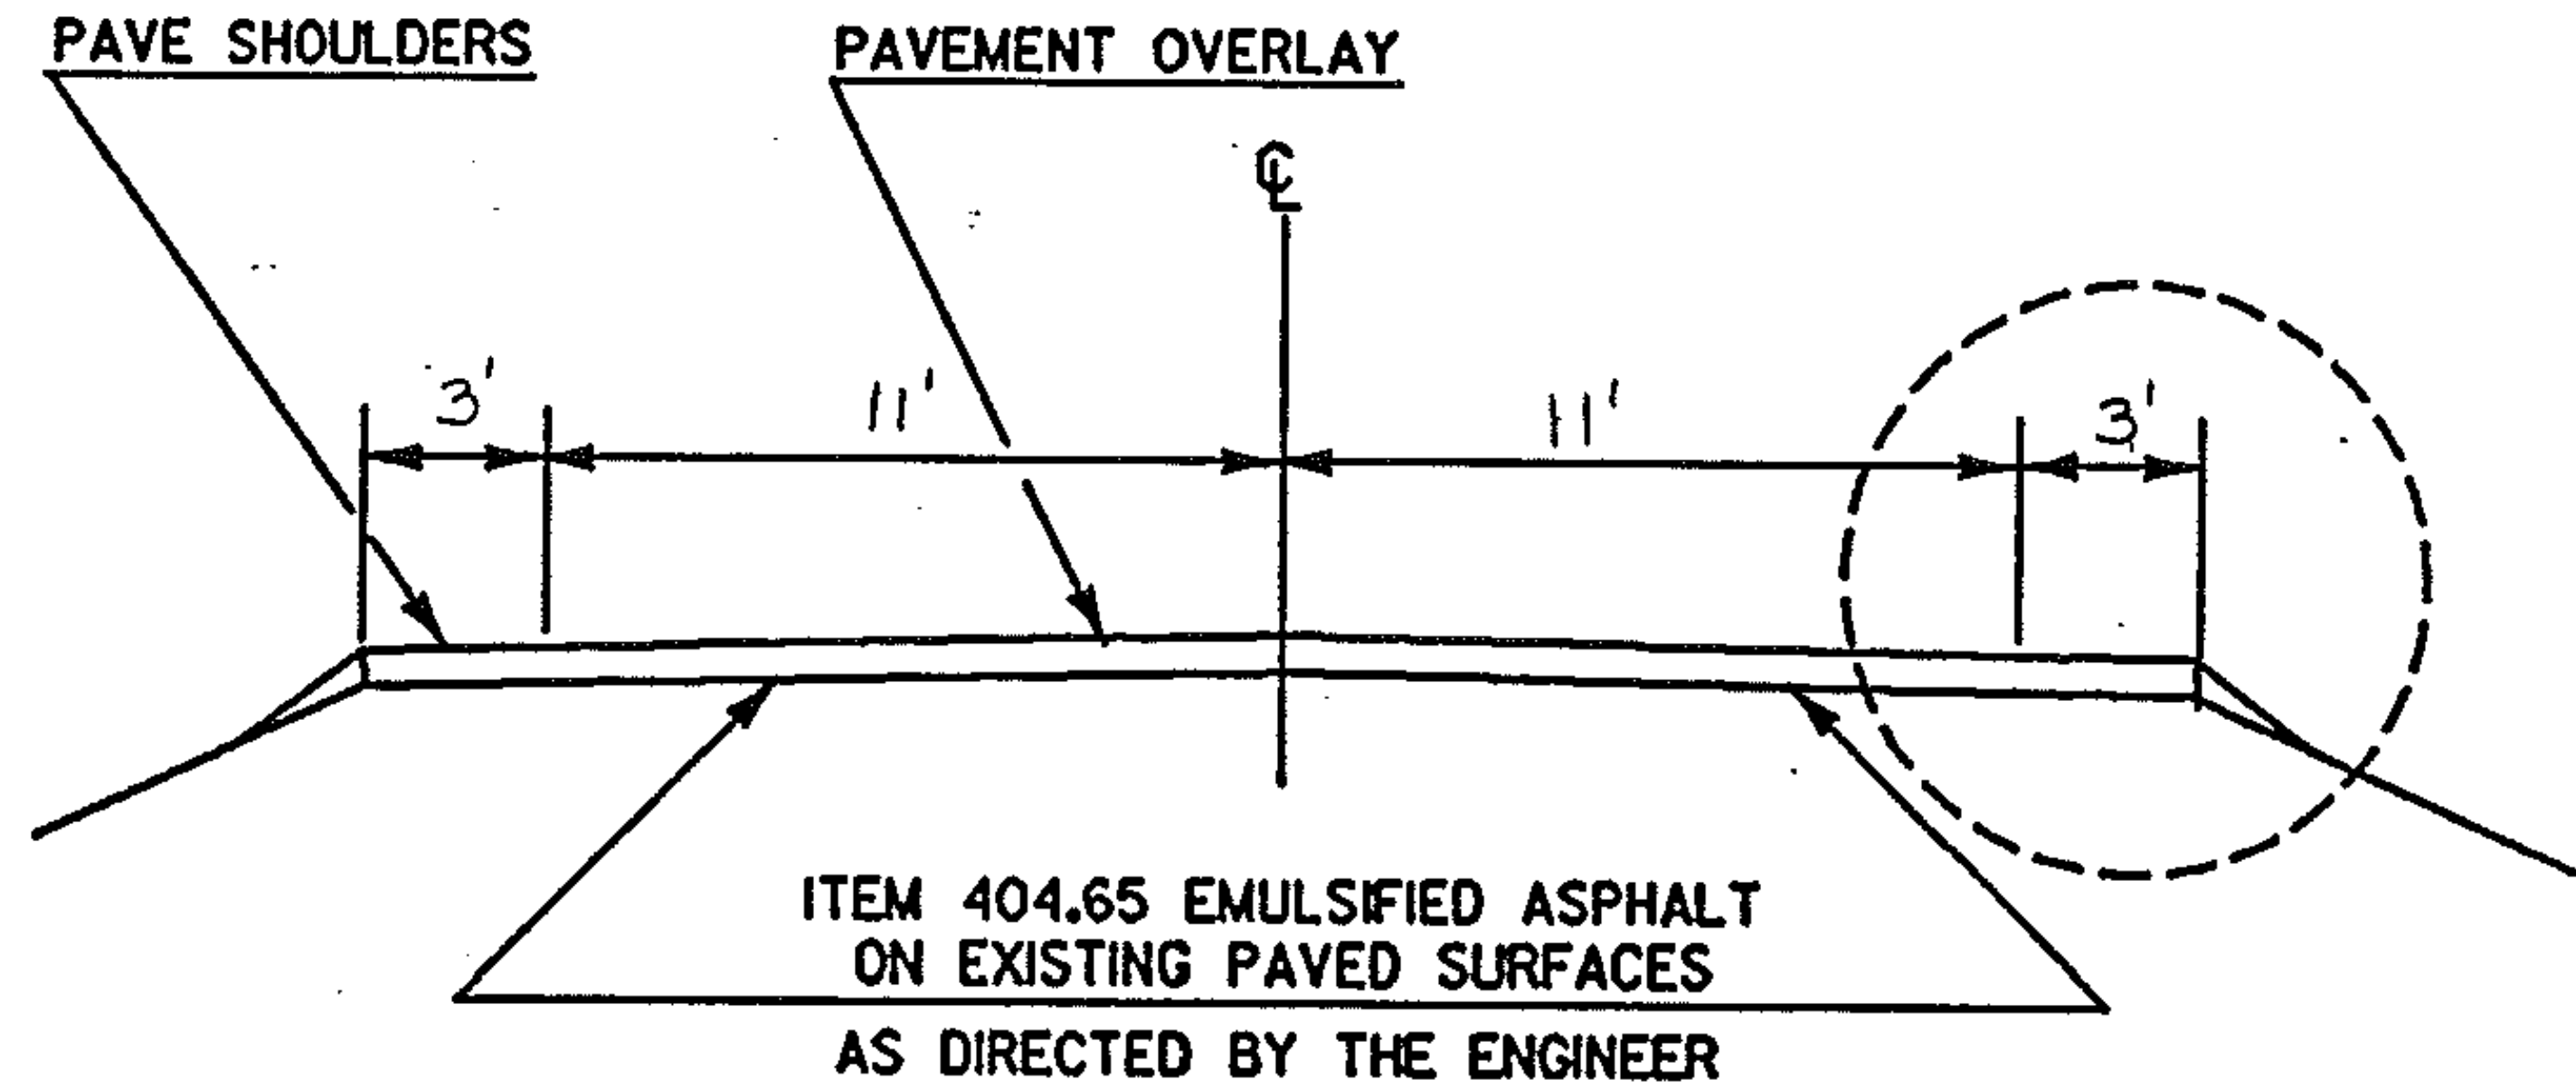

PROJECT MONTGOMERY - BERKSHIRE

NO. HMA 2863

SHEET 14 OF 26 SHEETS