


DESCRIPTION AND LOCATION

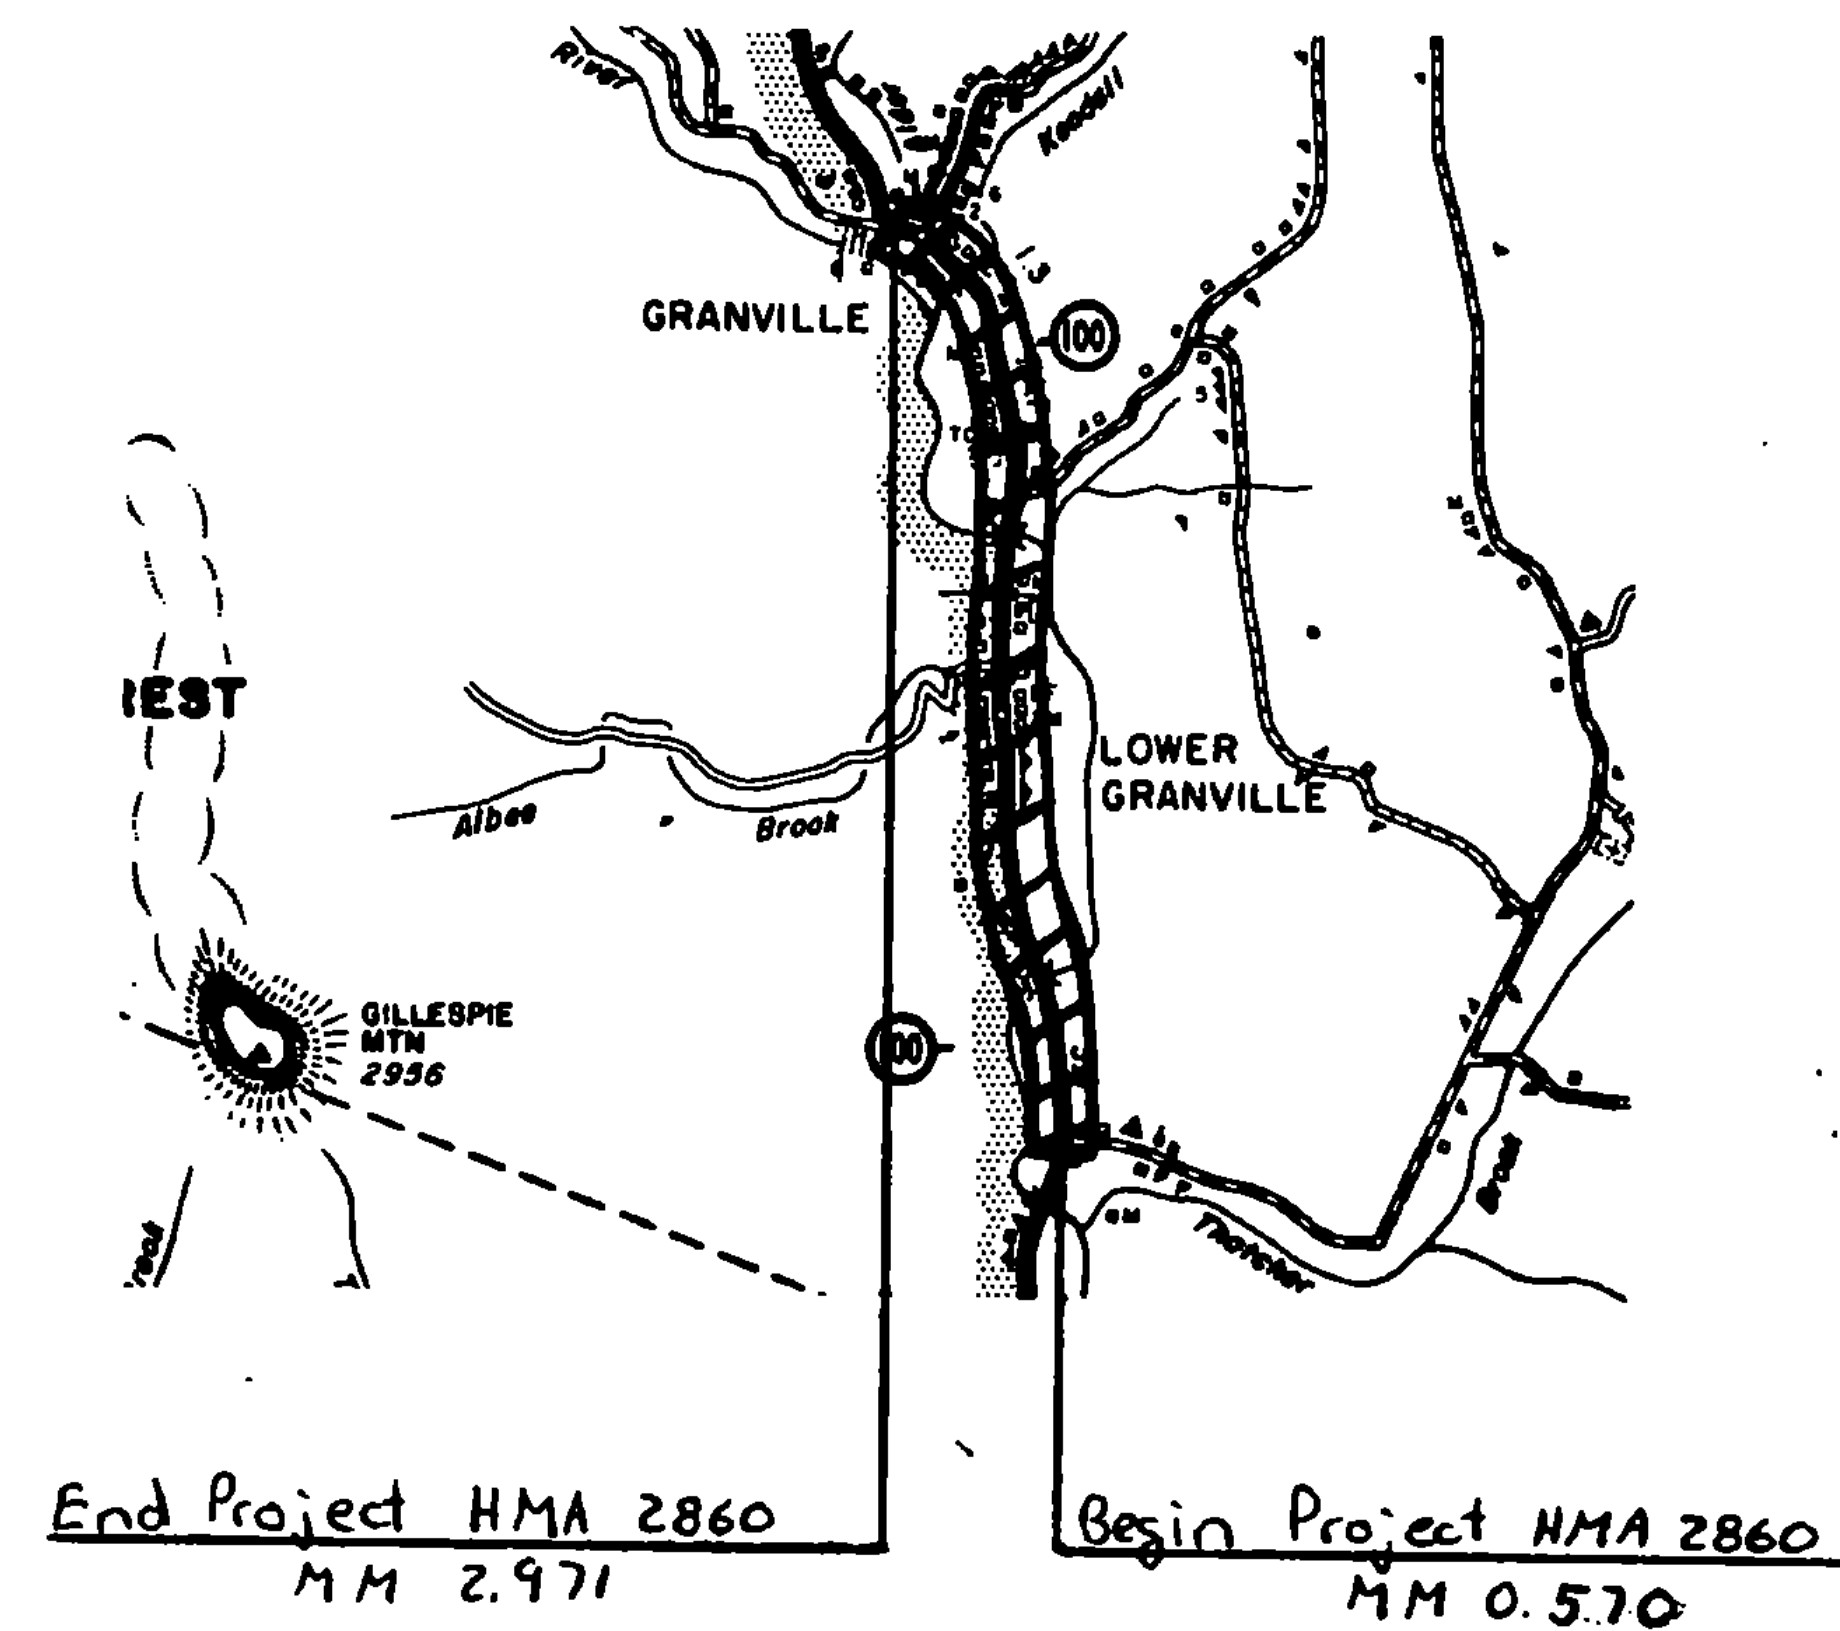

Scale: 1" = 1 mile

Beginning on UT 100, 0.570 miles northerly of the Hancock-Granville town line and extending northerly 2.401 miles to MM 2.971

Work consists of resurfacing of the highway, including shoulders and pavement markings

1986 ADT 1410

Length of Project 2.401 miles
12677 feet

PROJECT Granville

NO. HMA 2860

SHEET 3 OF 10 SHEETS

SHEET 5 OF 38 SHEETS