


DESCRIPTION AND LOCATION

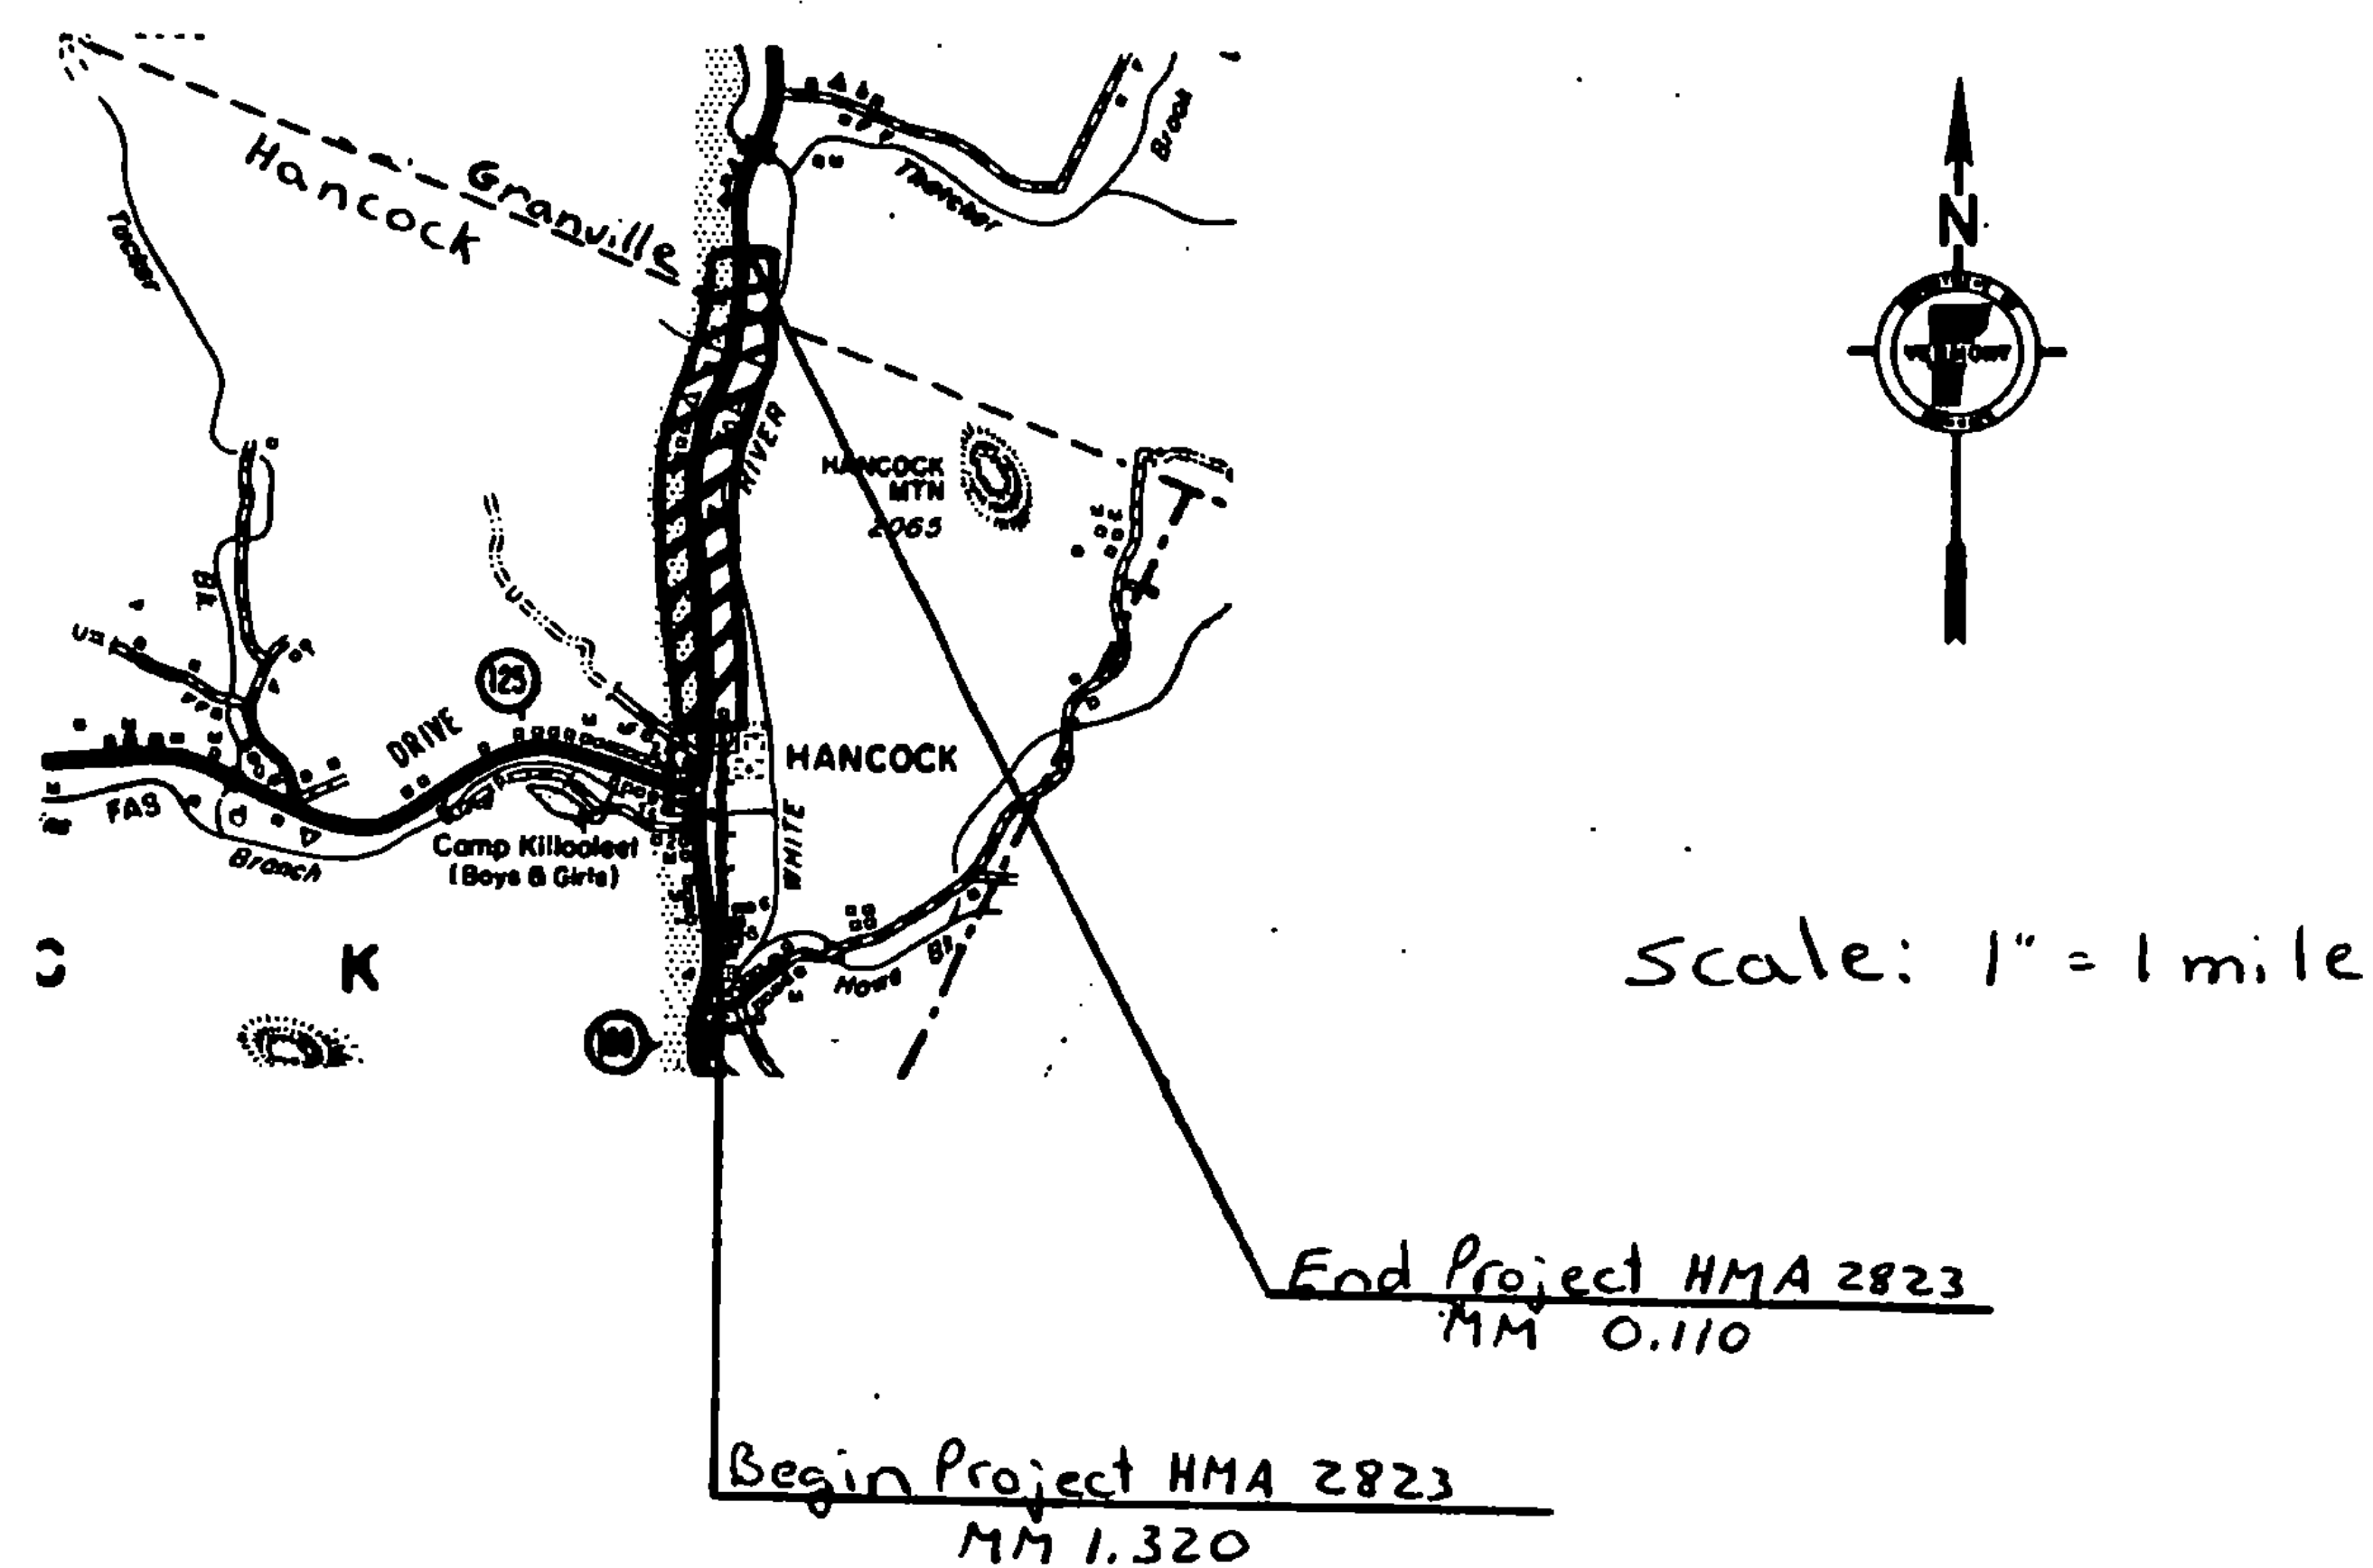

Beginning at a point on VT 100, 1.320 miles northerly of the Rochester - Hancock town line and extending 1.300 miles northerly to MM 0.110 in the town of Granville

Work consists of resurfacing of the highway, including shoulders and new pavement markings

1986 ADT 1810 Length of Project 1.300 miles
6864 feet

PROJECT Hancock - Granville

NO. HMA 2823

SHEET 3 OF 10 SHEETS

SHEET 15 OF 38 SHEETS