



PAVING LIMITS FOR DRIVES & TOWN ROADS

PAVING LIMITS FOR TOWN ROADS

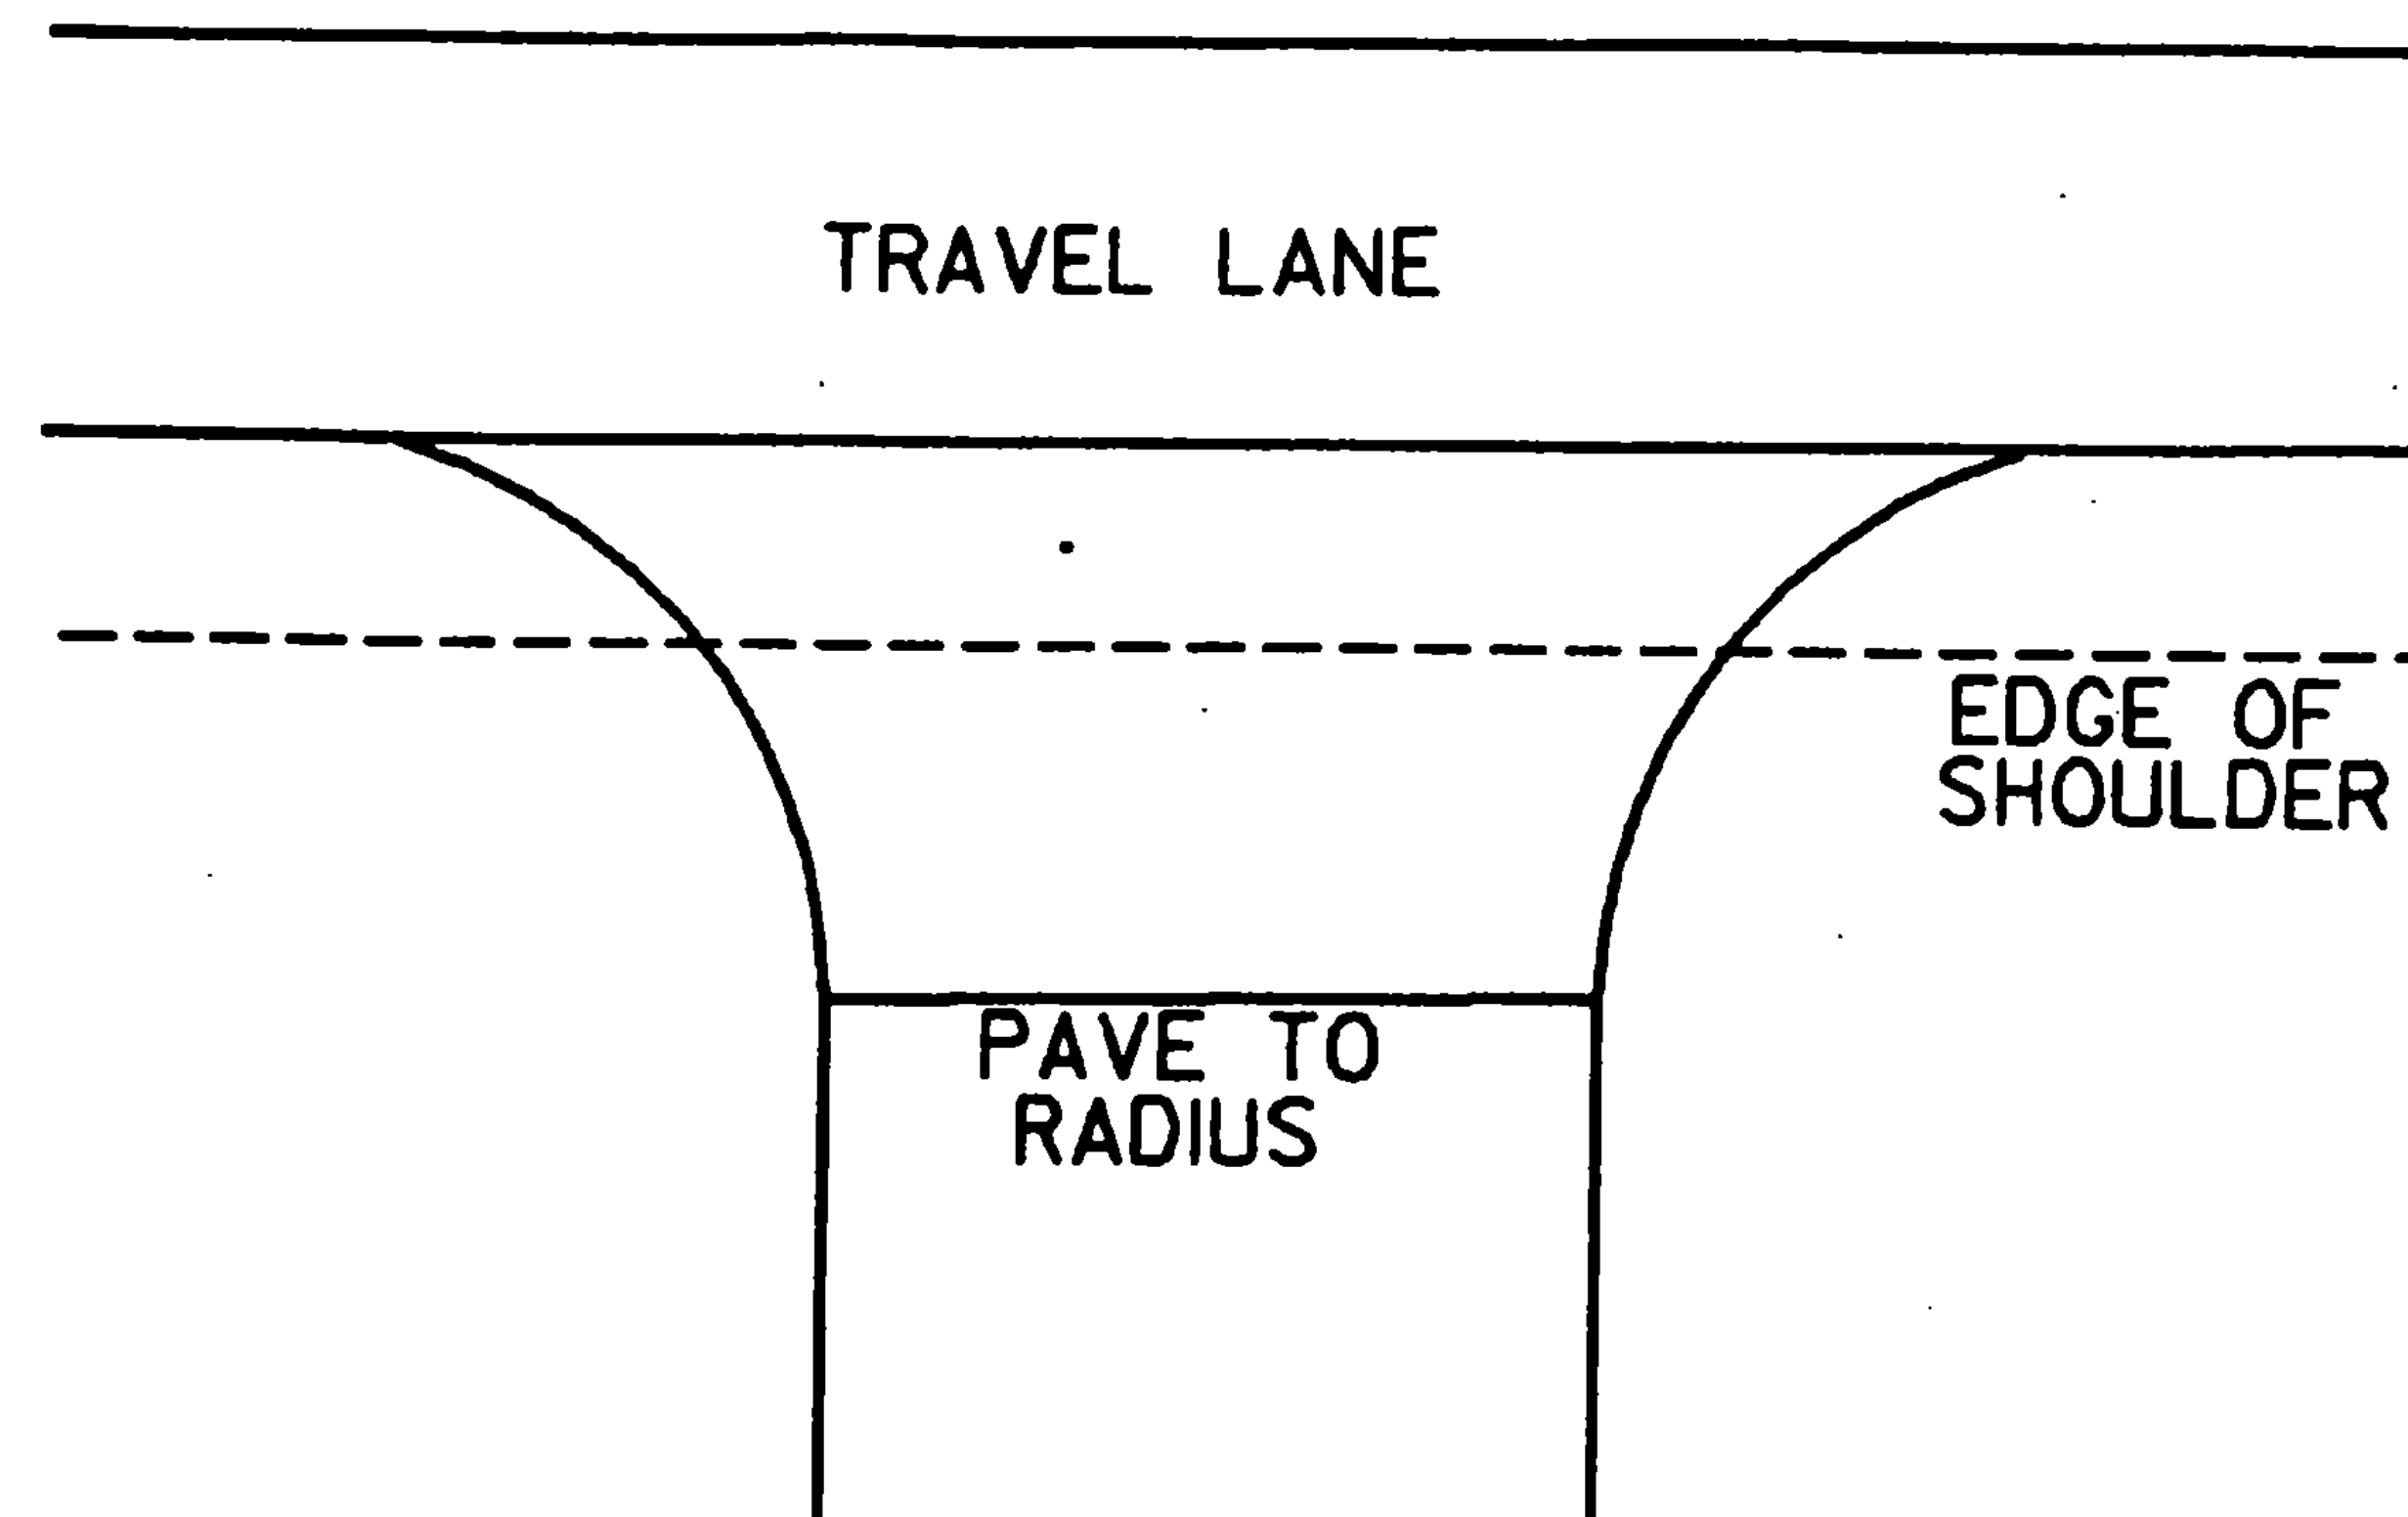

PAVING LIMITS FOR DRIVES

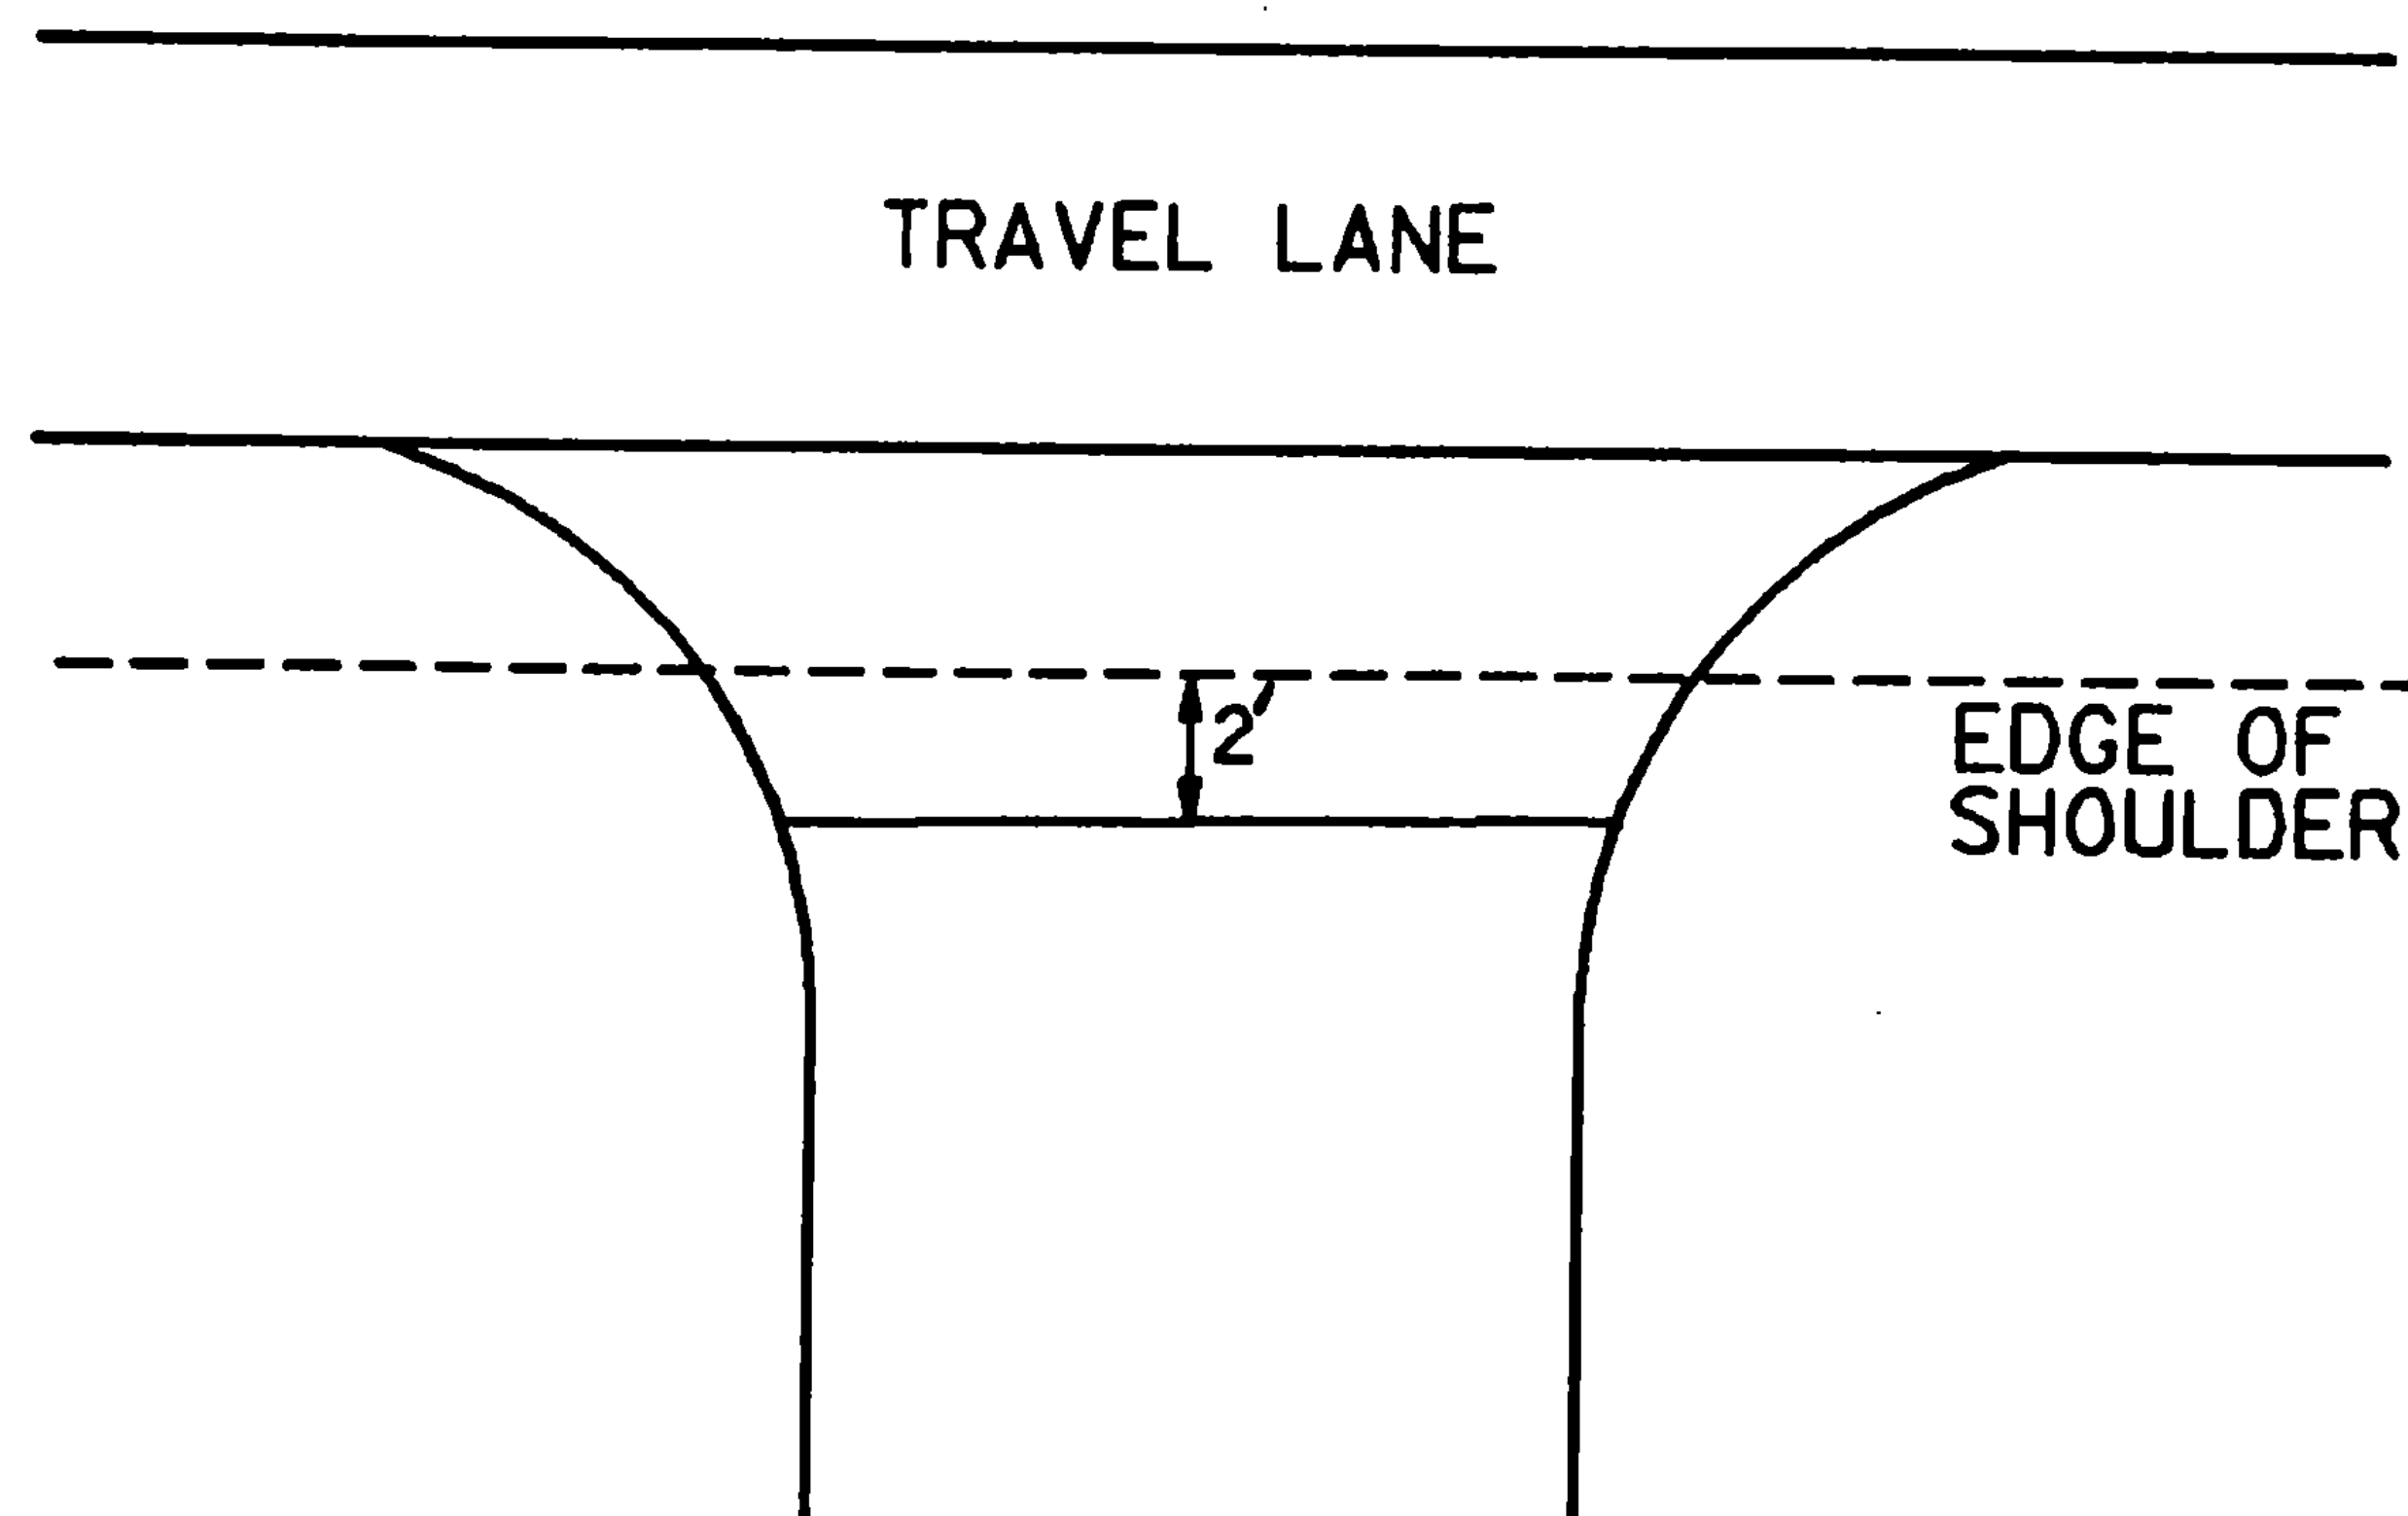

PROJECT Rochester - Hancock

NO. HMA 2828

SHEET 5 OF 10 SHEETS

SHEET 27 OF 38 SHEETS