


# PAVEMENT MARKING DETAIL SHEET

\* SEE STANDARD  
E-50 FOR  
LETTERING DIMENSIONS.

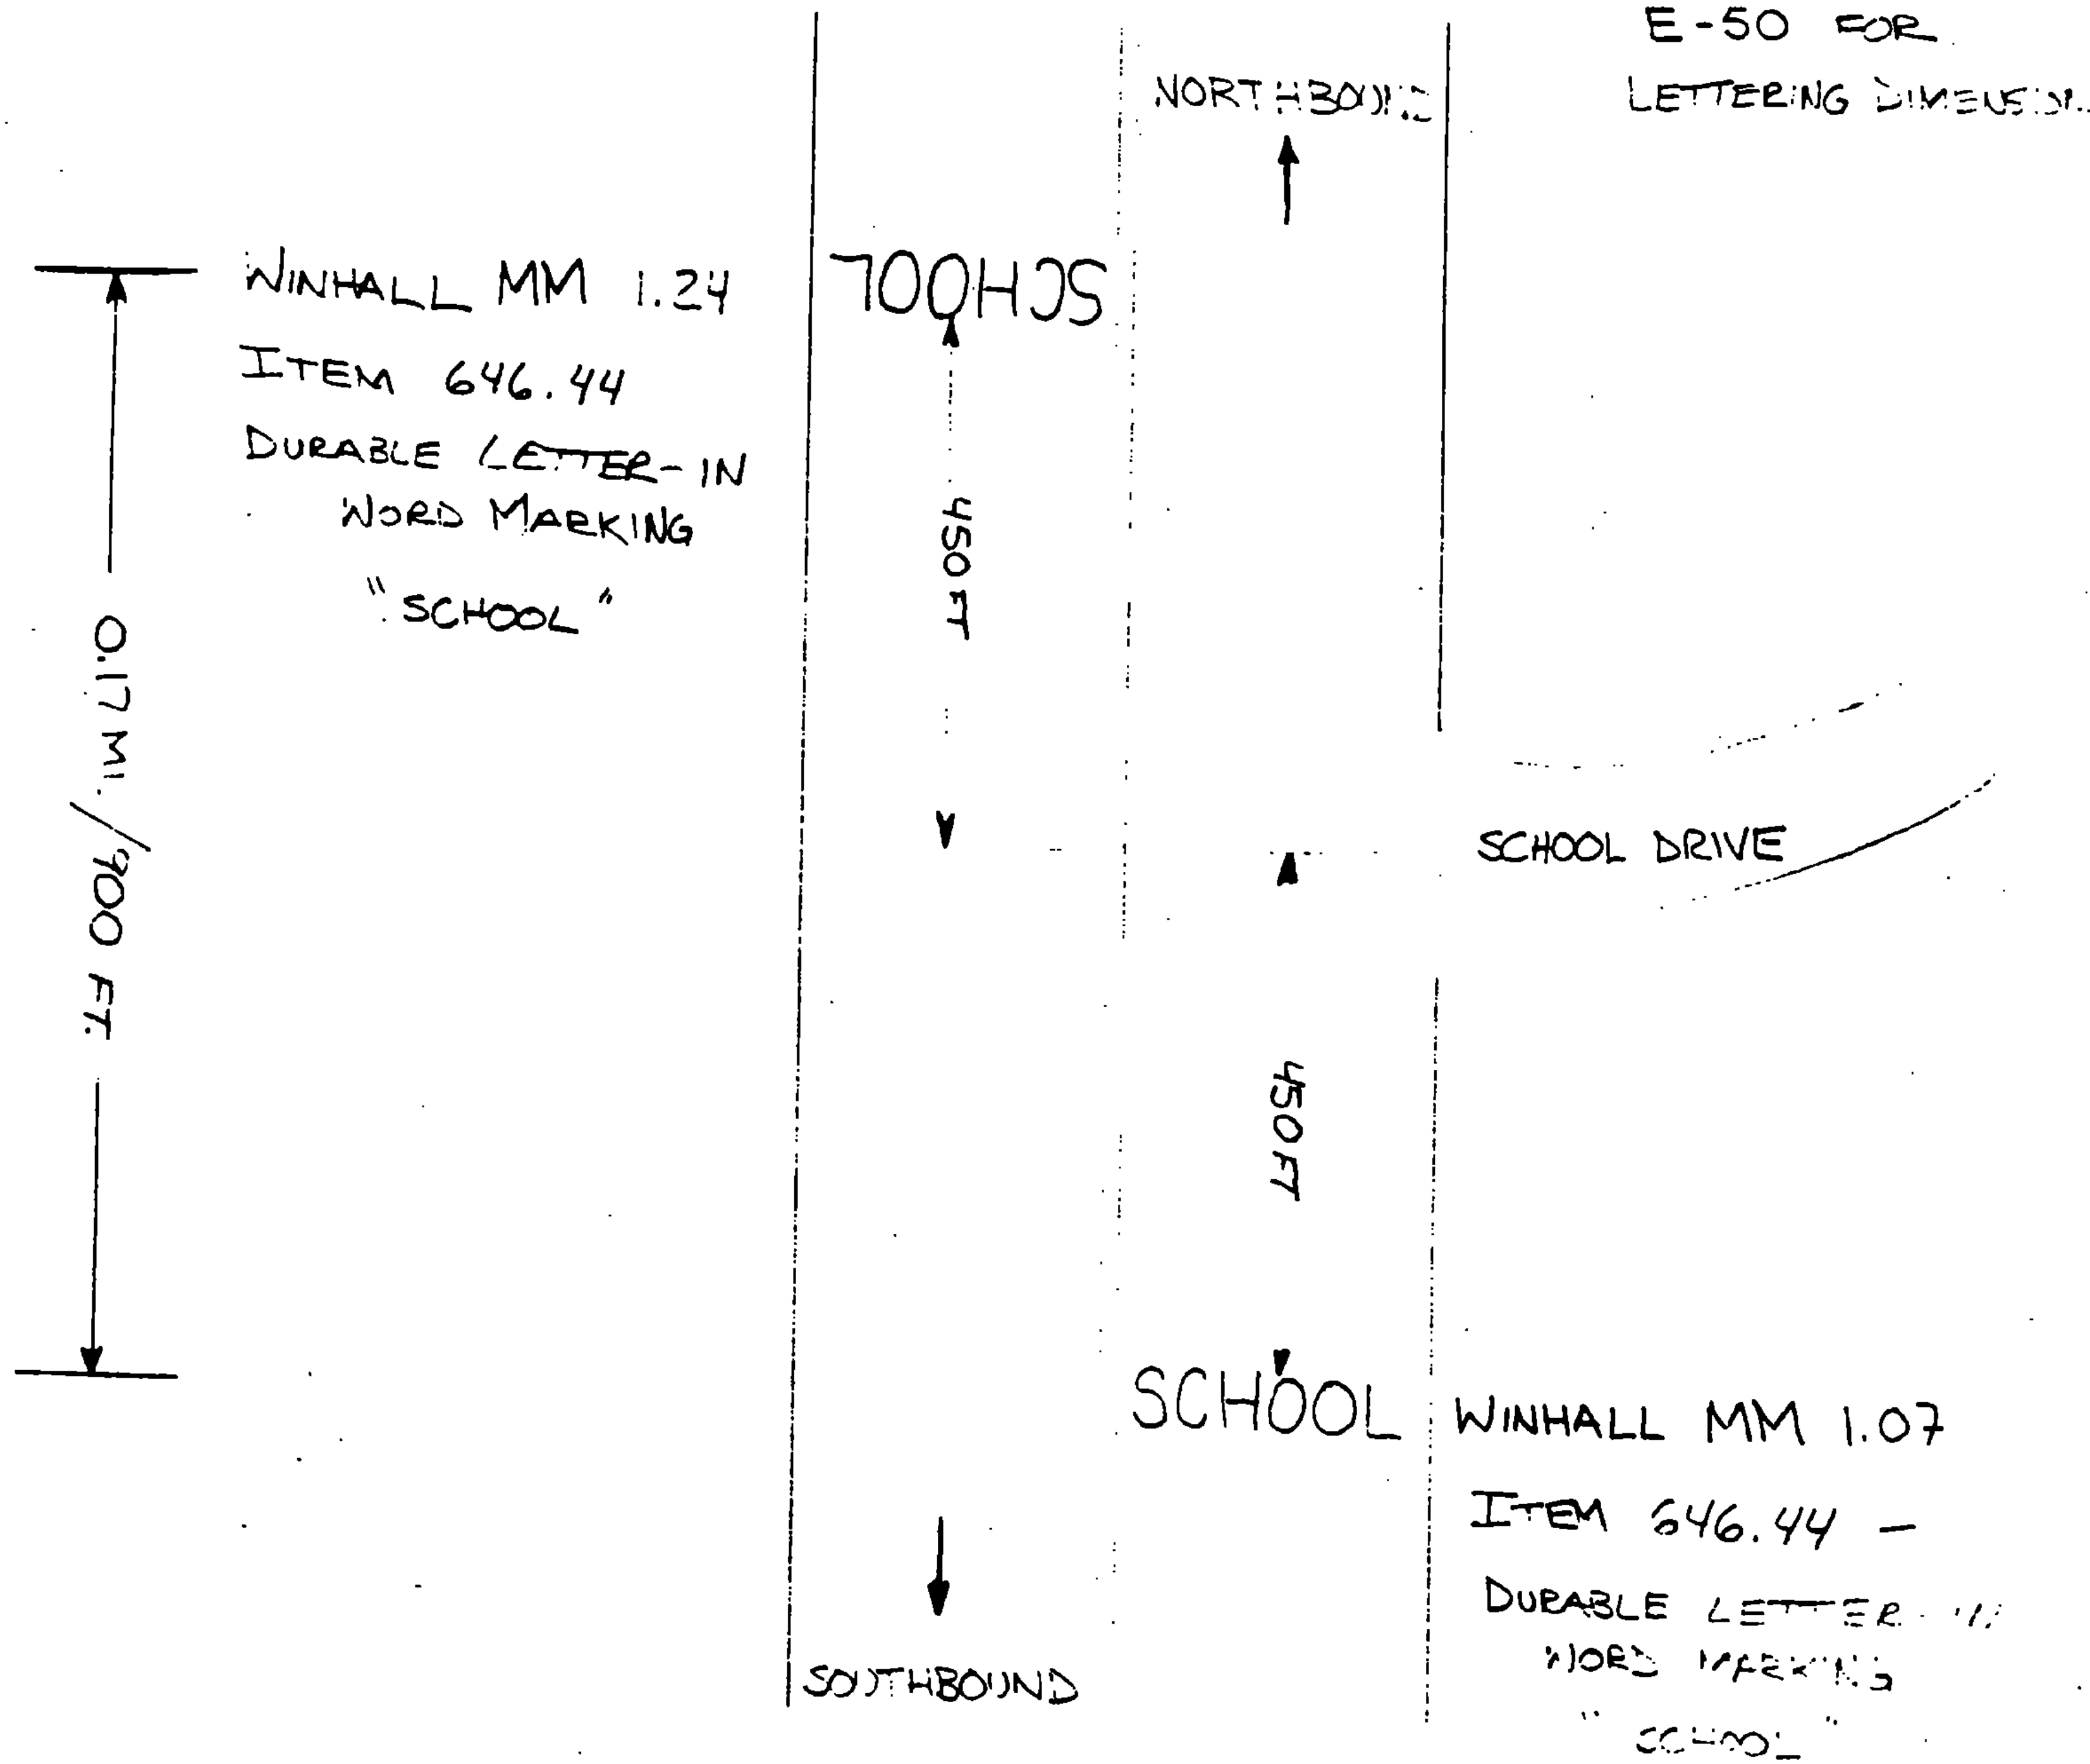

NOTE: DRAWING NOT TO SCALE

PROJECT JAMAICA - WINHALL

NO. HMA 818  
SHT. 18 OF 64 SHTS.  
SHT. 10 OF 10 SHTS.