



# TYPICAL SECTIONS & DESIGN DATA

WILMINGTON MM 1.270 ~ MM 1.978

ITEM 406.25 BITUMINOUS CONCRETE PAVEMENT  
LEVELING COURSE TYPE IV (395 TONS/MILE )  
1 1/4" WEARING COURSE TYPE III (± 1/4")

AS DIRECTED BY THE ENGINEER

NOTE: DESIGNED PAVED SHOULDER IS 2' WIDE  
EXISTING PAVED SHOULDER IS 1' WIDE.

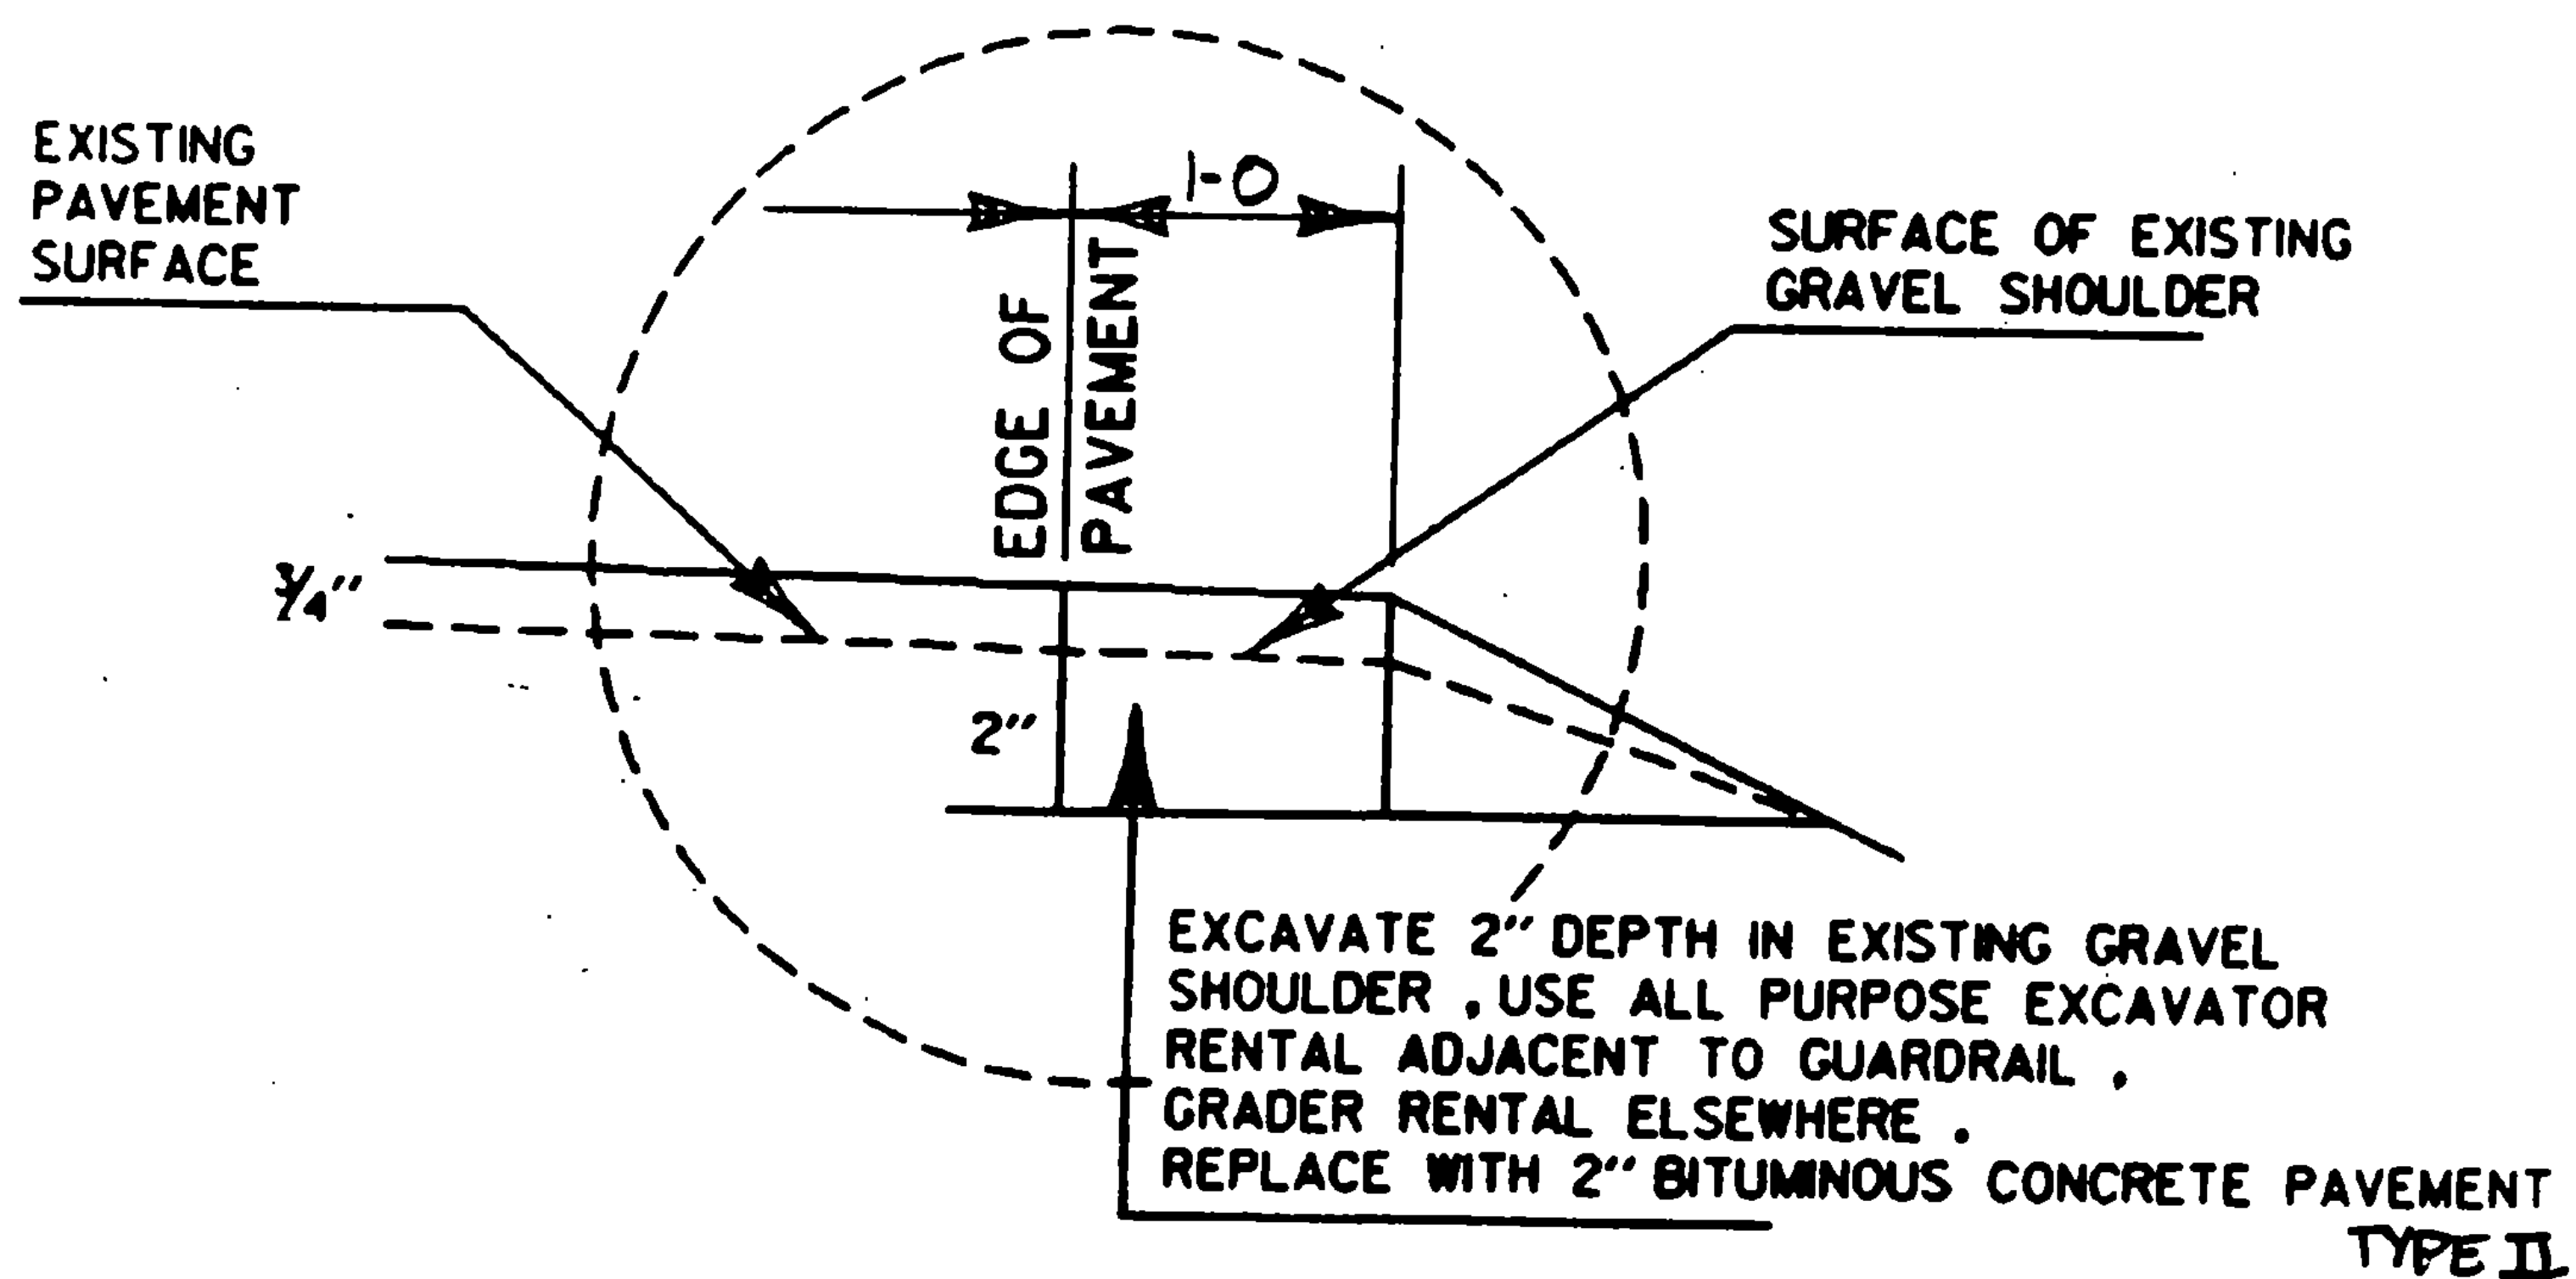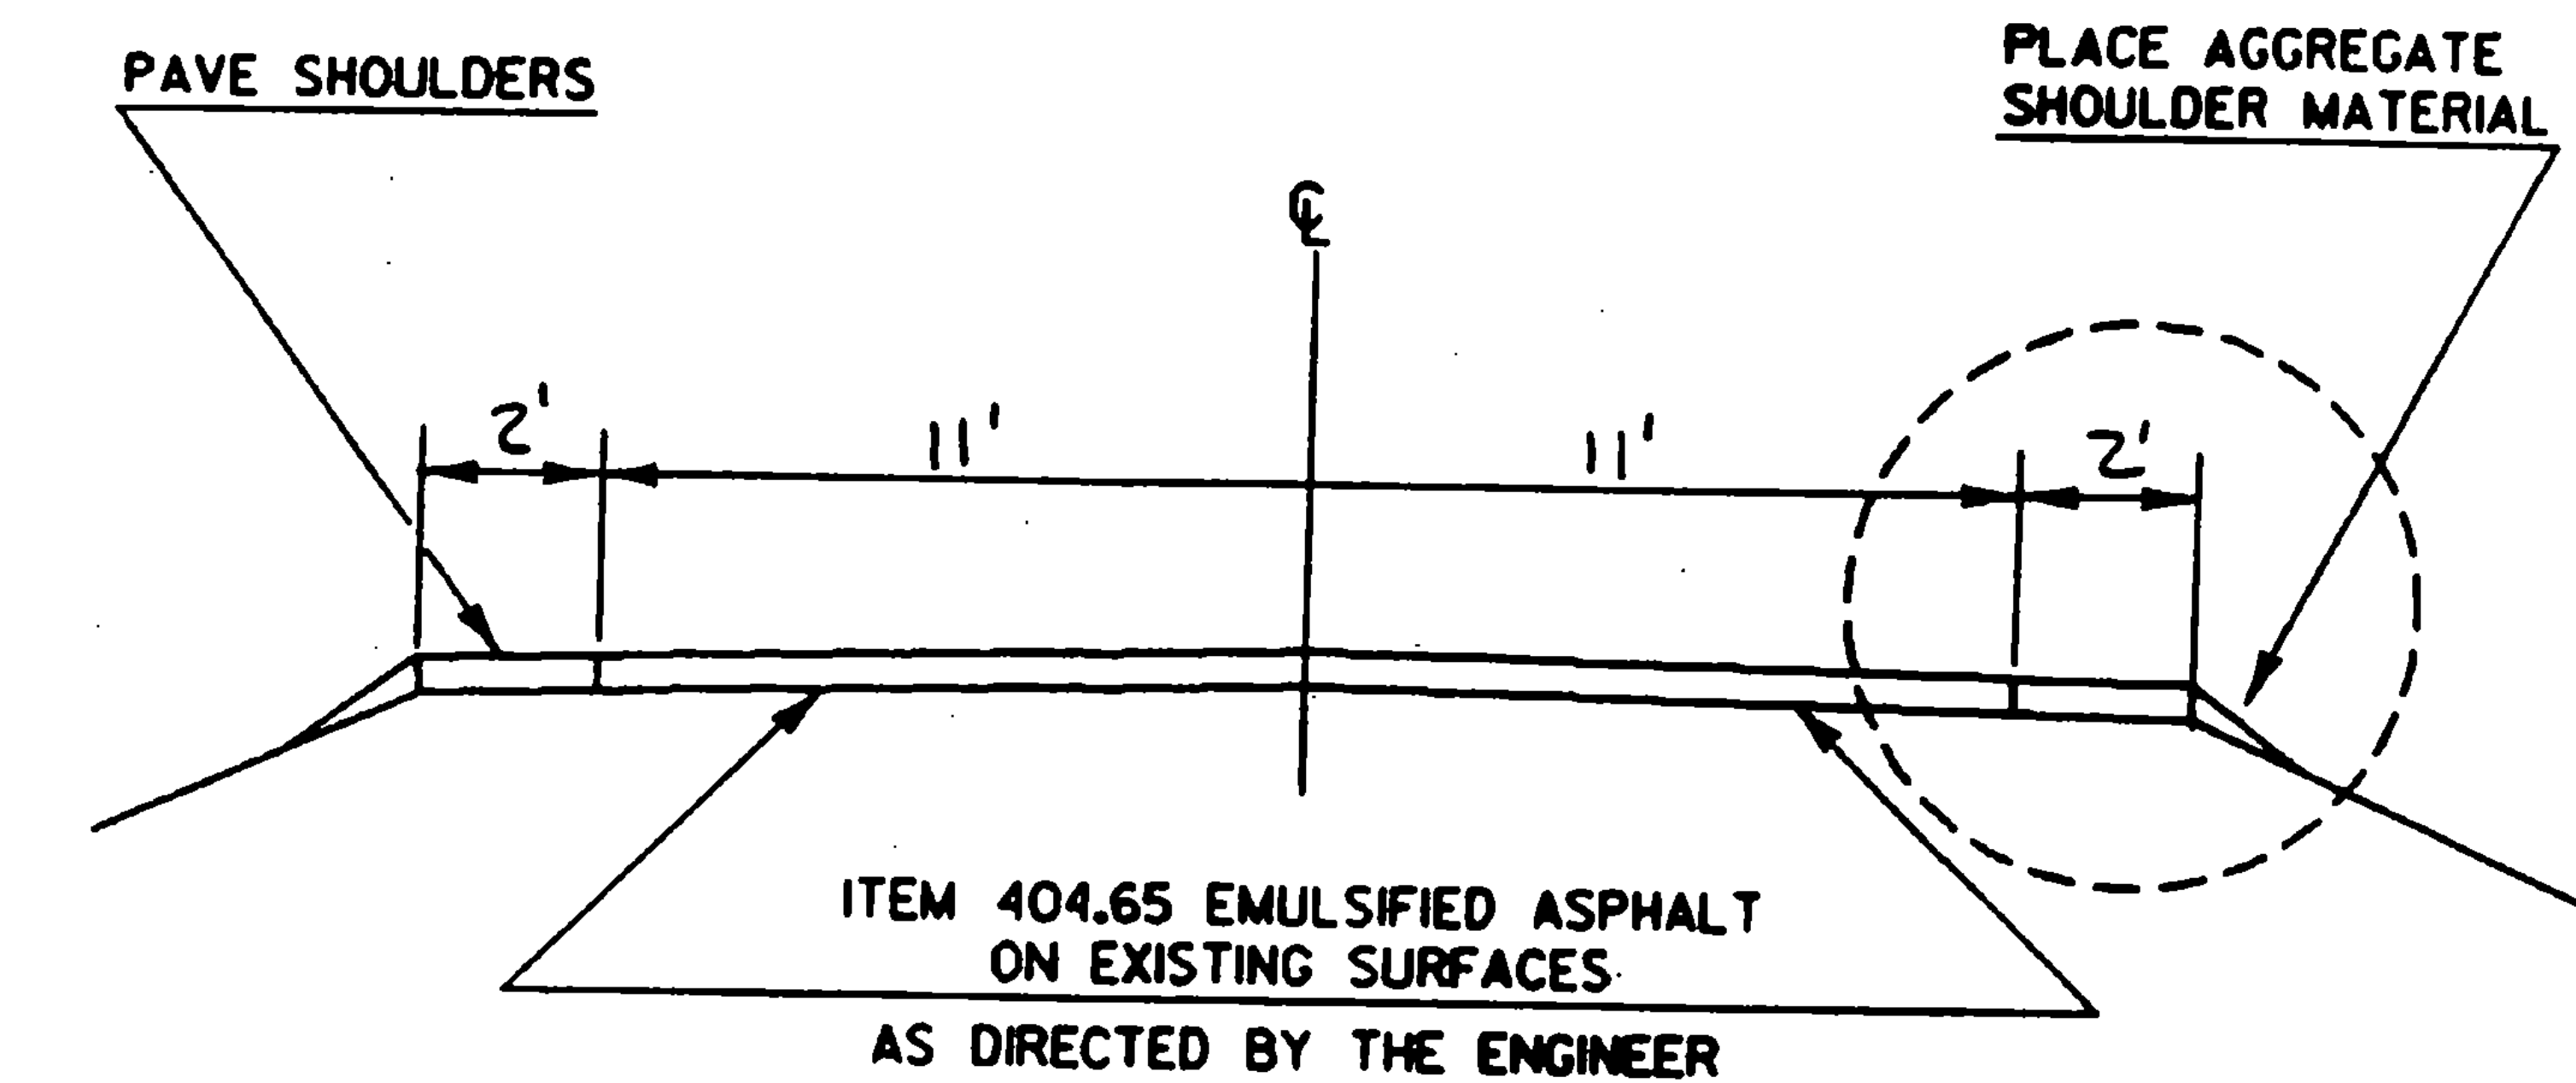

PROJECT WILMINGTON

NO. HMA 2830

SHEET 4 OF 7 SHEETS

SHT 33 OF 64 SHTS.