
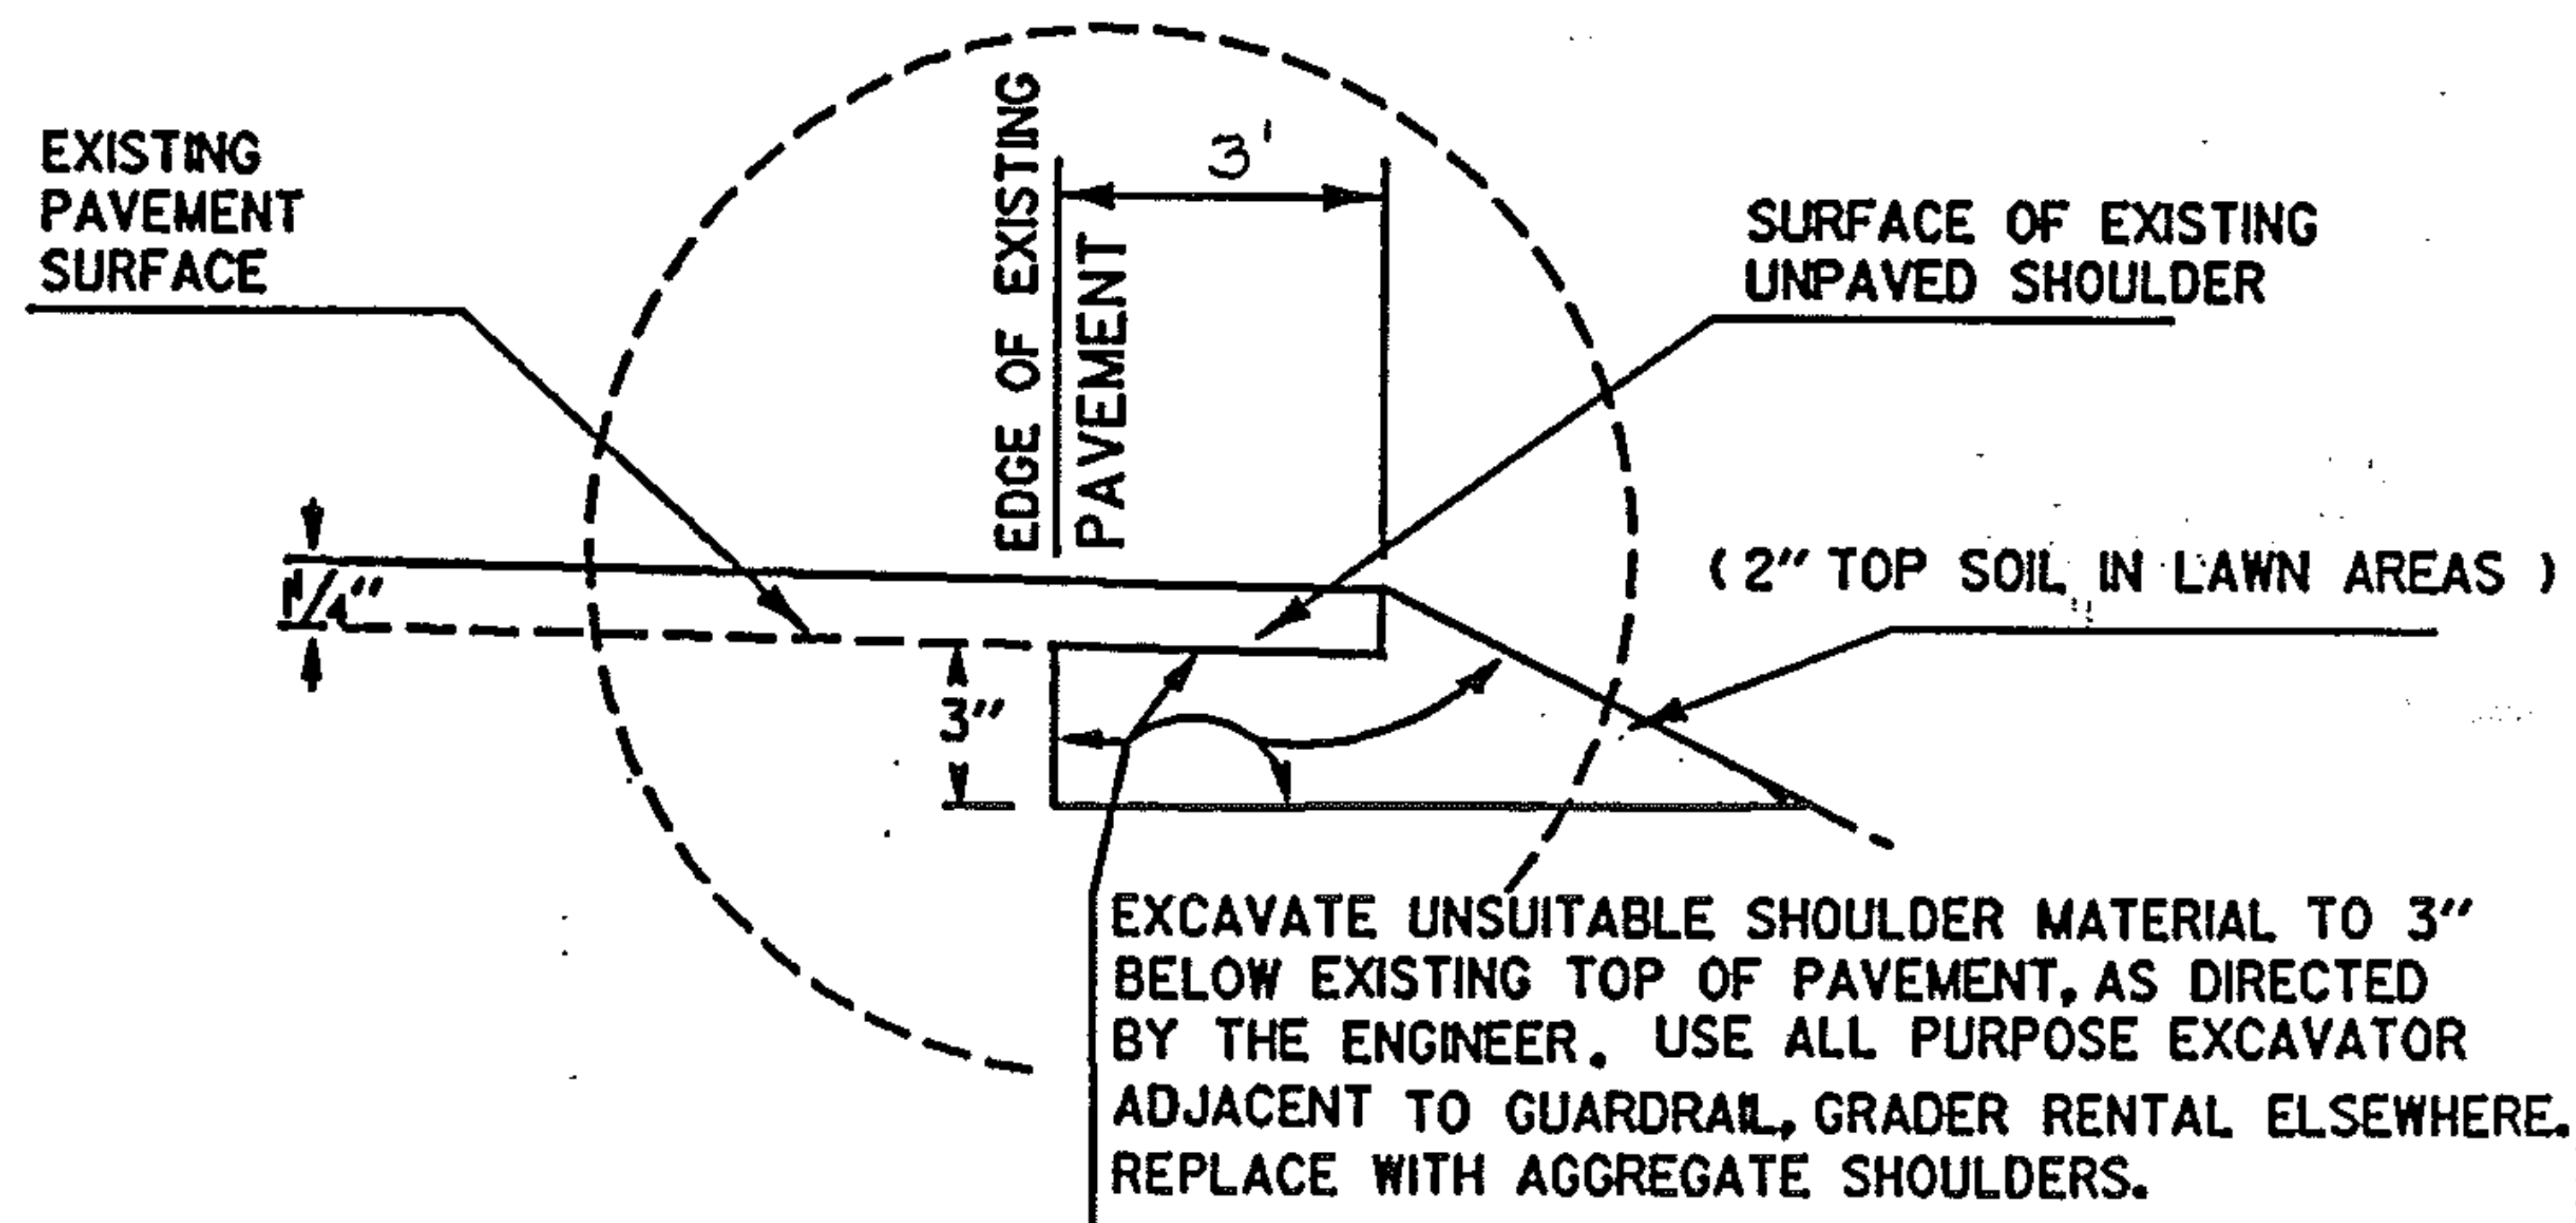


TYPICAL SECTIONS & DESIGN DATA

ITEM 406.25 BITUMINOUS CONCRETE PAVEMENT
 AGGREGATE SHOULDERS ($\pm 1/2''$)
 LEVELING COURSE TYPE IV (250 TONS/MILE)
 1 1/4" WEARING COURSE TYPE III ($\pm 1/4''$)
 AS DIRECTED BY THE ENGINEER

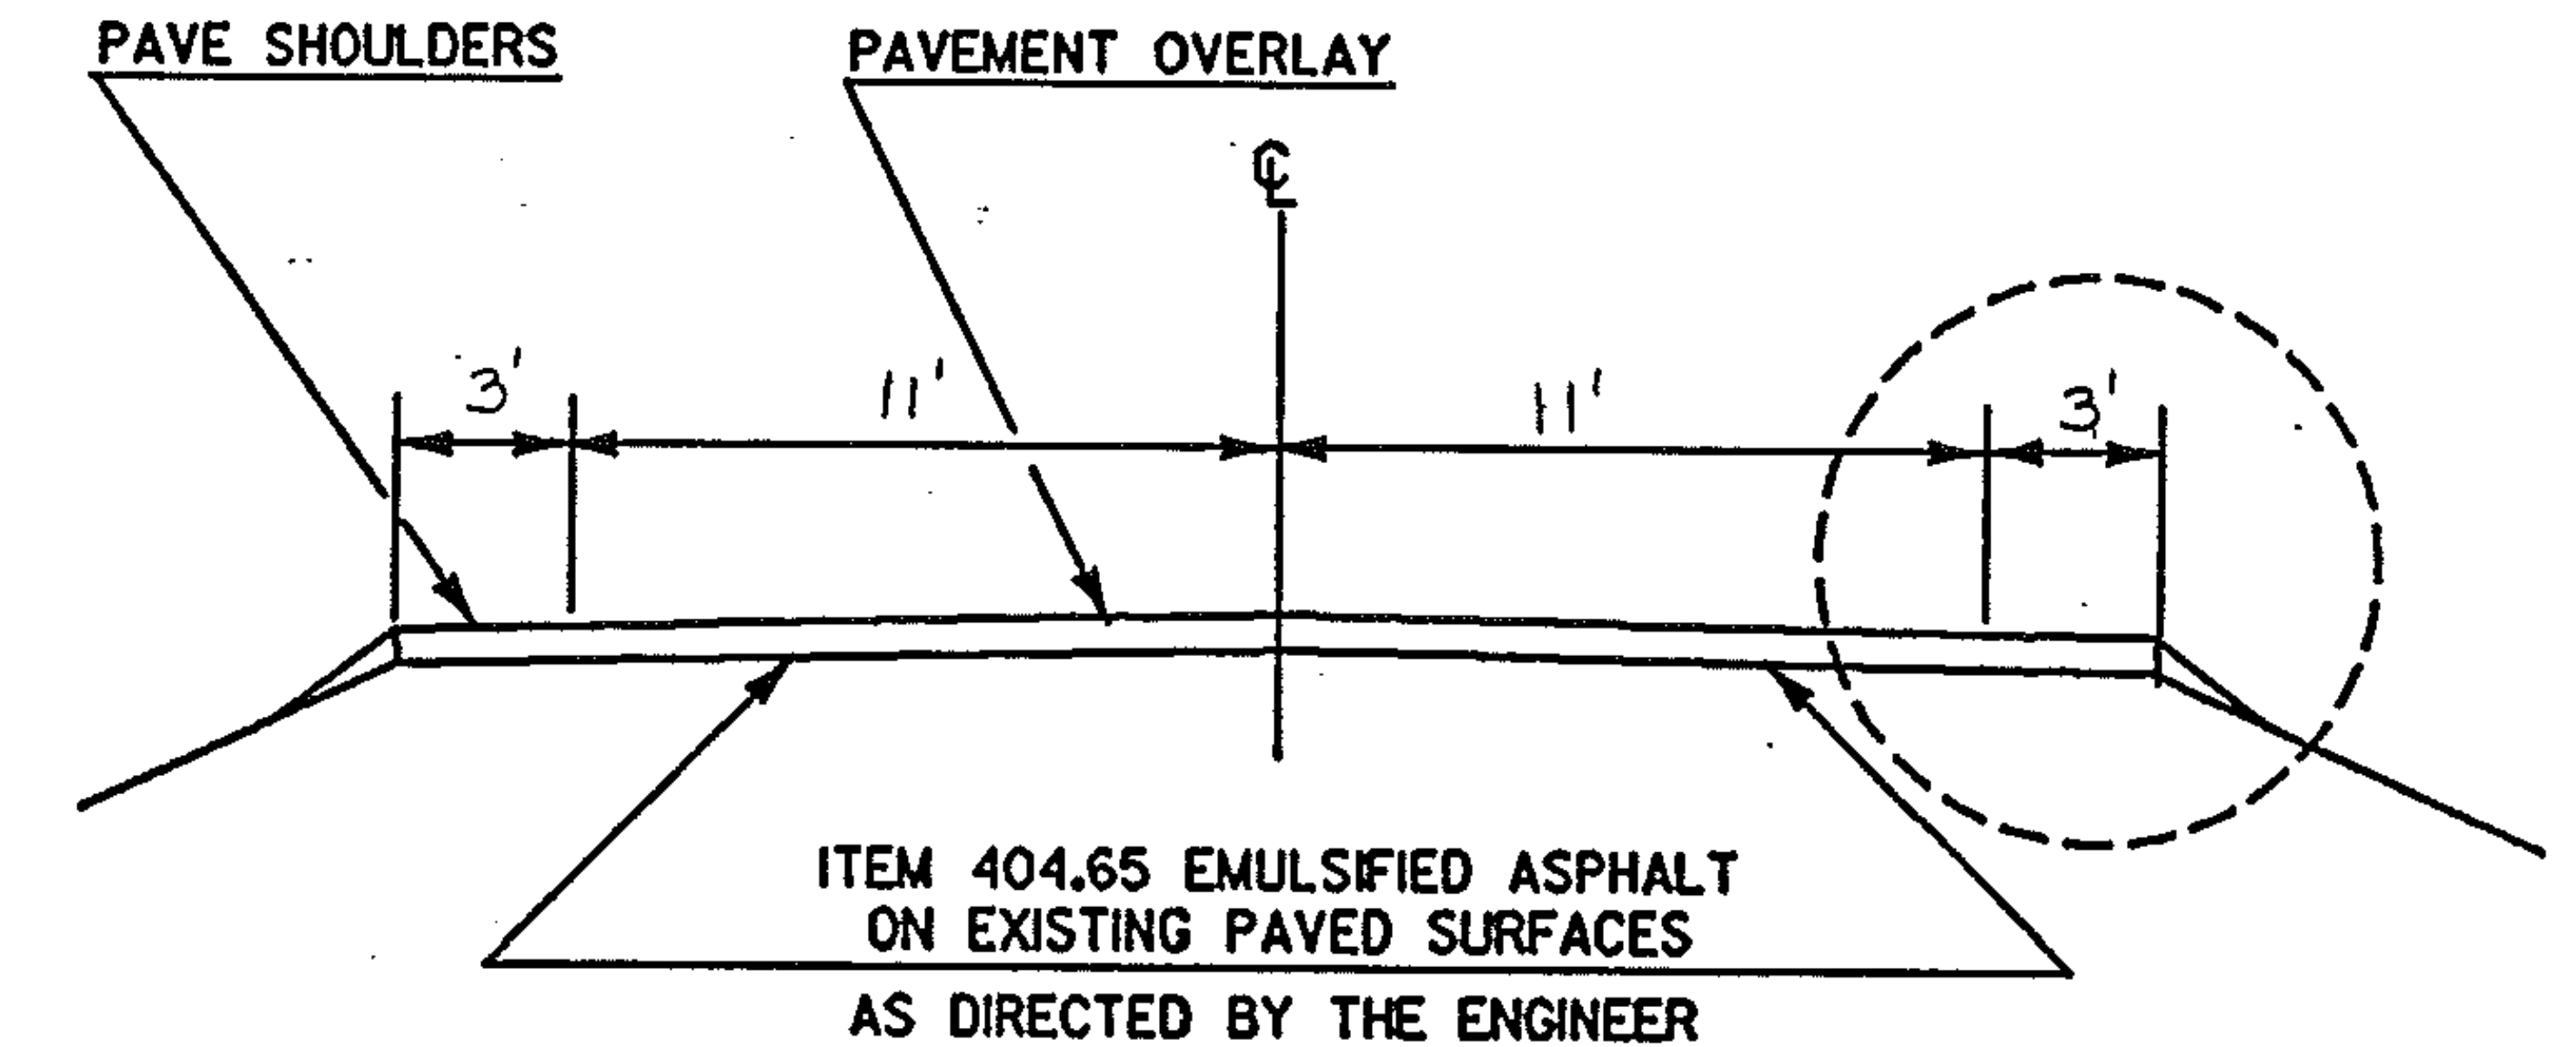

PROJECT MONTGOMERY - BERKSHIRE

NO. HMA 2863

SHEET 14 OF 26 SHEETS