


DESCRIPTION AND LOCATION

PROJECT LENGTH: 2.100 MILES, 11,088. FEET
1986 A.D.T.: 2660

BEGINNING IN THE TOWN OF STOWE
ON VT. 108 AT M.M. 5.537 AND EXTEND-
ING NORTHERLY 2.100 MILES TO
M.M. 7.637. RESURFACING OF THE HIGHWAY
AND ITS APPROACHES, NEW PAVEMENT
MARKINGS.

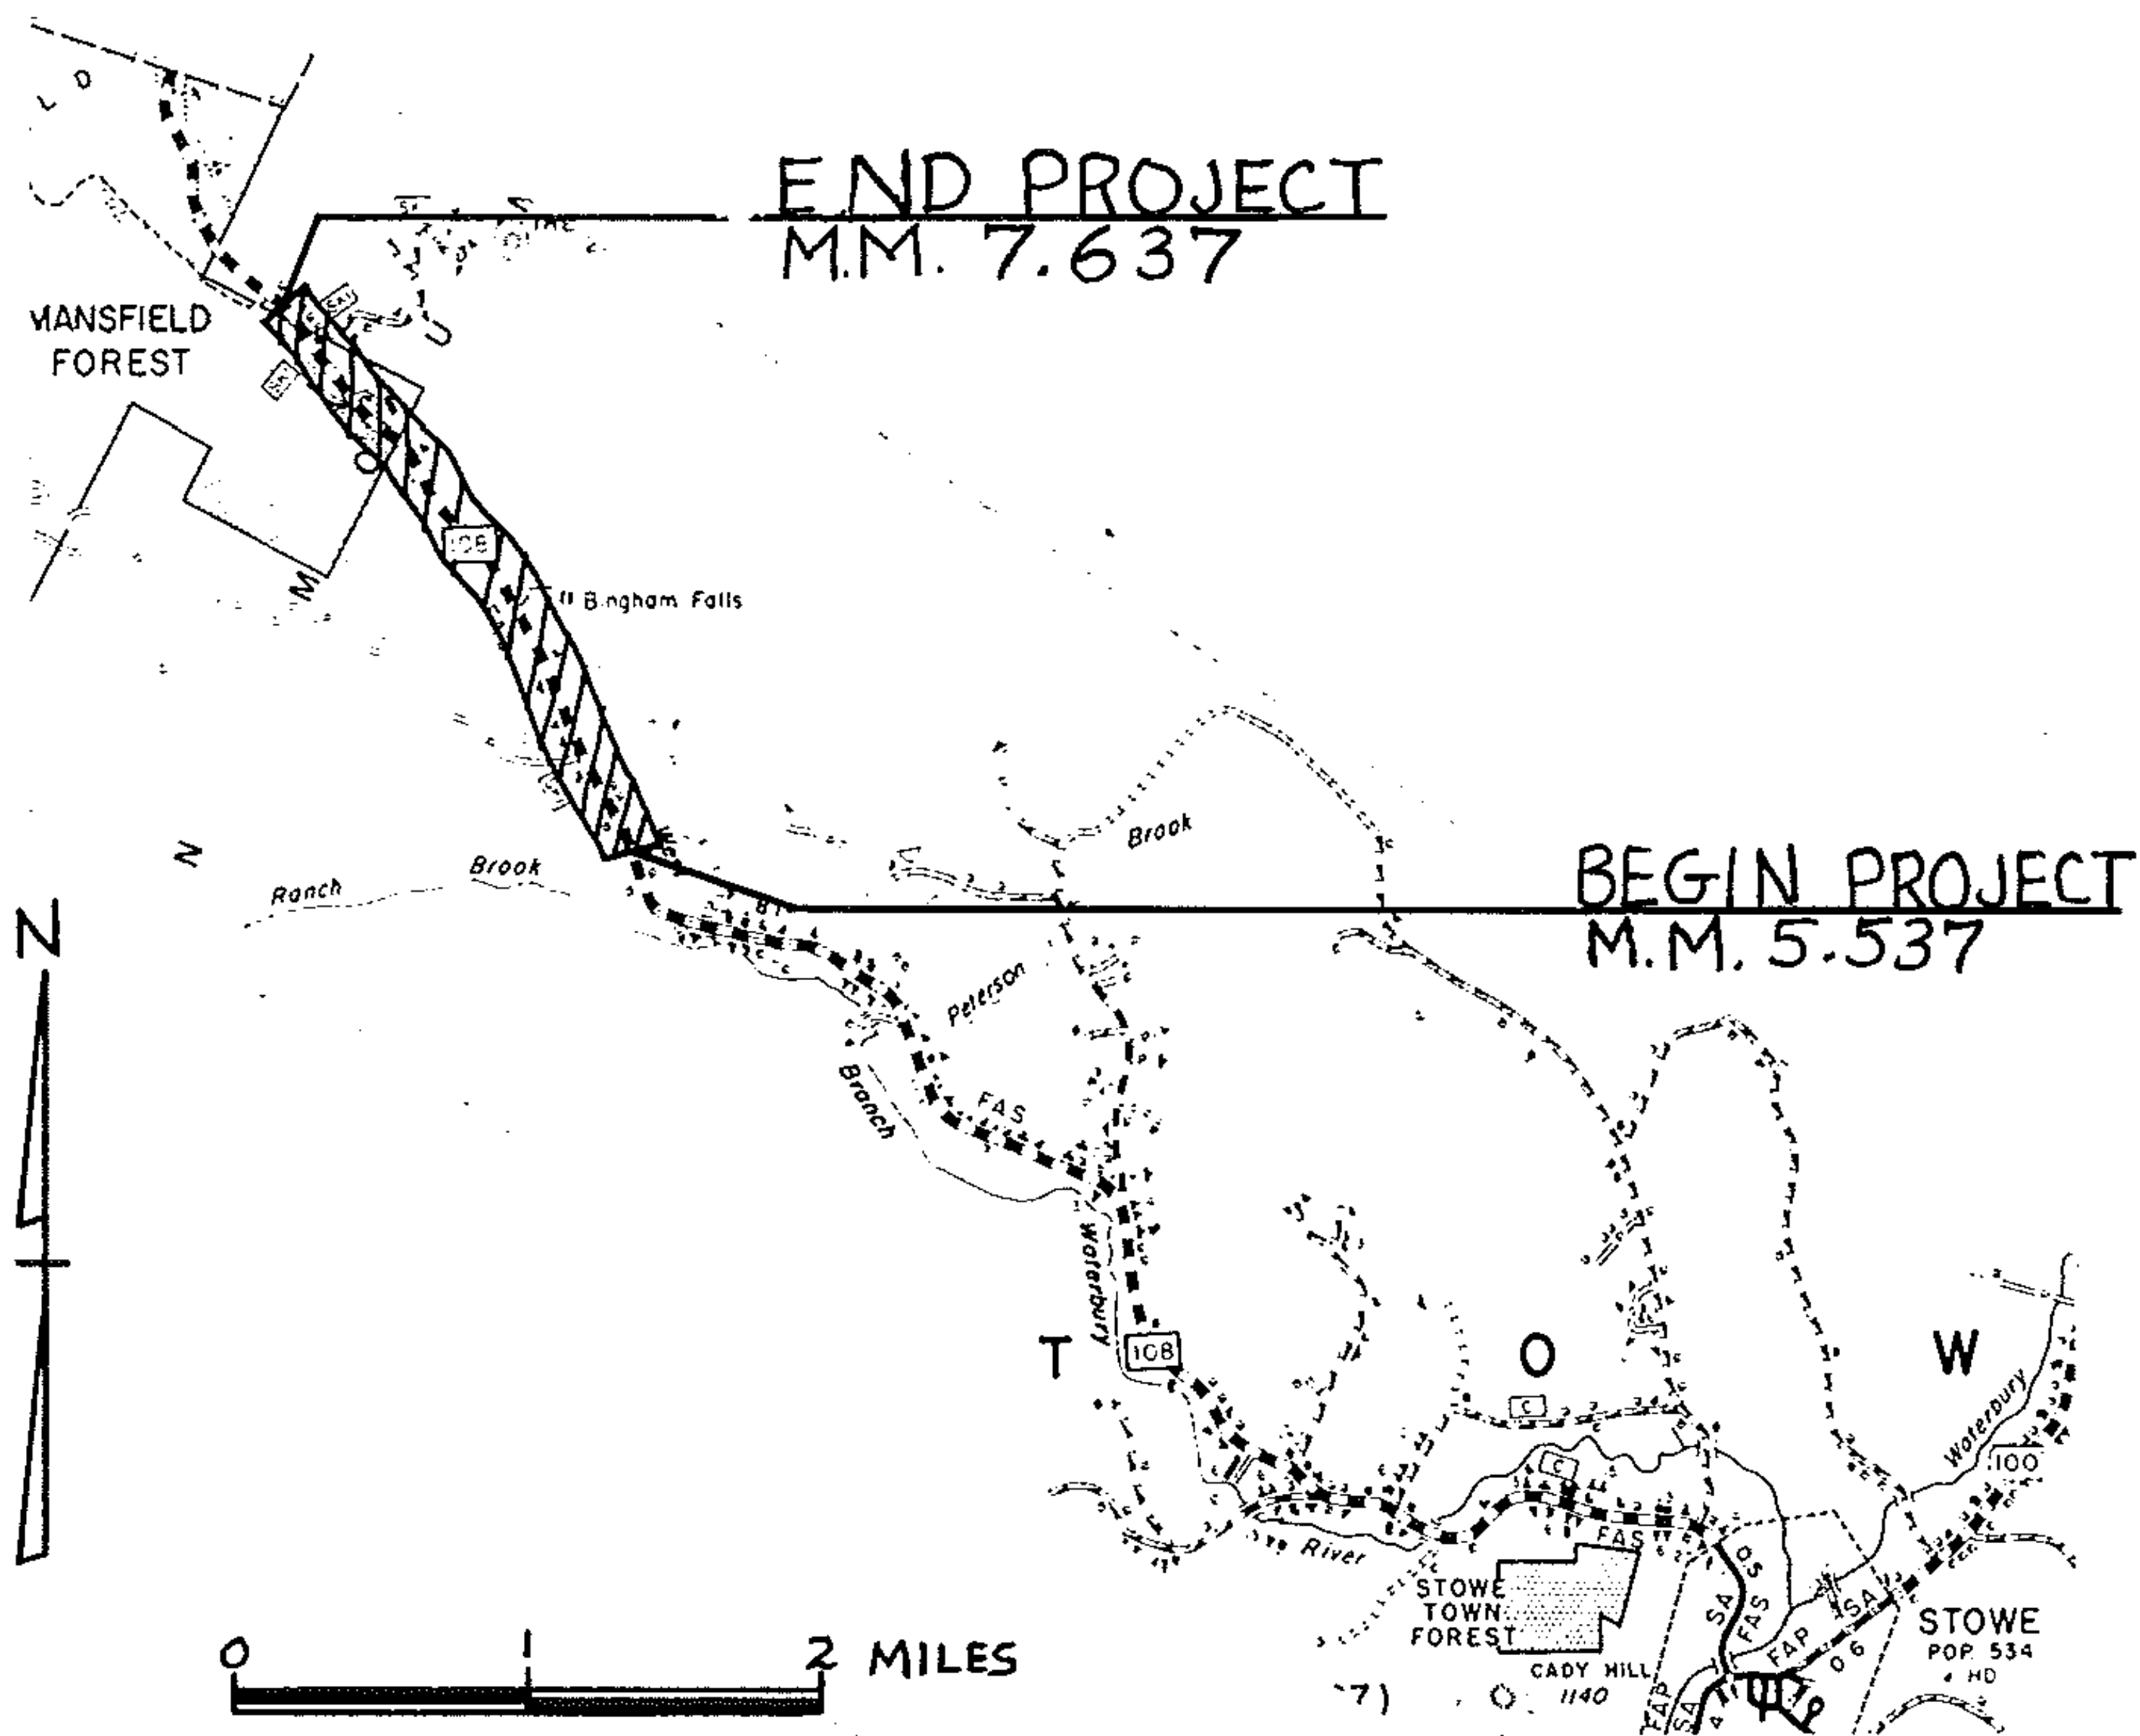

PROJECT STOWE

NO. HMA 2865

SHEET 24 OF 30 SHEETS