



PAVING LIMITS FOR TOWN ROADS & DRIVES

PAVING LIMITS FOR TOWN ROADS

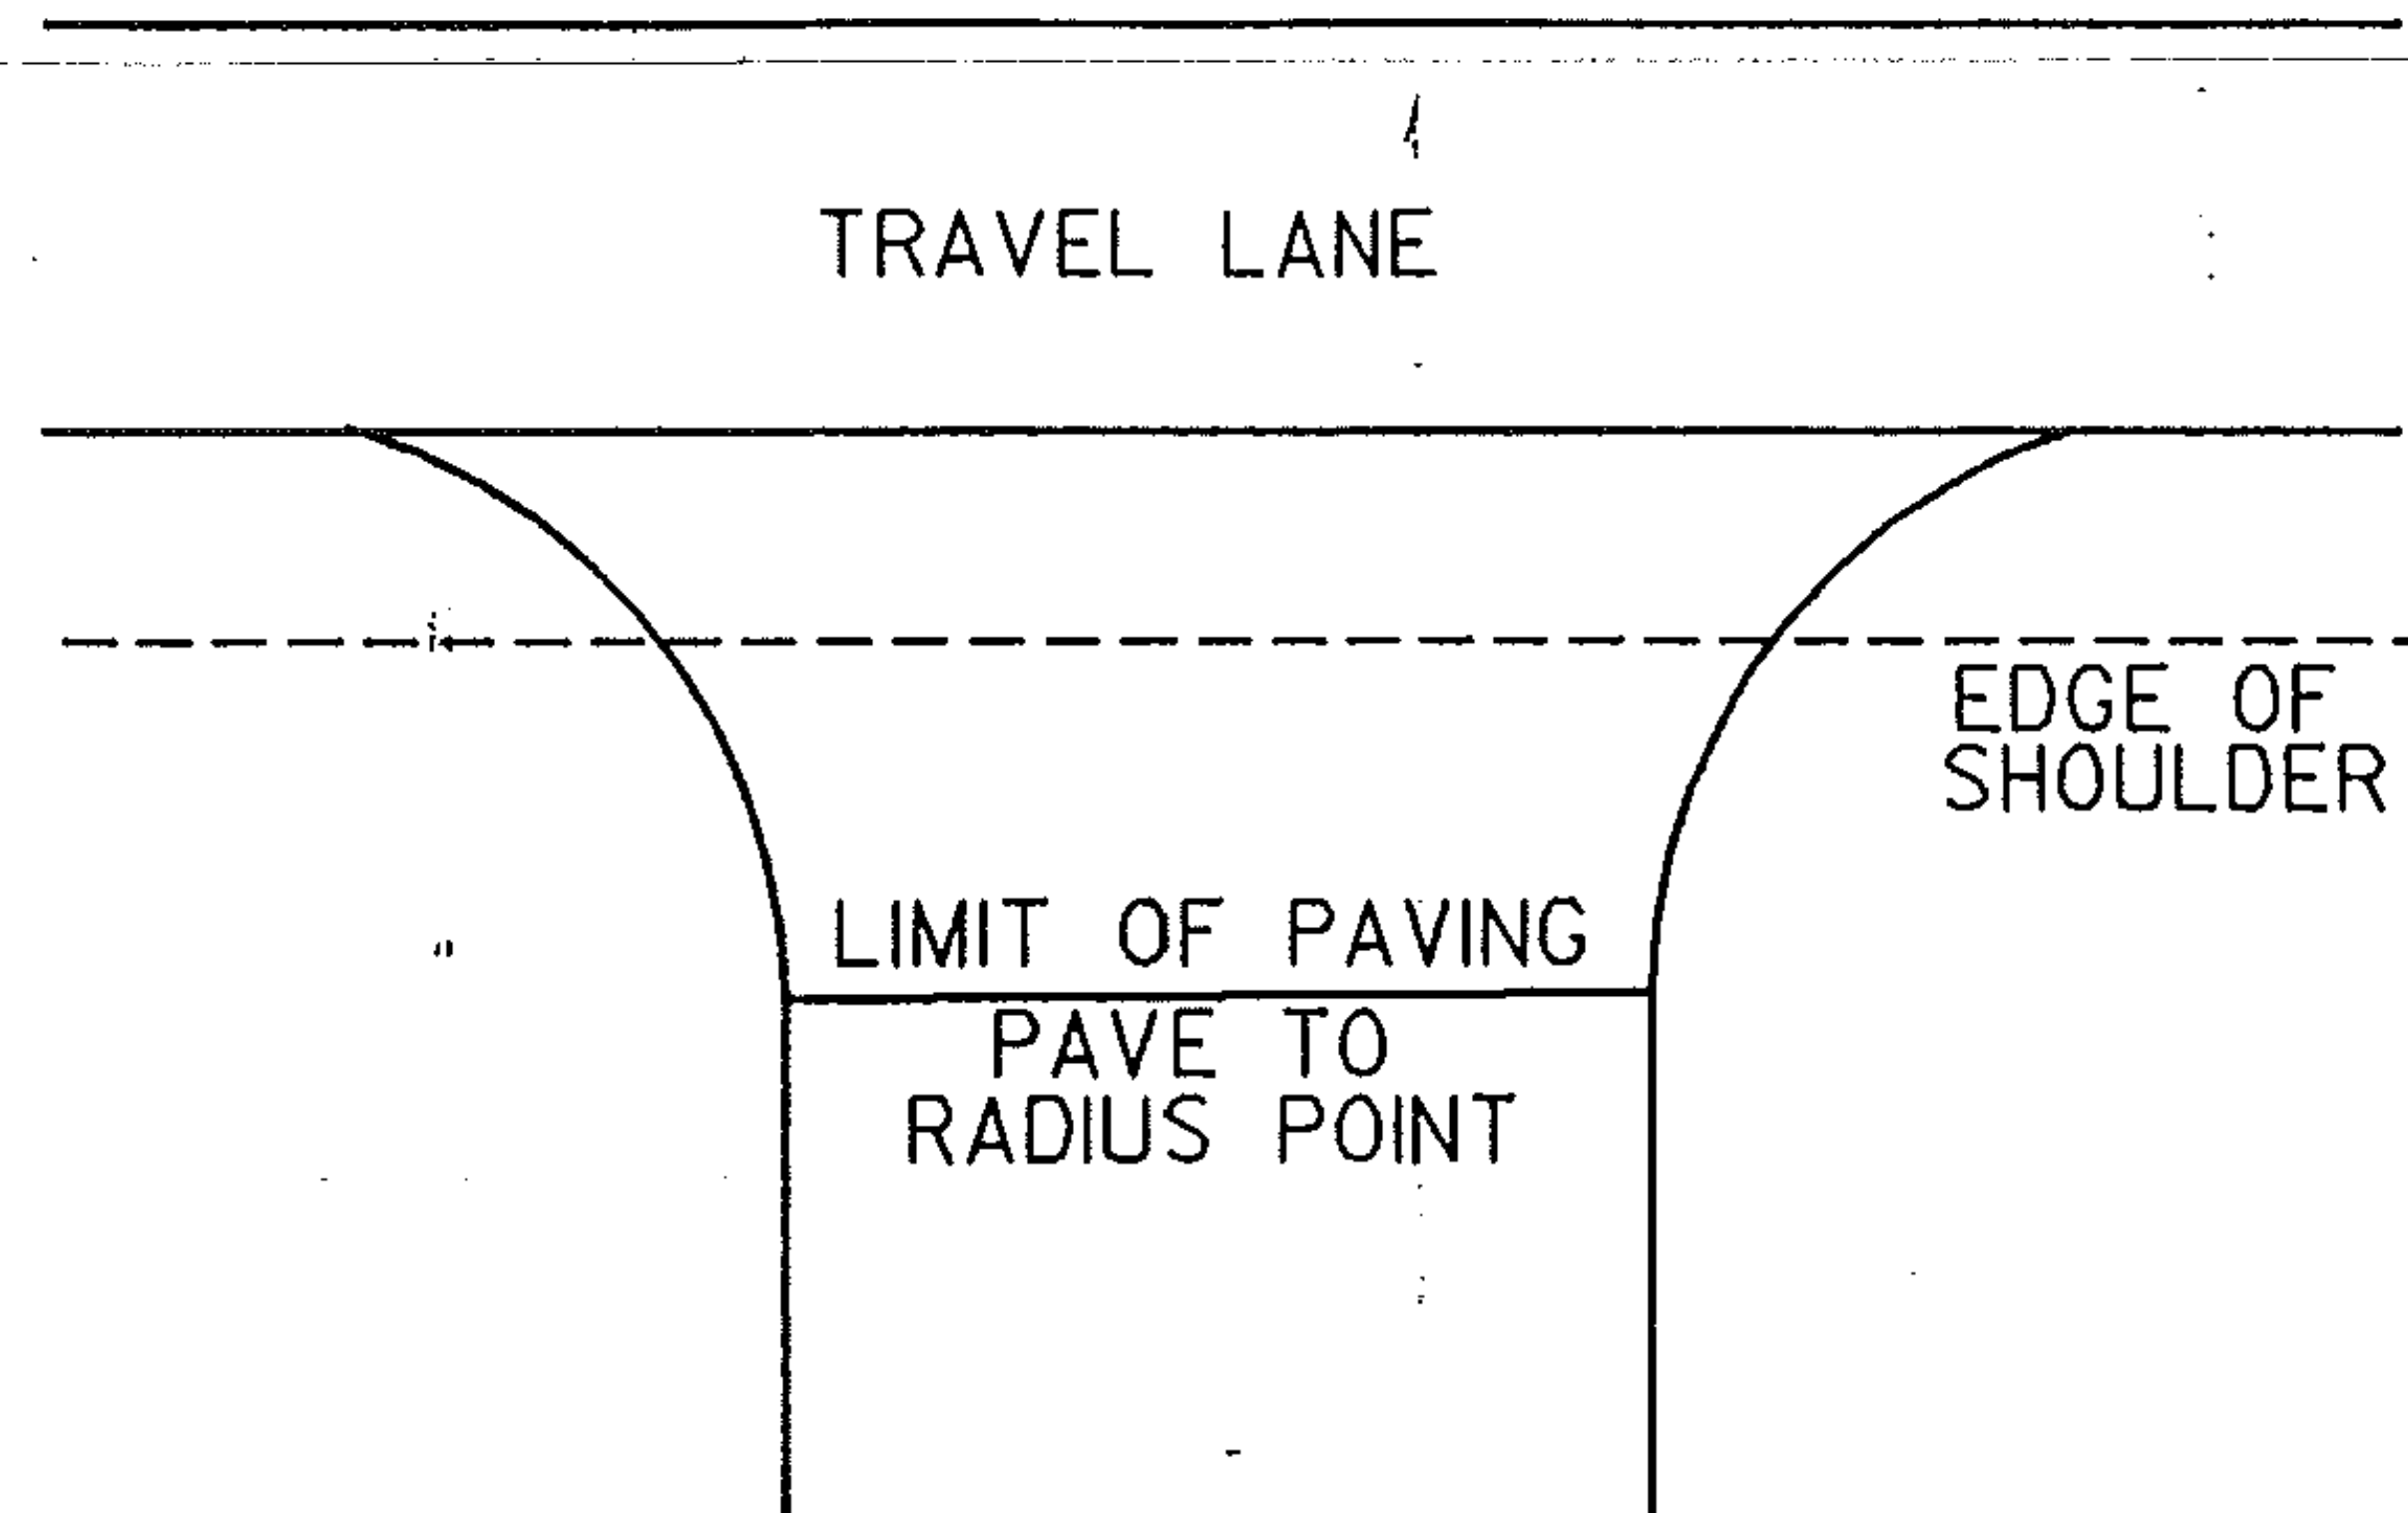

PAVING LIMITS FOR DRIVES

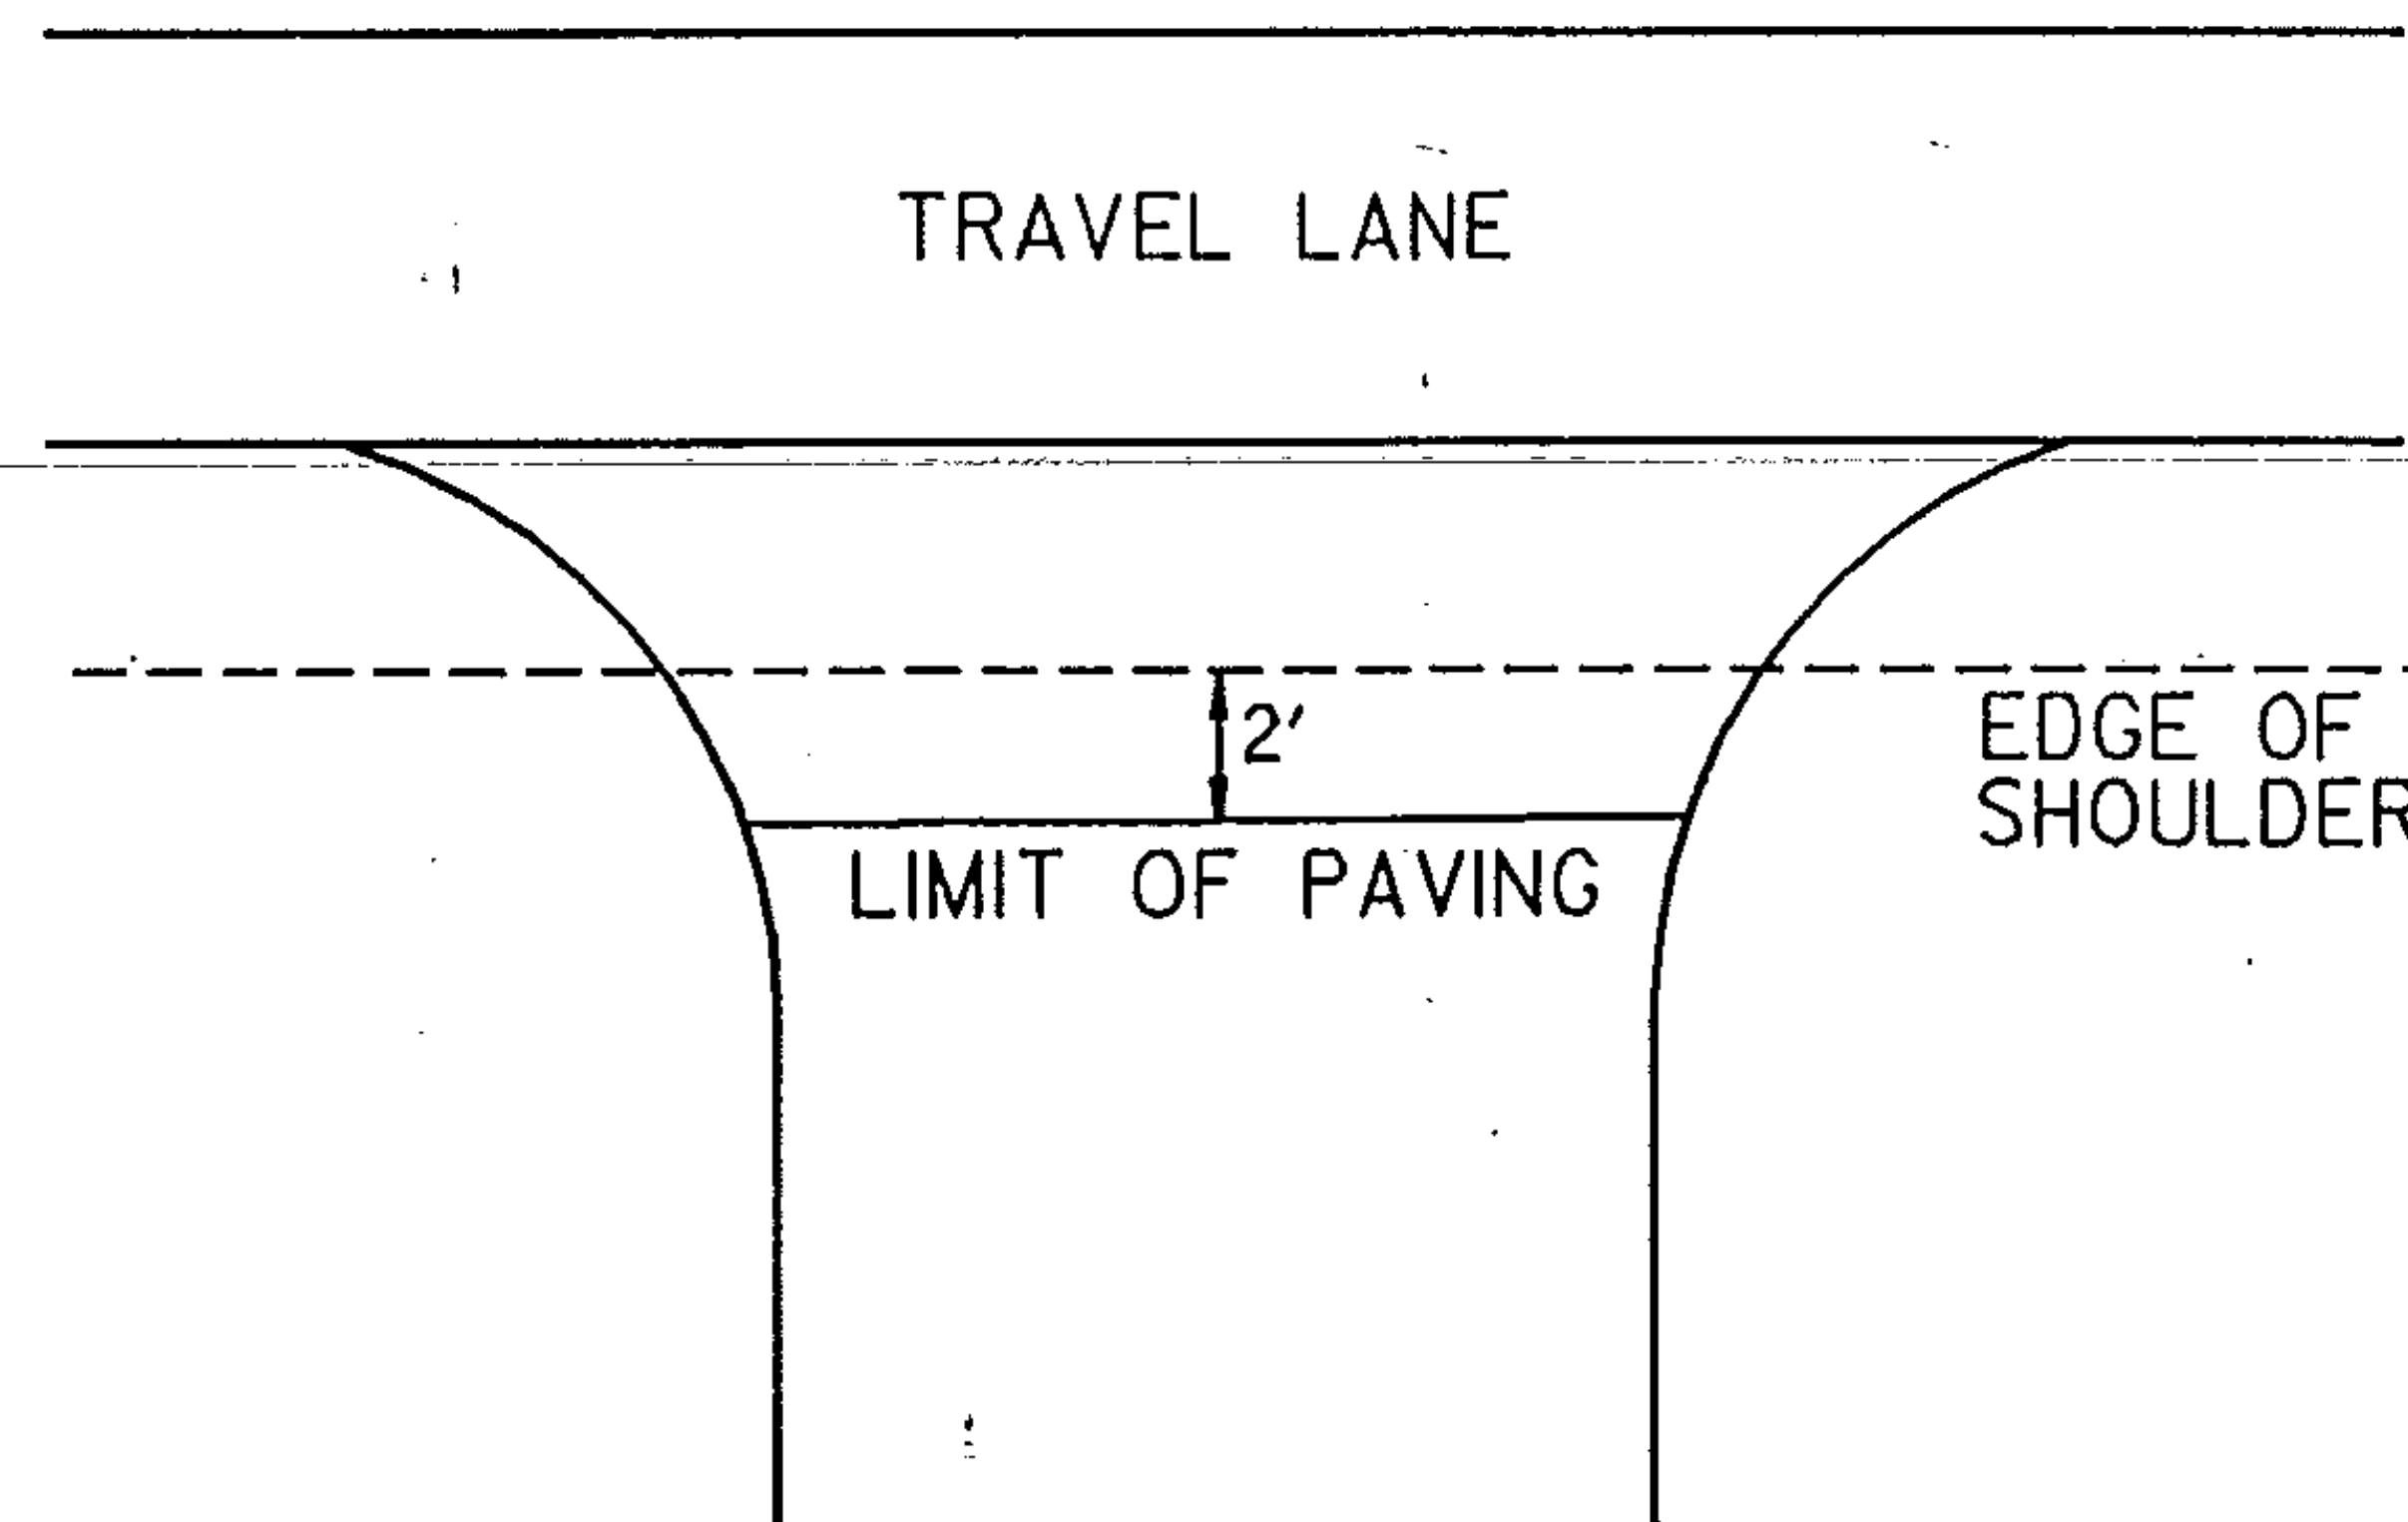

PROJECT STOWE

NO. HMA 2865

SHEET 26 OF 30 SHEETS