
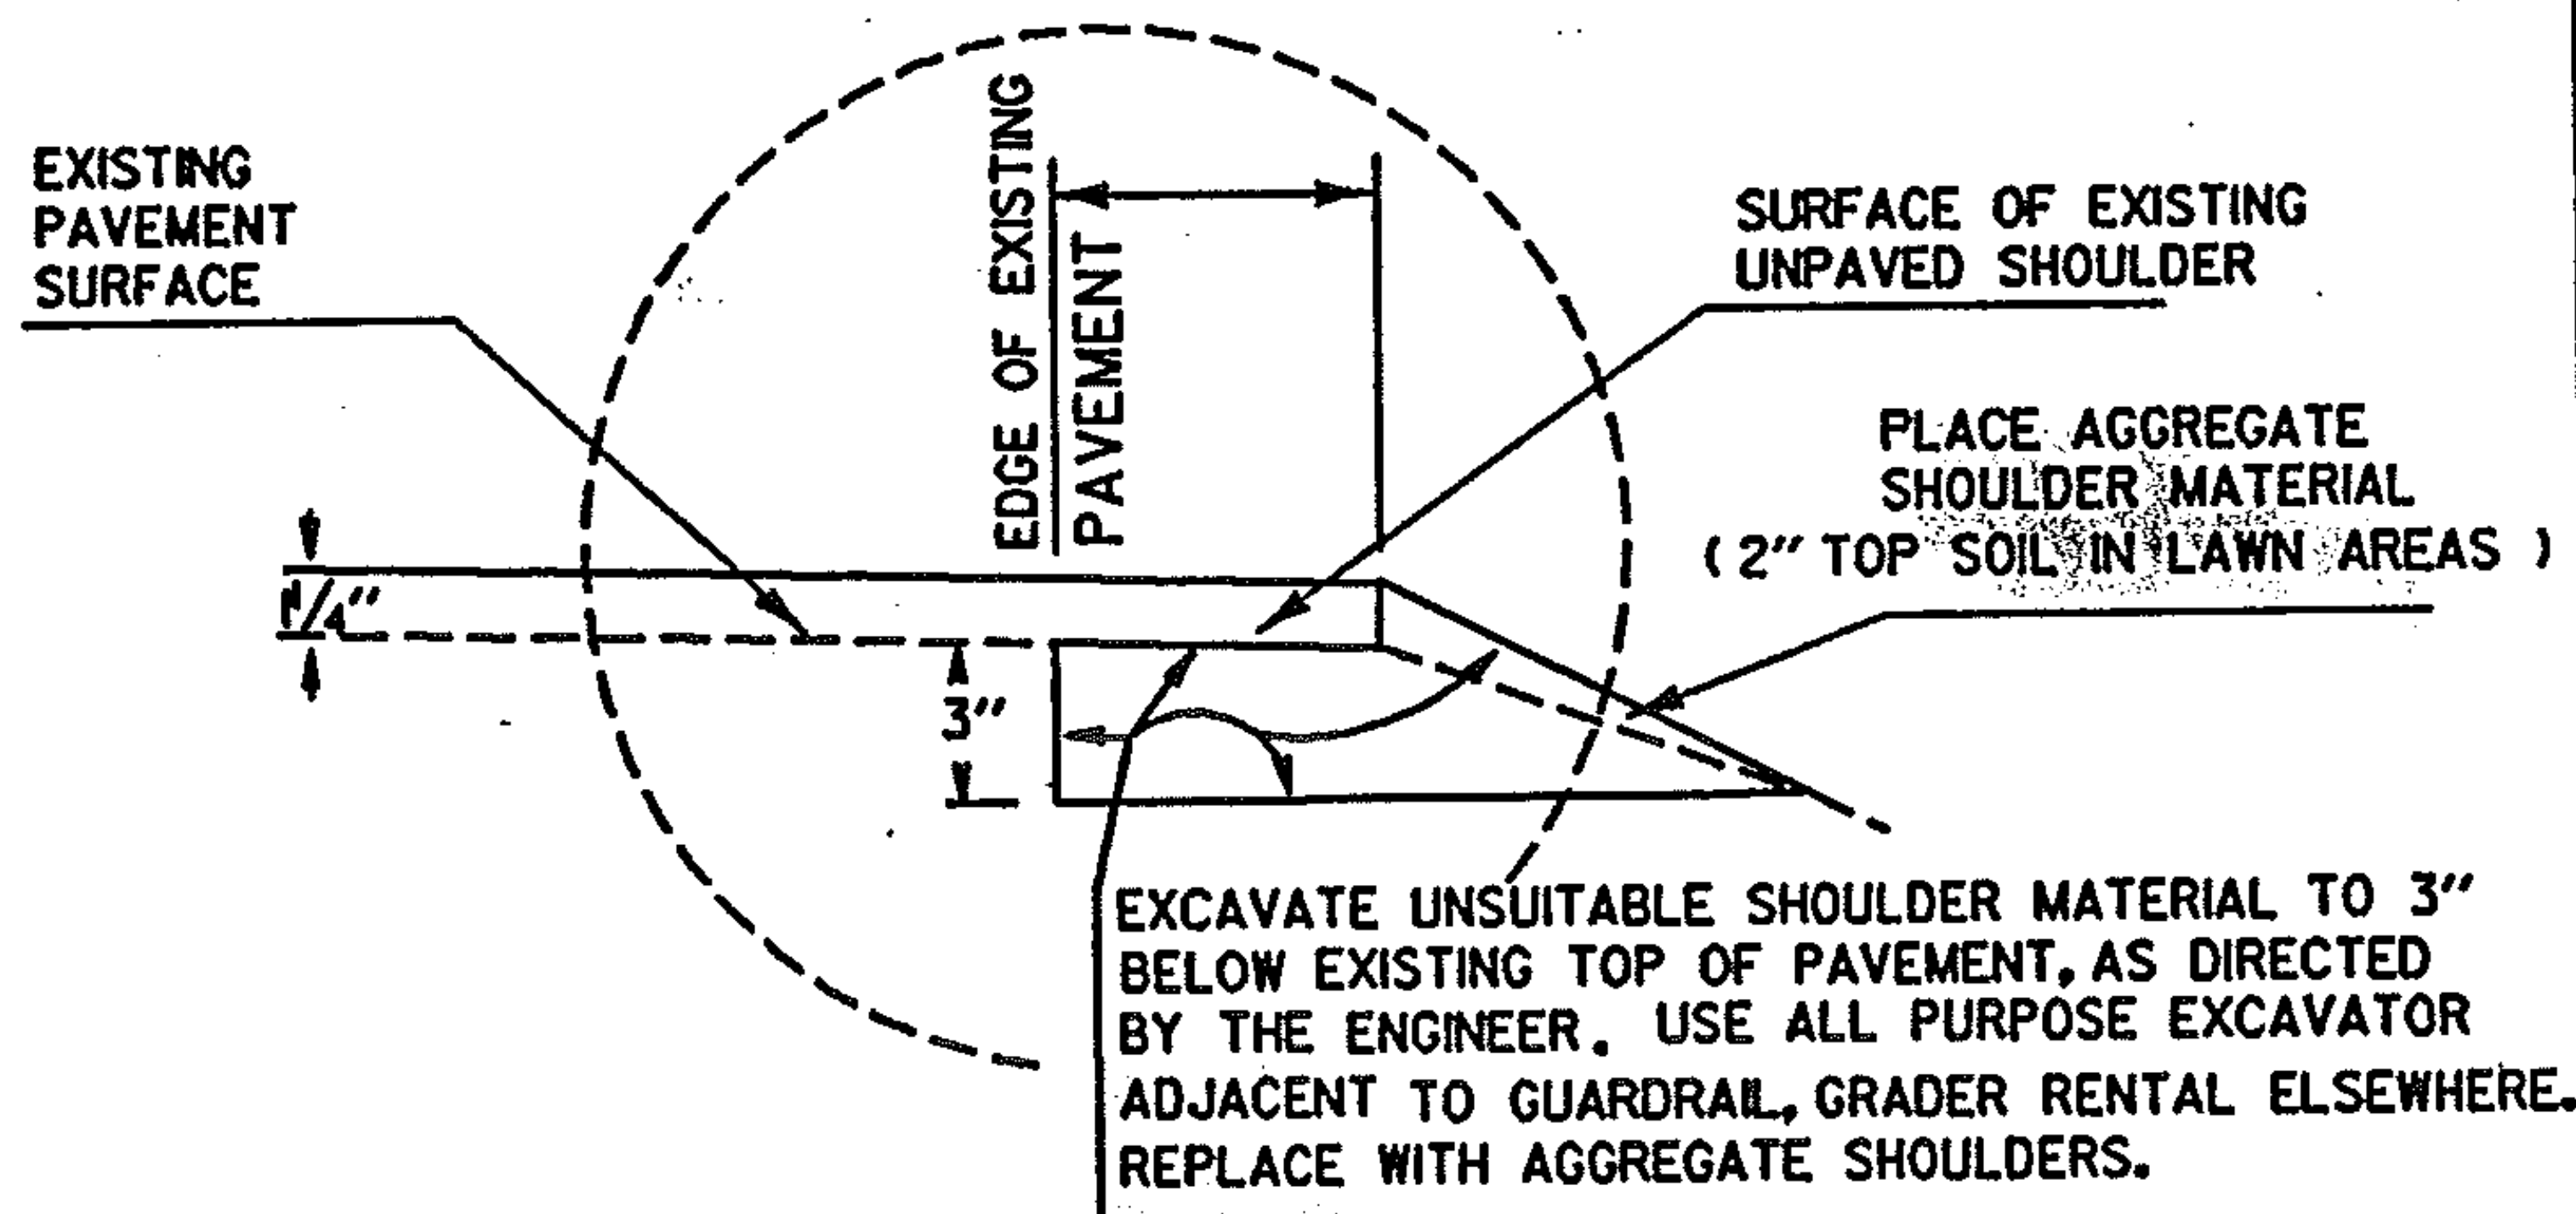


TYPICAL SECTIONS & DESIGN DATA

ITEM 406.25 BITUMINOUS CONCRETE PAVEMENT
 AGGREGATE SHOULDERS ($\pm 1/2"$)
 LEVELING COURSE TYPE IV (300 TONS/MILE)
 1 1/4" WEARING COURSE TYPE III ($\pm 1/4"$)
 AS DIRECTED BY THE ENGINEER
 VT. 128 ESSEX MM 0.000 ~ MM 4.403

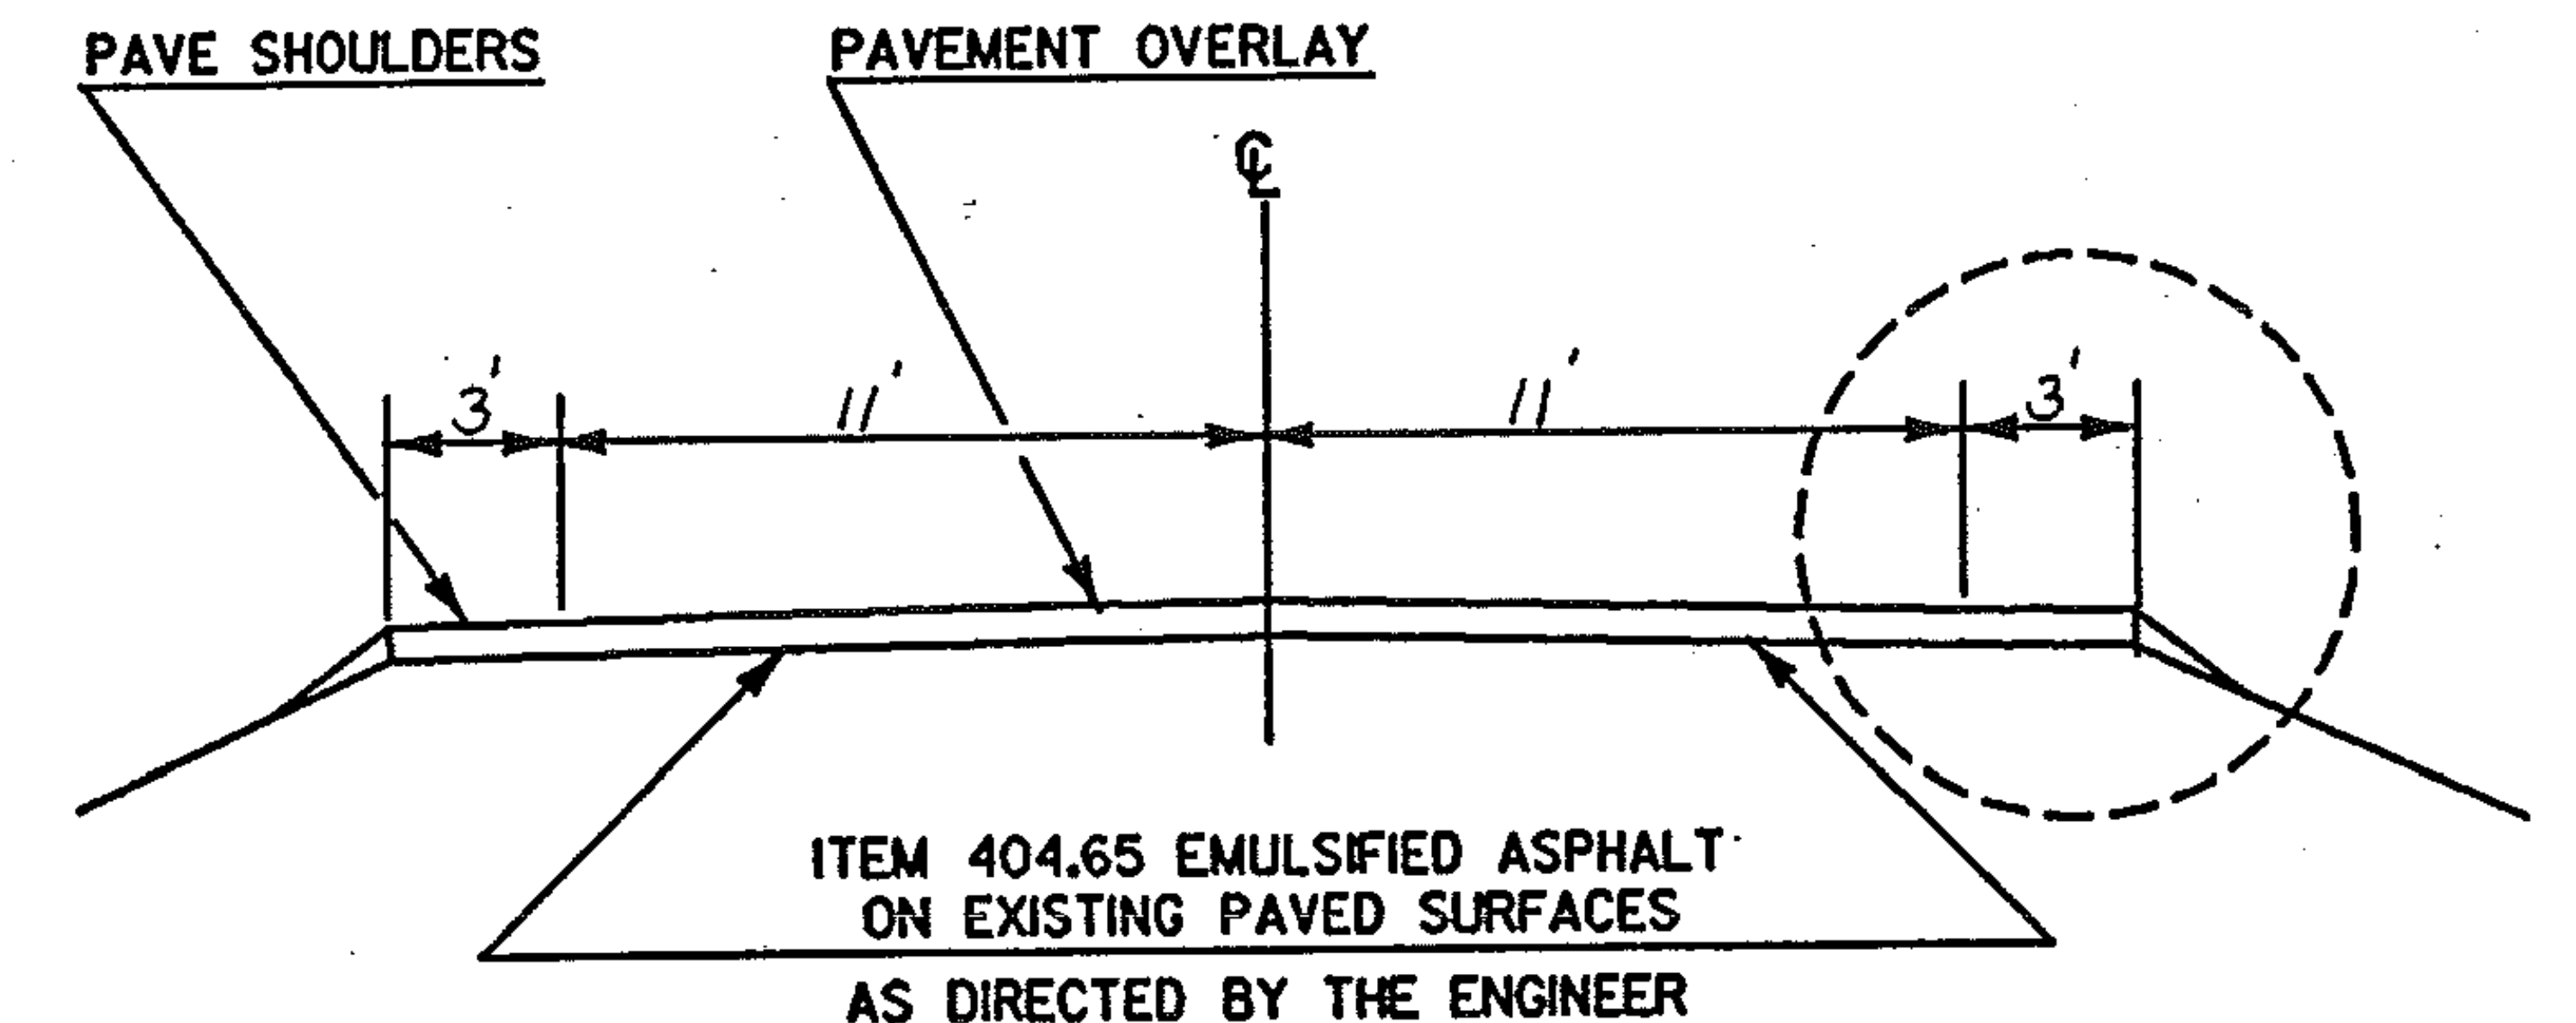

PROJECT ESSEX

NO. HMA 2835

SHEET 14 OF 60 SHEETS