


# TYPICAL SECTIONS & DESIGN DATA

ITEM 406.25 BITUMINOUS CONCRETE PAVEMENT  
LEVELING COURSE TYPE IV (410 TONS/MILE )  
1 1/4" WEARING COURSE TYPE III ( $\pm 1/4"$ )  
AS DIRECTED BY THE ENGINEER

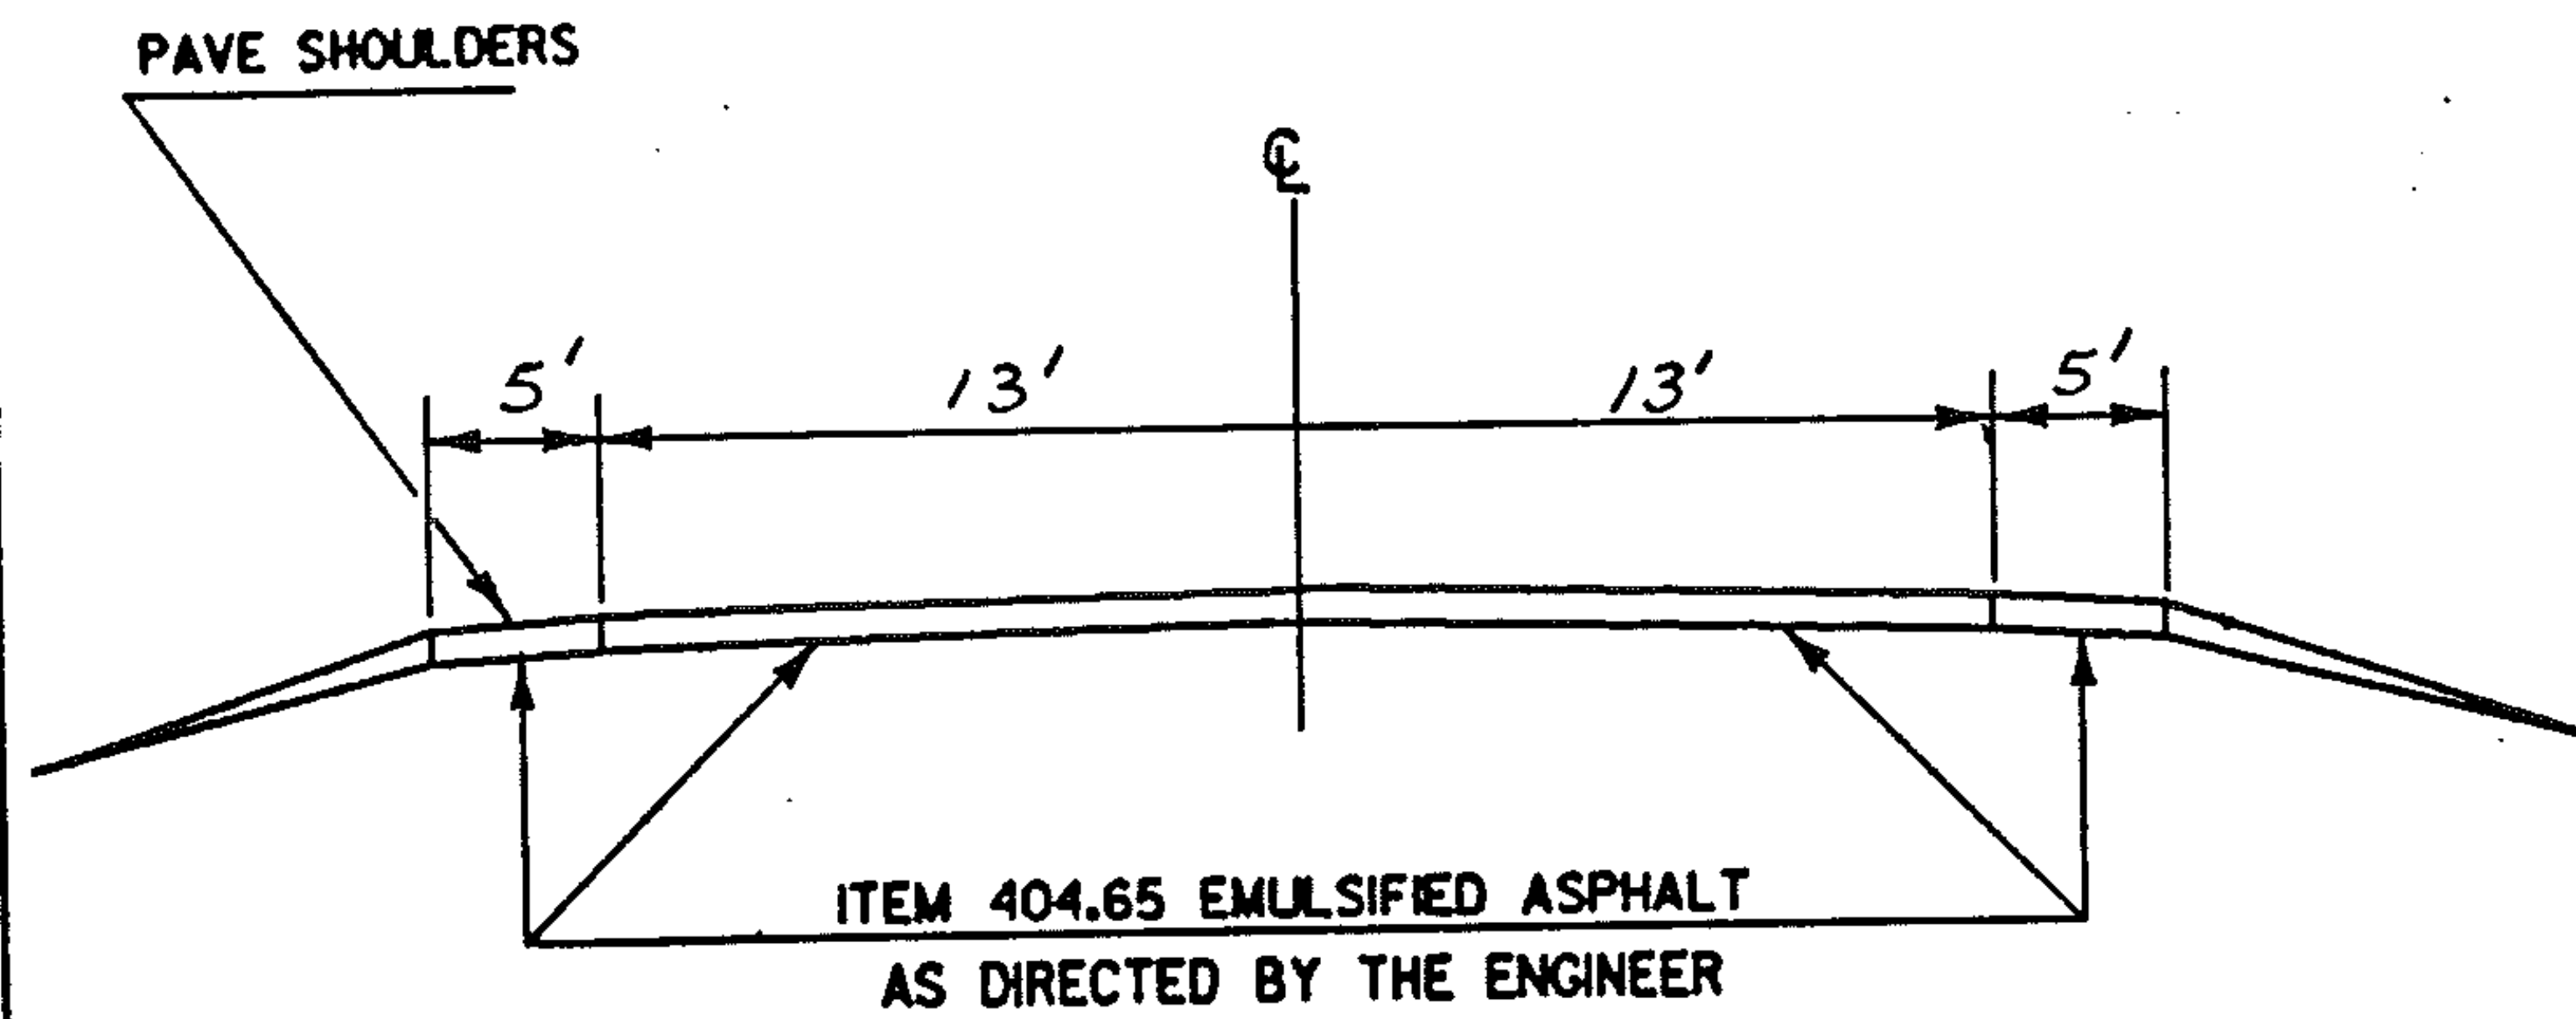

VT. 36 FAIRFIELD MM 9.444 ~ MM 9.572

PROJECT FAIRFIELD - BAKERSFIELD

NO. HMA 2866

SHEET 43 OF 60 SHEETS