


TYPICAL SECTIONS & DESIGN DATA

ITEM 406.25 BITUMINOUS CONCRETE PAVEMENT
LEVELING COURSE TYPE IV (250 TONS/MILE)
1/4" WEARING COURSE TYPE III ($\pm 1/4"$)
AS DIRECTED BY THE ENGINEER

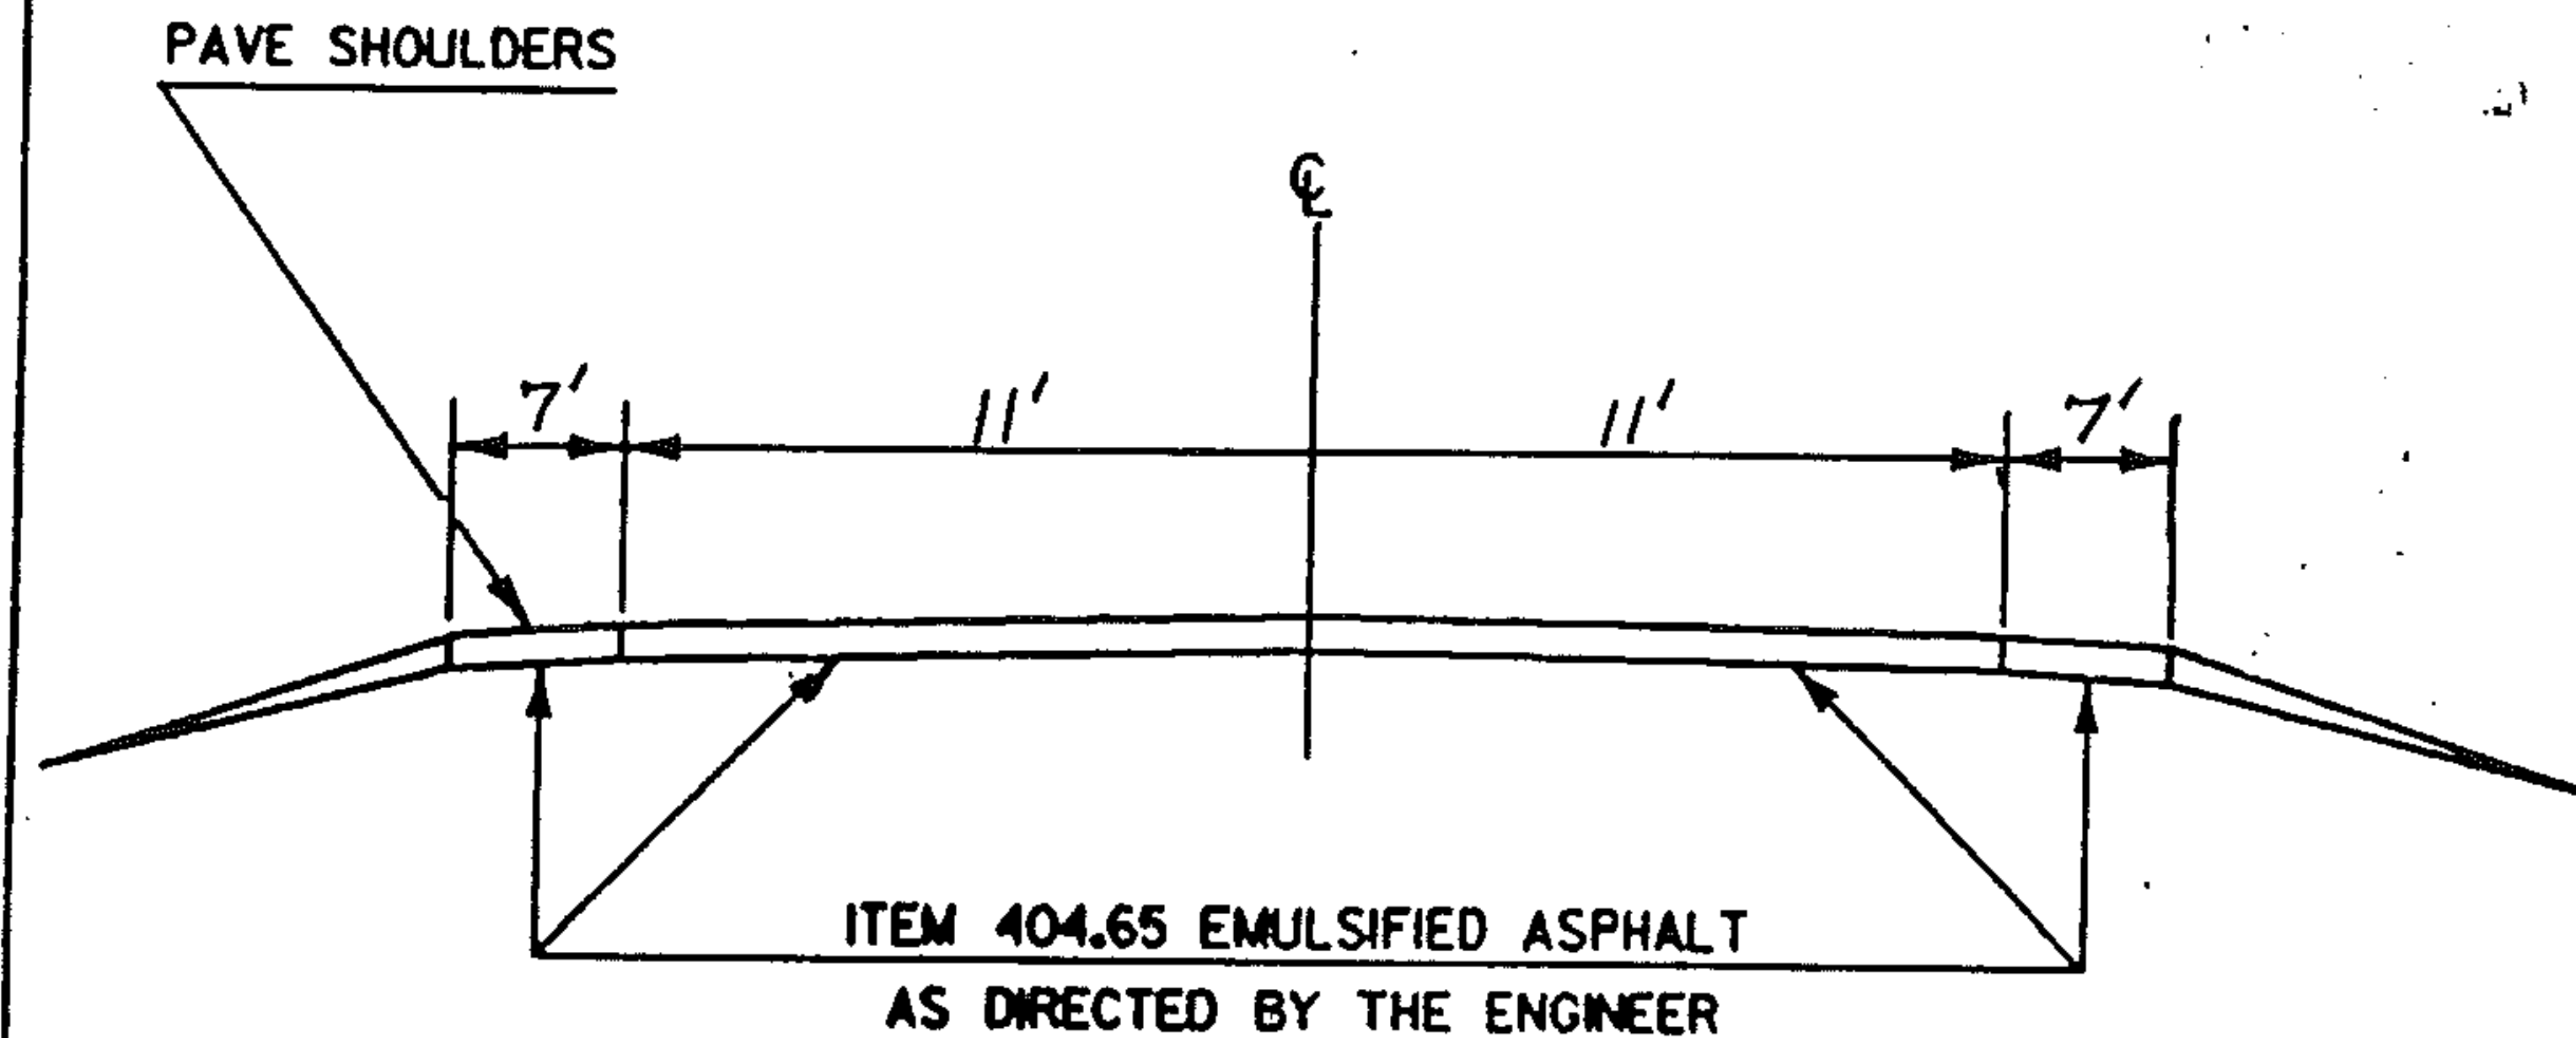

VT 104 FAIRFAX MM 12.29 ~ MM 12.80

PROJECT FAIRFAX-GEORGIA-FAIRFIELD

NO. HMA 2836

SHEET 21 OF 60 SHEETS