


DESCRIPTION AND LOCATION

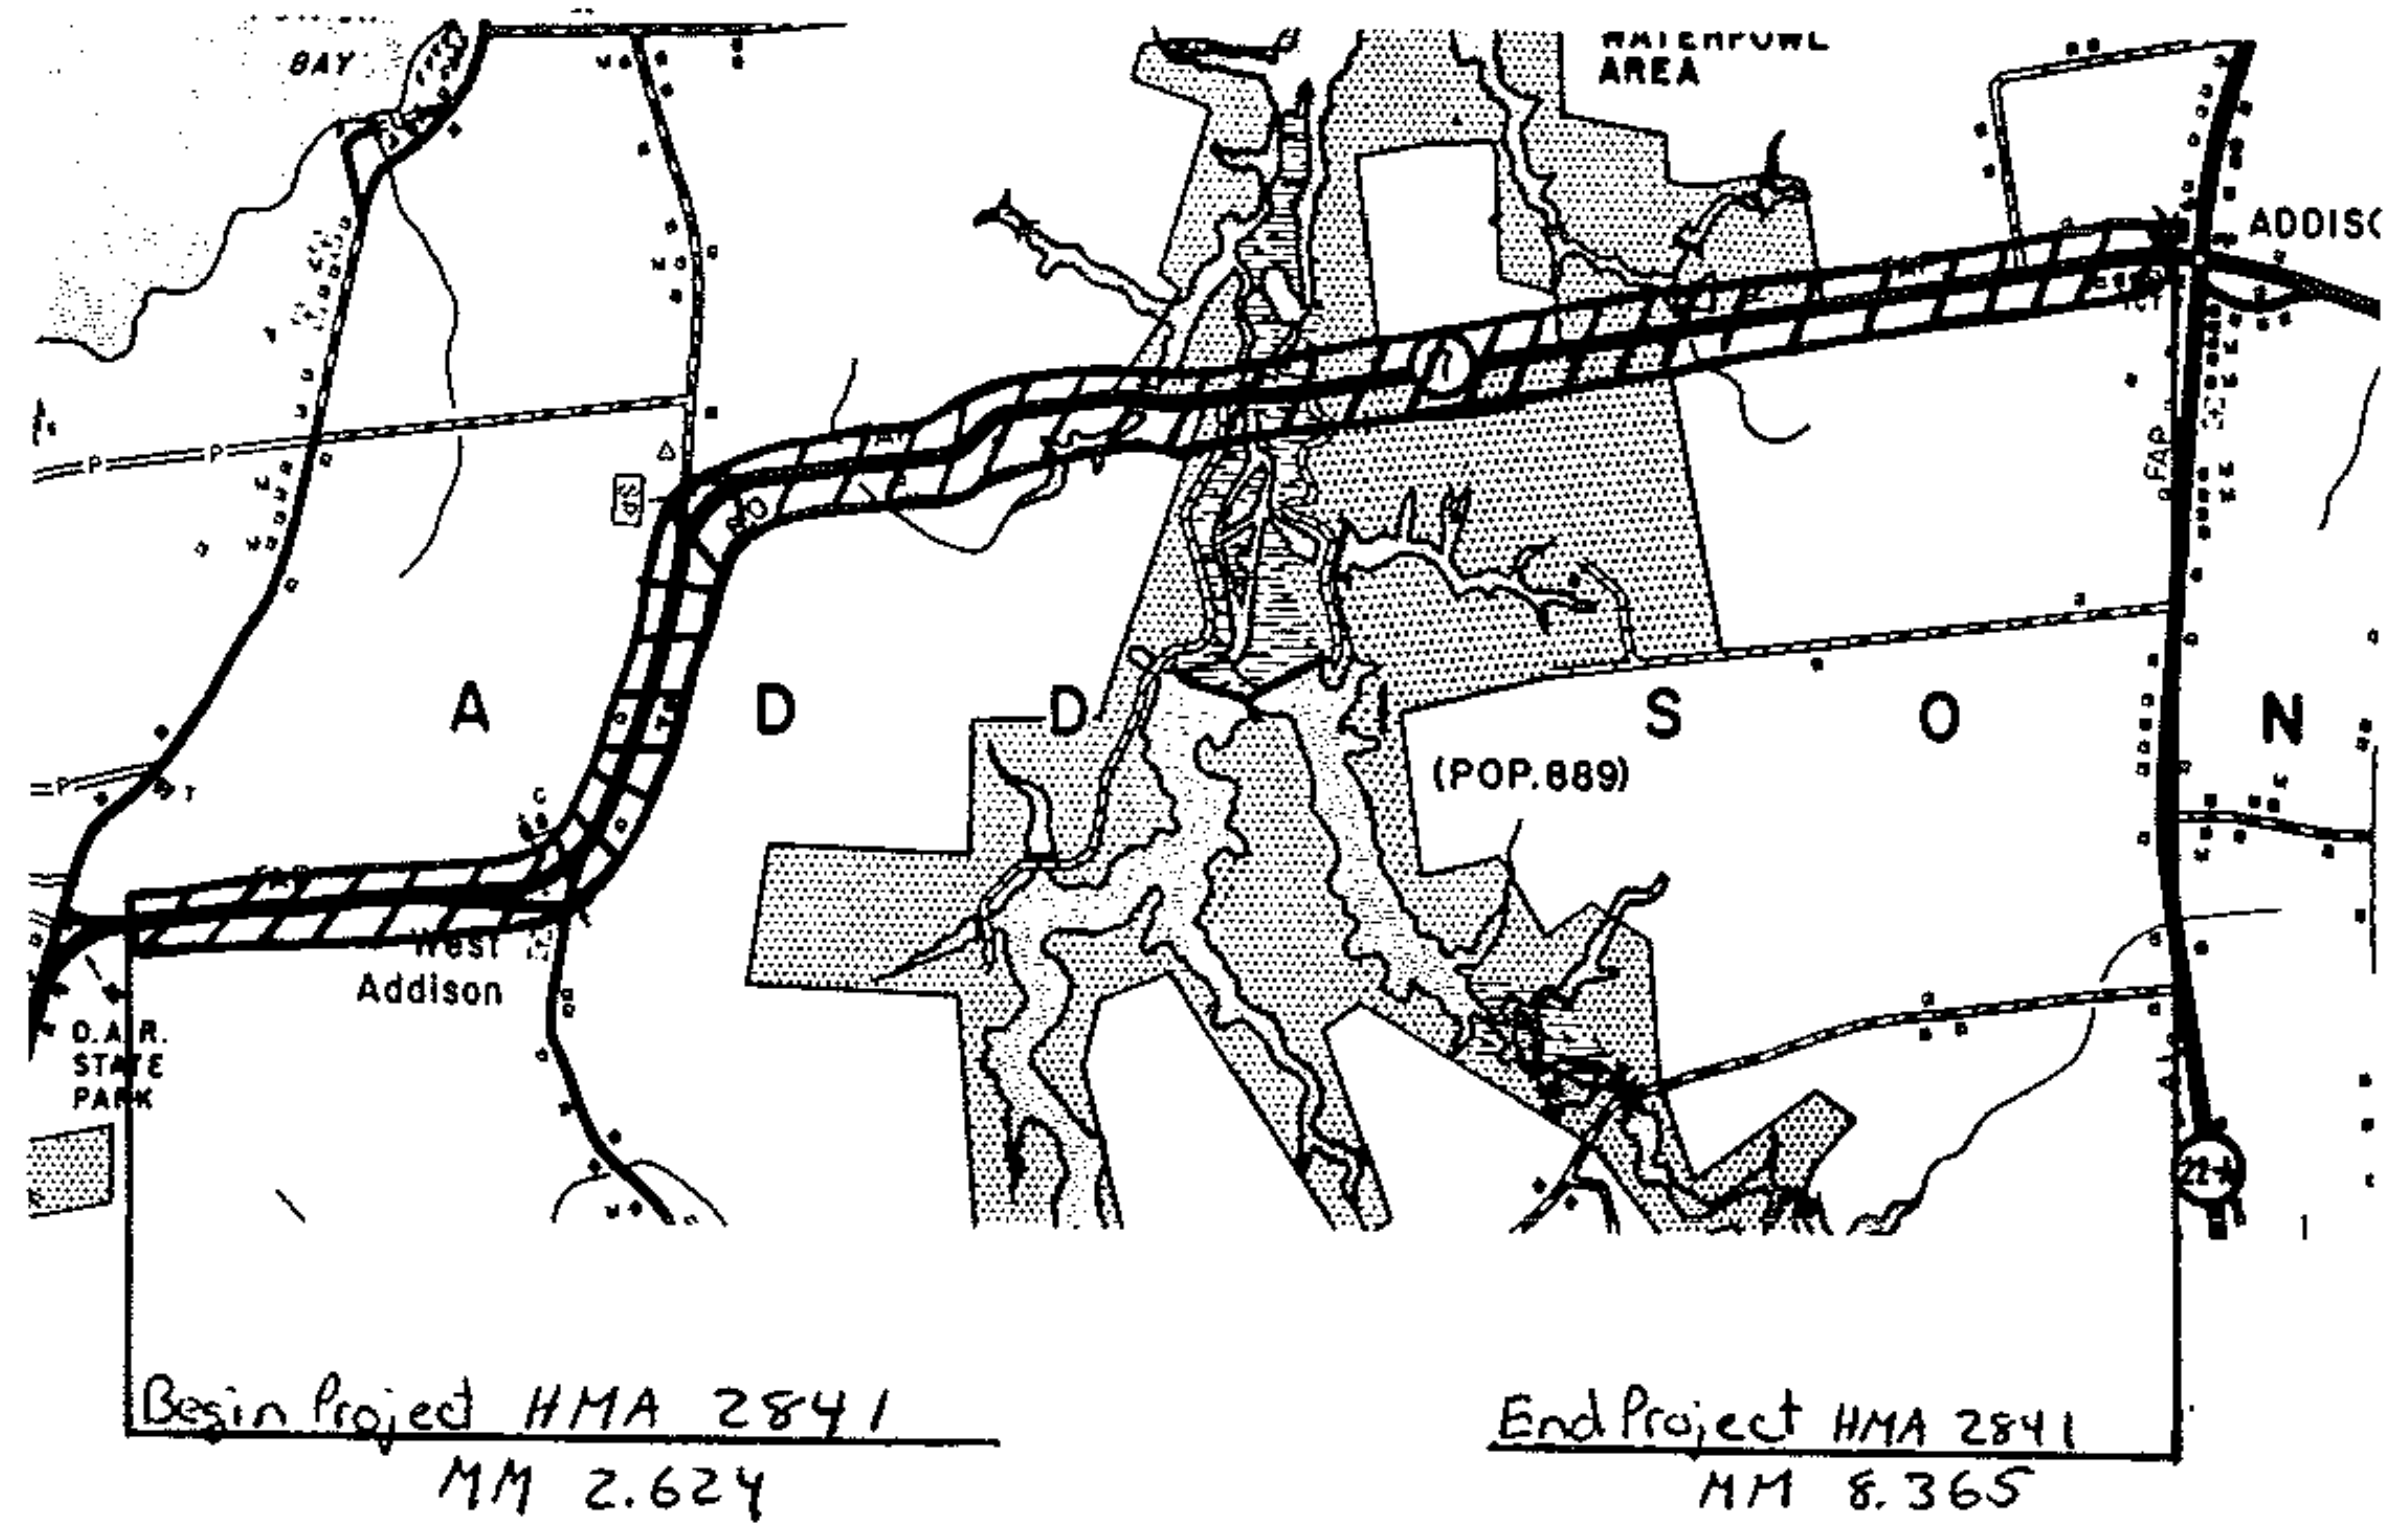

Scale: 1" = 1 mile

Beginning at a point on VT 17, 2.624 miles easterly of the New York - Vermont state line and extending easterly 5.741 miles to MM 8.365

Work consists of resurfacing of the highway, including shoulders and new pavement markings

1986 ADT 1360

Length of Project 5.741 miles
30 312 feet

PROJECT Addison

NO. HMA 2841

SHEET 3 OF 8 SHEETS

Sheet 8 of 75 Sheets