


DESCRIPTION AND LOCATION

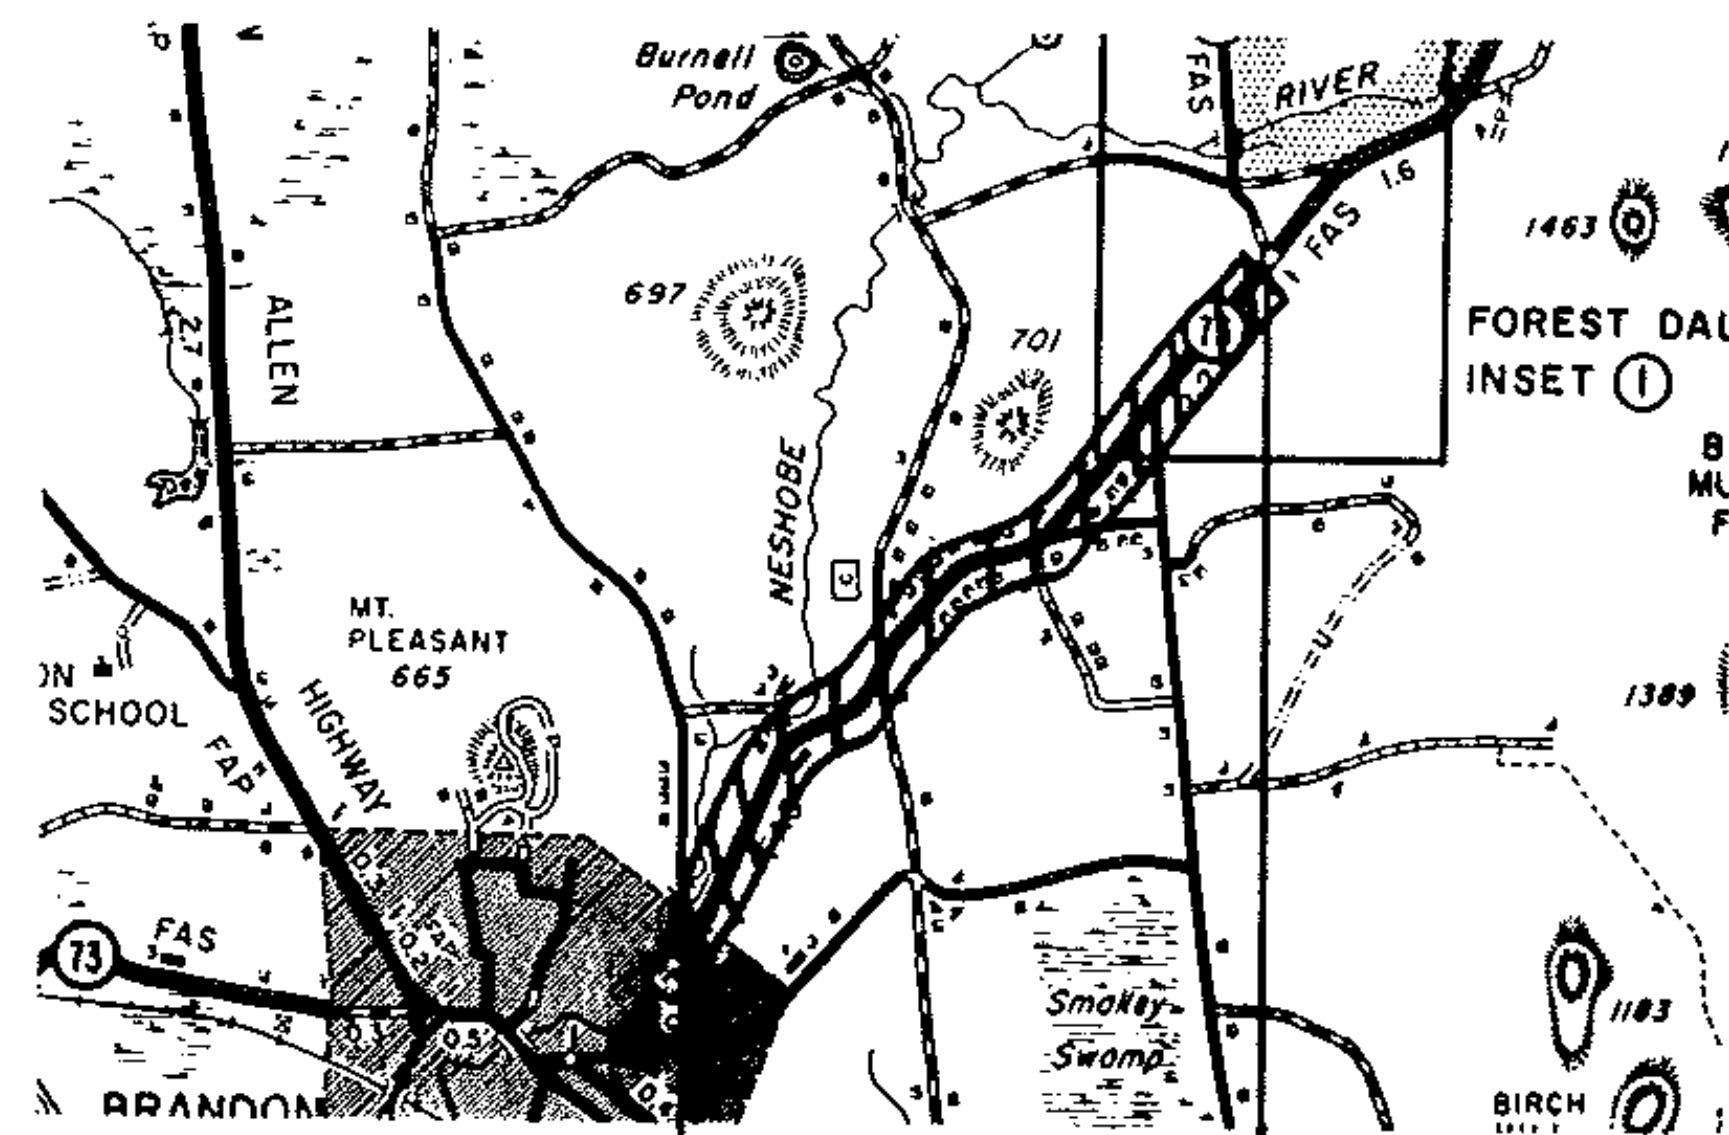

Scale: 1" = 1 mile

Begin Project HMA 2853
MM 3.600

End Project HMA 2853
MM 5.853

Beginning at a point on VT 73, 3.600 miles northerly of the Sudbury-Brandon town line, and extending 2.253 miles easterly to MM 5.853.

Work consists of resurfacing of the highway, including shoulders and new pavement markings.

1986 ADT 2410

Length of Project = 2.253 miles
11896 feet

PROJECT Brandon

NO. HMA 2853

SHEET 3 OF 7 SHEETS

SHEET 30 OF 75 SHEETS