


# DESCRIPTION AND LOCATION

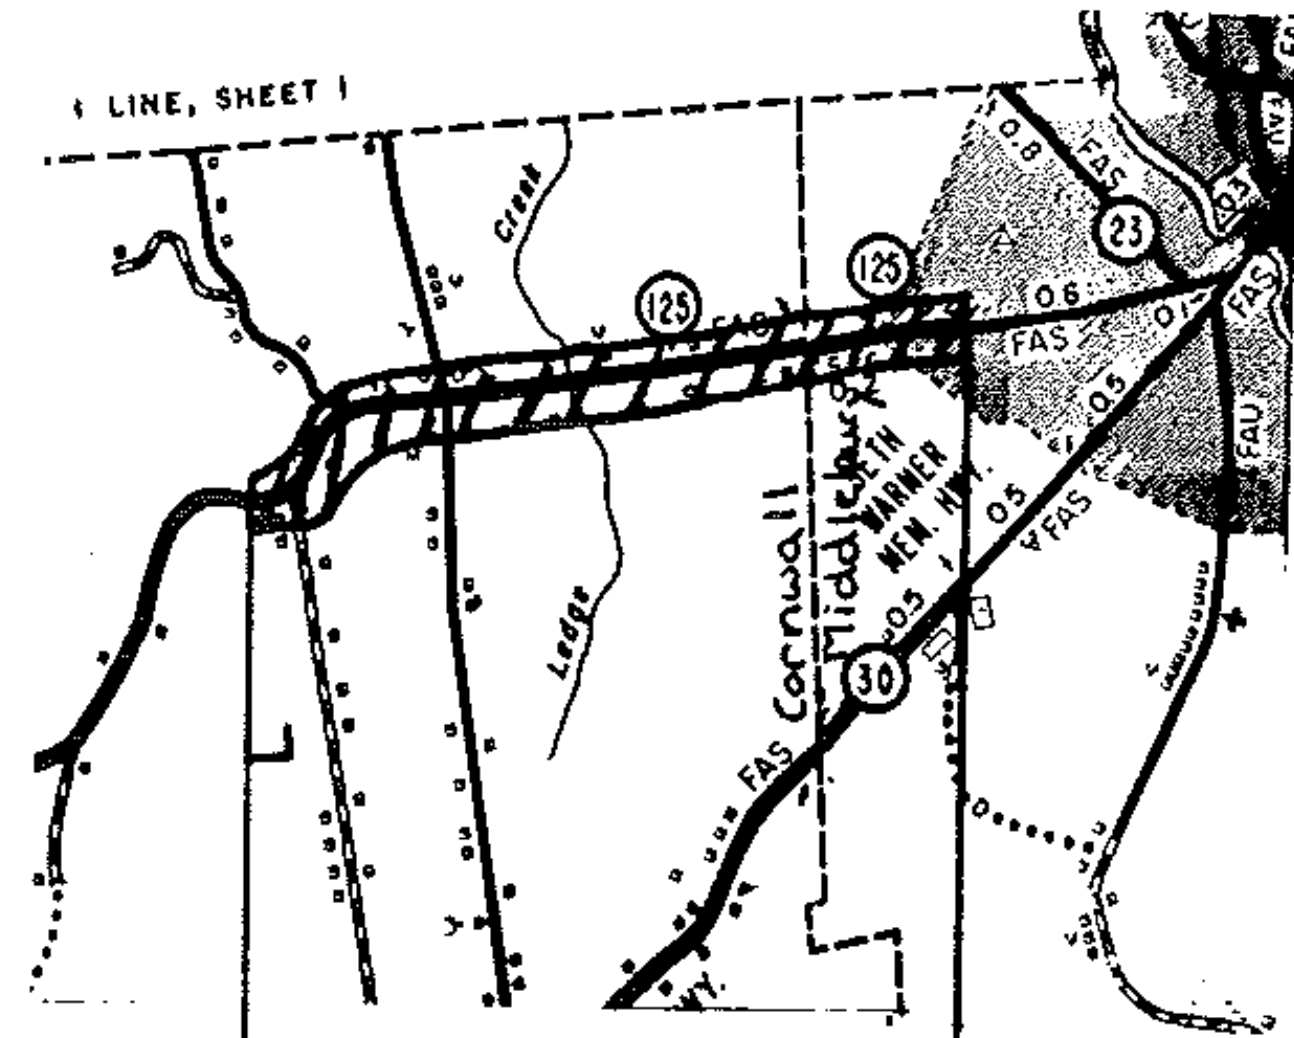

scale: 1" = 1 mile

Begin Project HMA 2825  
MM 2.596

End Project HMA 2825  
MM 0.400

Beginning at a point on VT 125, 2.596 miles easterly of the Bridport - Cornwall town line and extending easterly 2.062 miles to MM 0.400 in the town of Middlebury

Work consists of resurfacing of the highway, including shoulders and new pavement markings

1986 ADT 1490

Length of Project 2.062 miles  
10887 feet

PROJECT Cornwall - Middlebury

NO. HMA 2825

SHEET 3 OF 7 SHEETS

SHEET 37 OF 75 SHEETS