


DESCRIPTION AND LOCATION

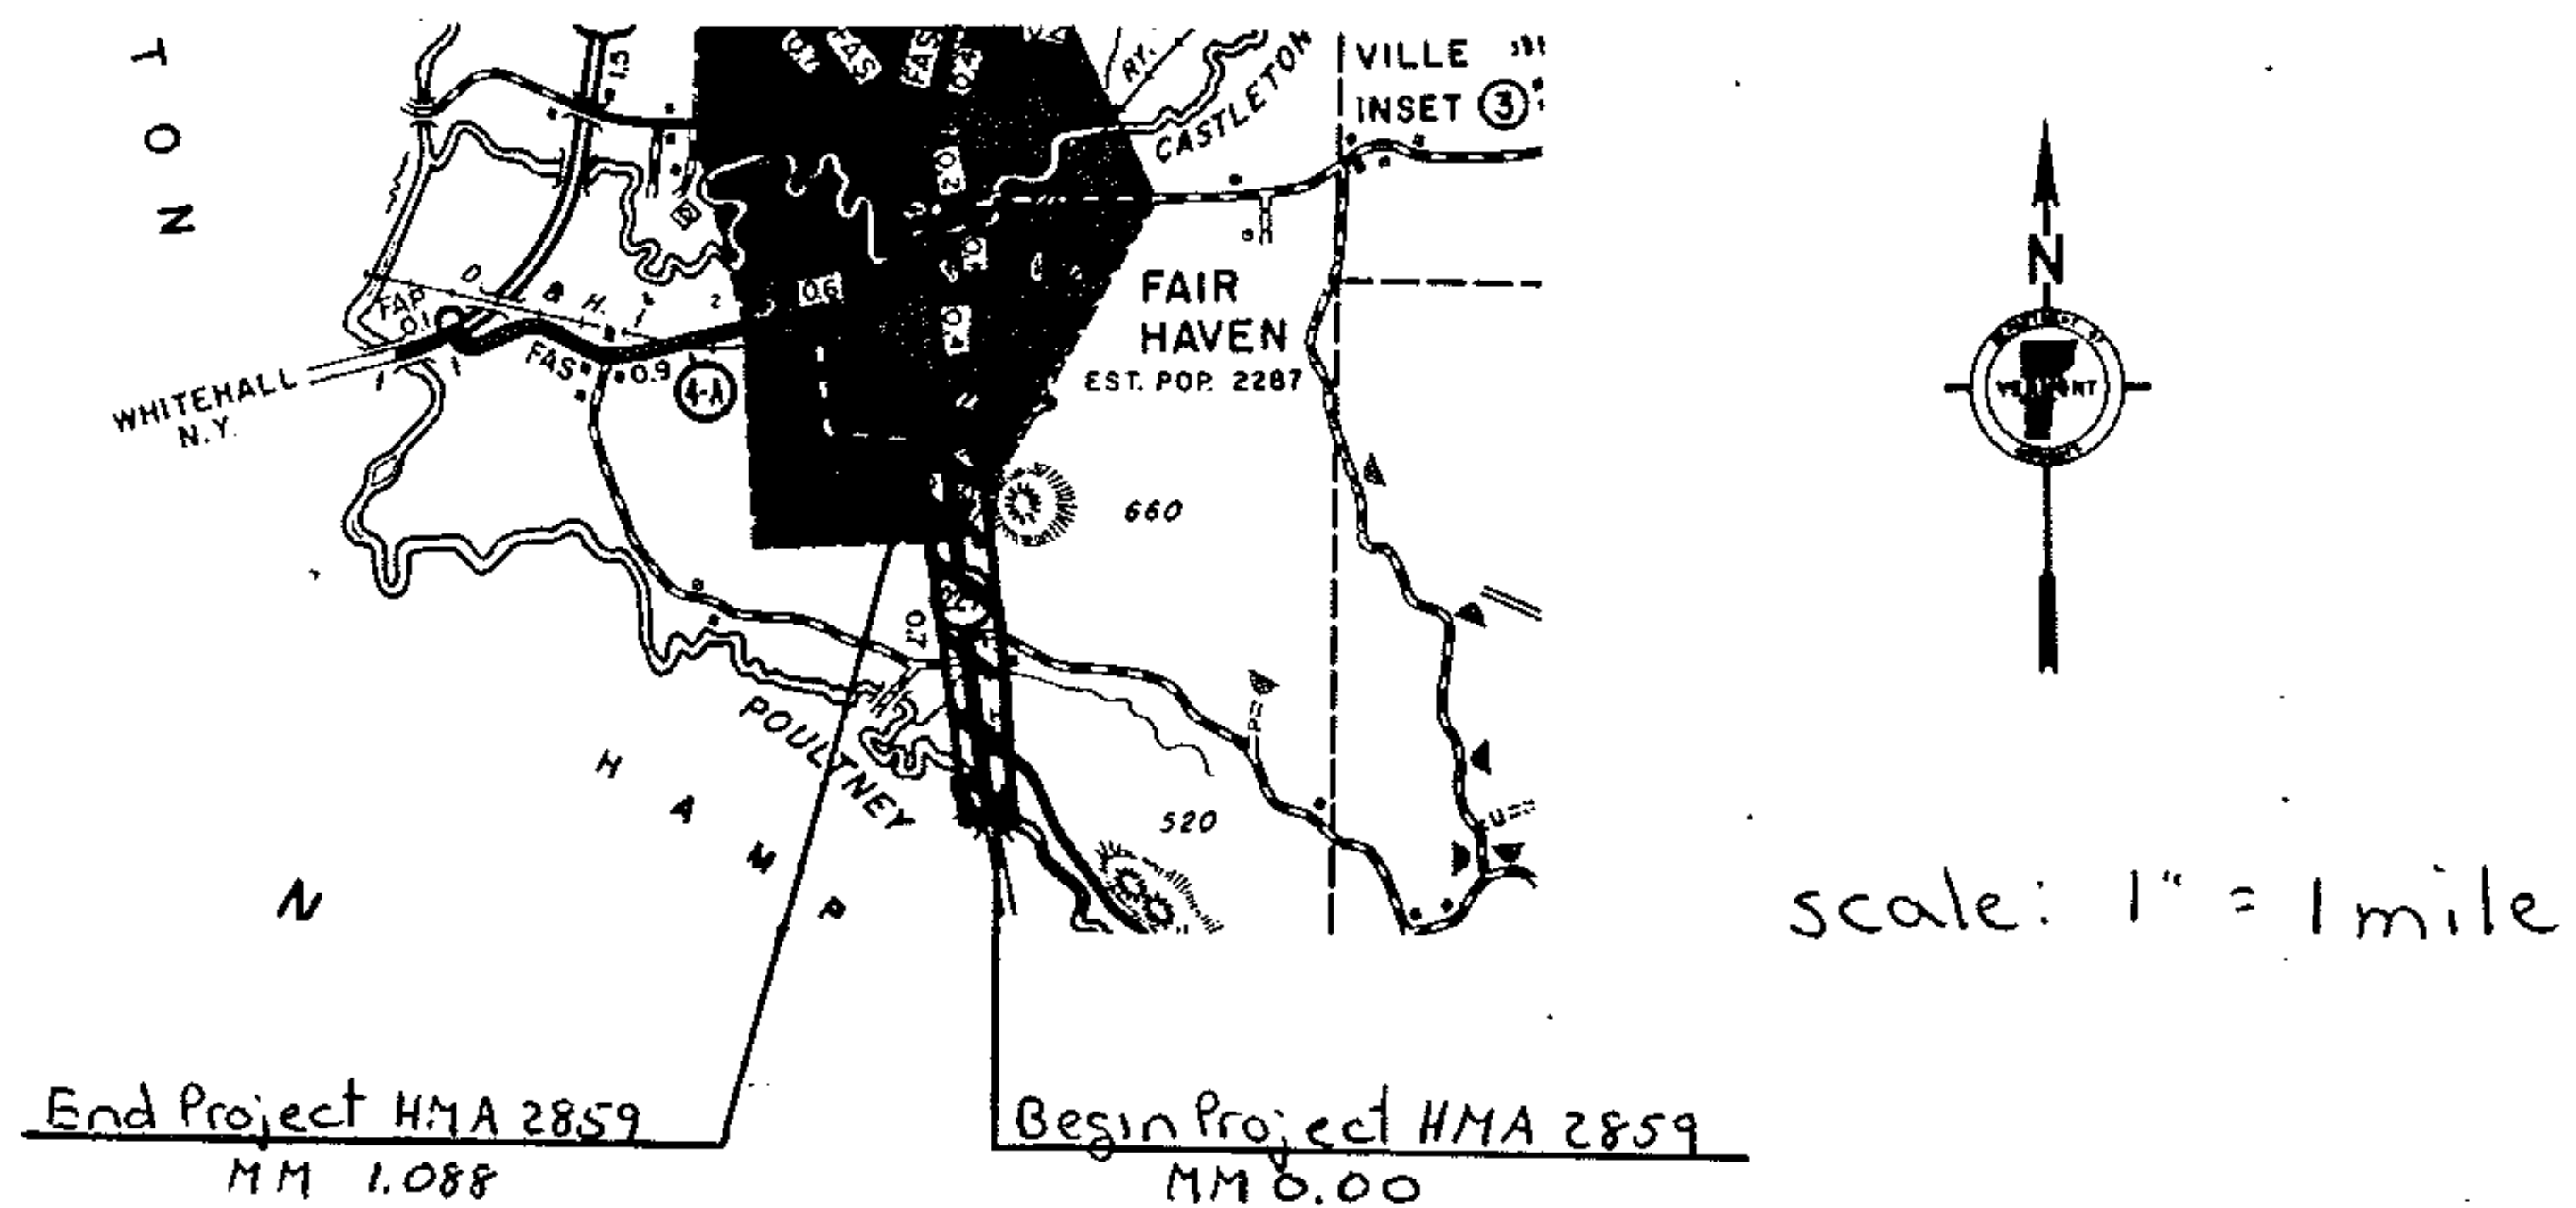

Beginning at a point on UT 22-A, at the NY-VT state line, in the town of Fair Haven, extending northerly 1.088 miles to MM 1.088.

Work consists of resurfacing of the highway, including shoulders and new pavement markings.

1986 ADT 1940	Length of Project	1.088 miles
		5745 feet

PROJECT Fair Haven

NO. HMA 2859

SHEET 3 OF 7 SHEETS

SHEET 44 OF 75 SHEETS