


DESCRIPTION AND LOCATION

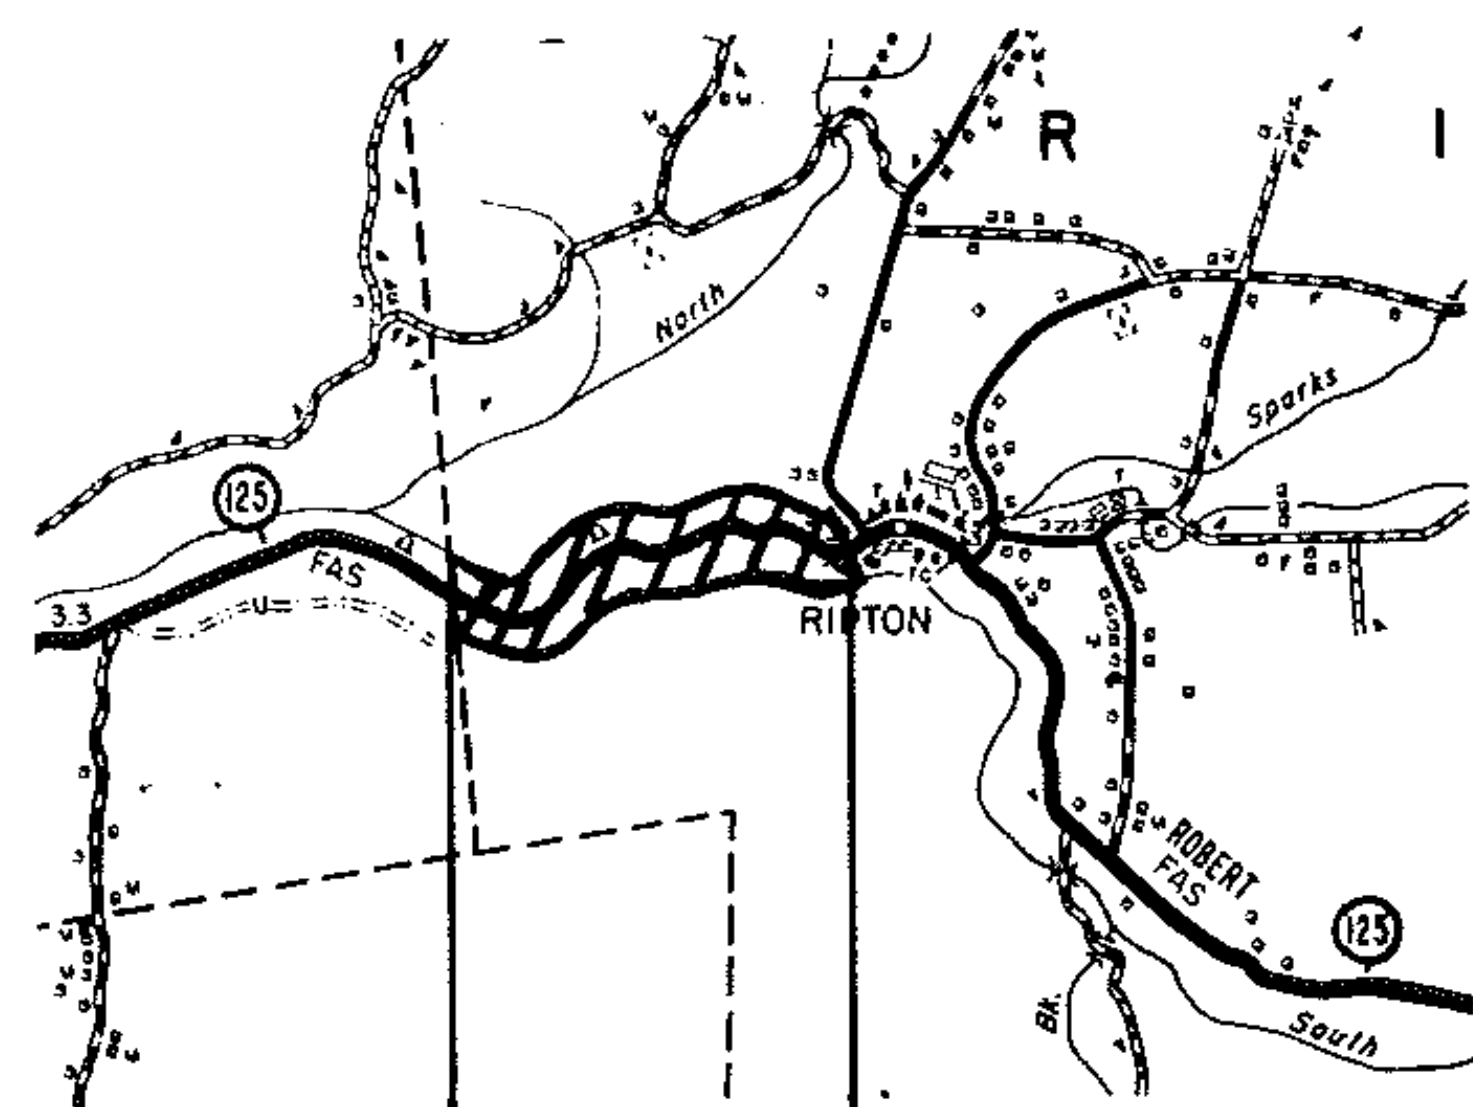

scale: 1" = 1 mile

End Project HMA 2864
MM 1.164

Begin Project HMA 2864
MM 0.00

Beginning at a point on VT 125,
on the Middlebury - Ripton town line and
extending 1.164 miles easterly to MM 1.164

Work consists of resurfacing of
the highway, including shoulders and
pavement markings

1986 ADT 1600

Length of Project 1.164 miles
6146 feet

PROJECT Ripton

NO. HMA 2864

SHEET 3 OF 8 SHEETS

SHEET 51 OF 75 SHEETS