


TYPICAL SECTIONS & DESIGN DATA

BITUMINOUS CONCRETE PAVEMENT
LEVELING COURSE TYPE IV (500 TONS/MILE)
AS DIRECTED BY THE ENGINEER.
1 1/2" WEARING COURSE TYPE III (±1/4" THICKNESS TOLERANCE)

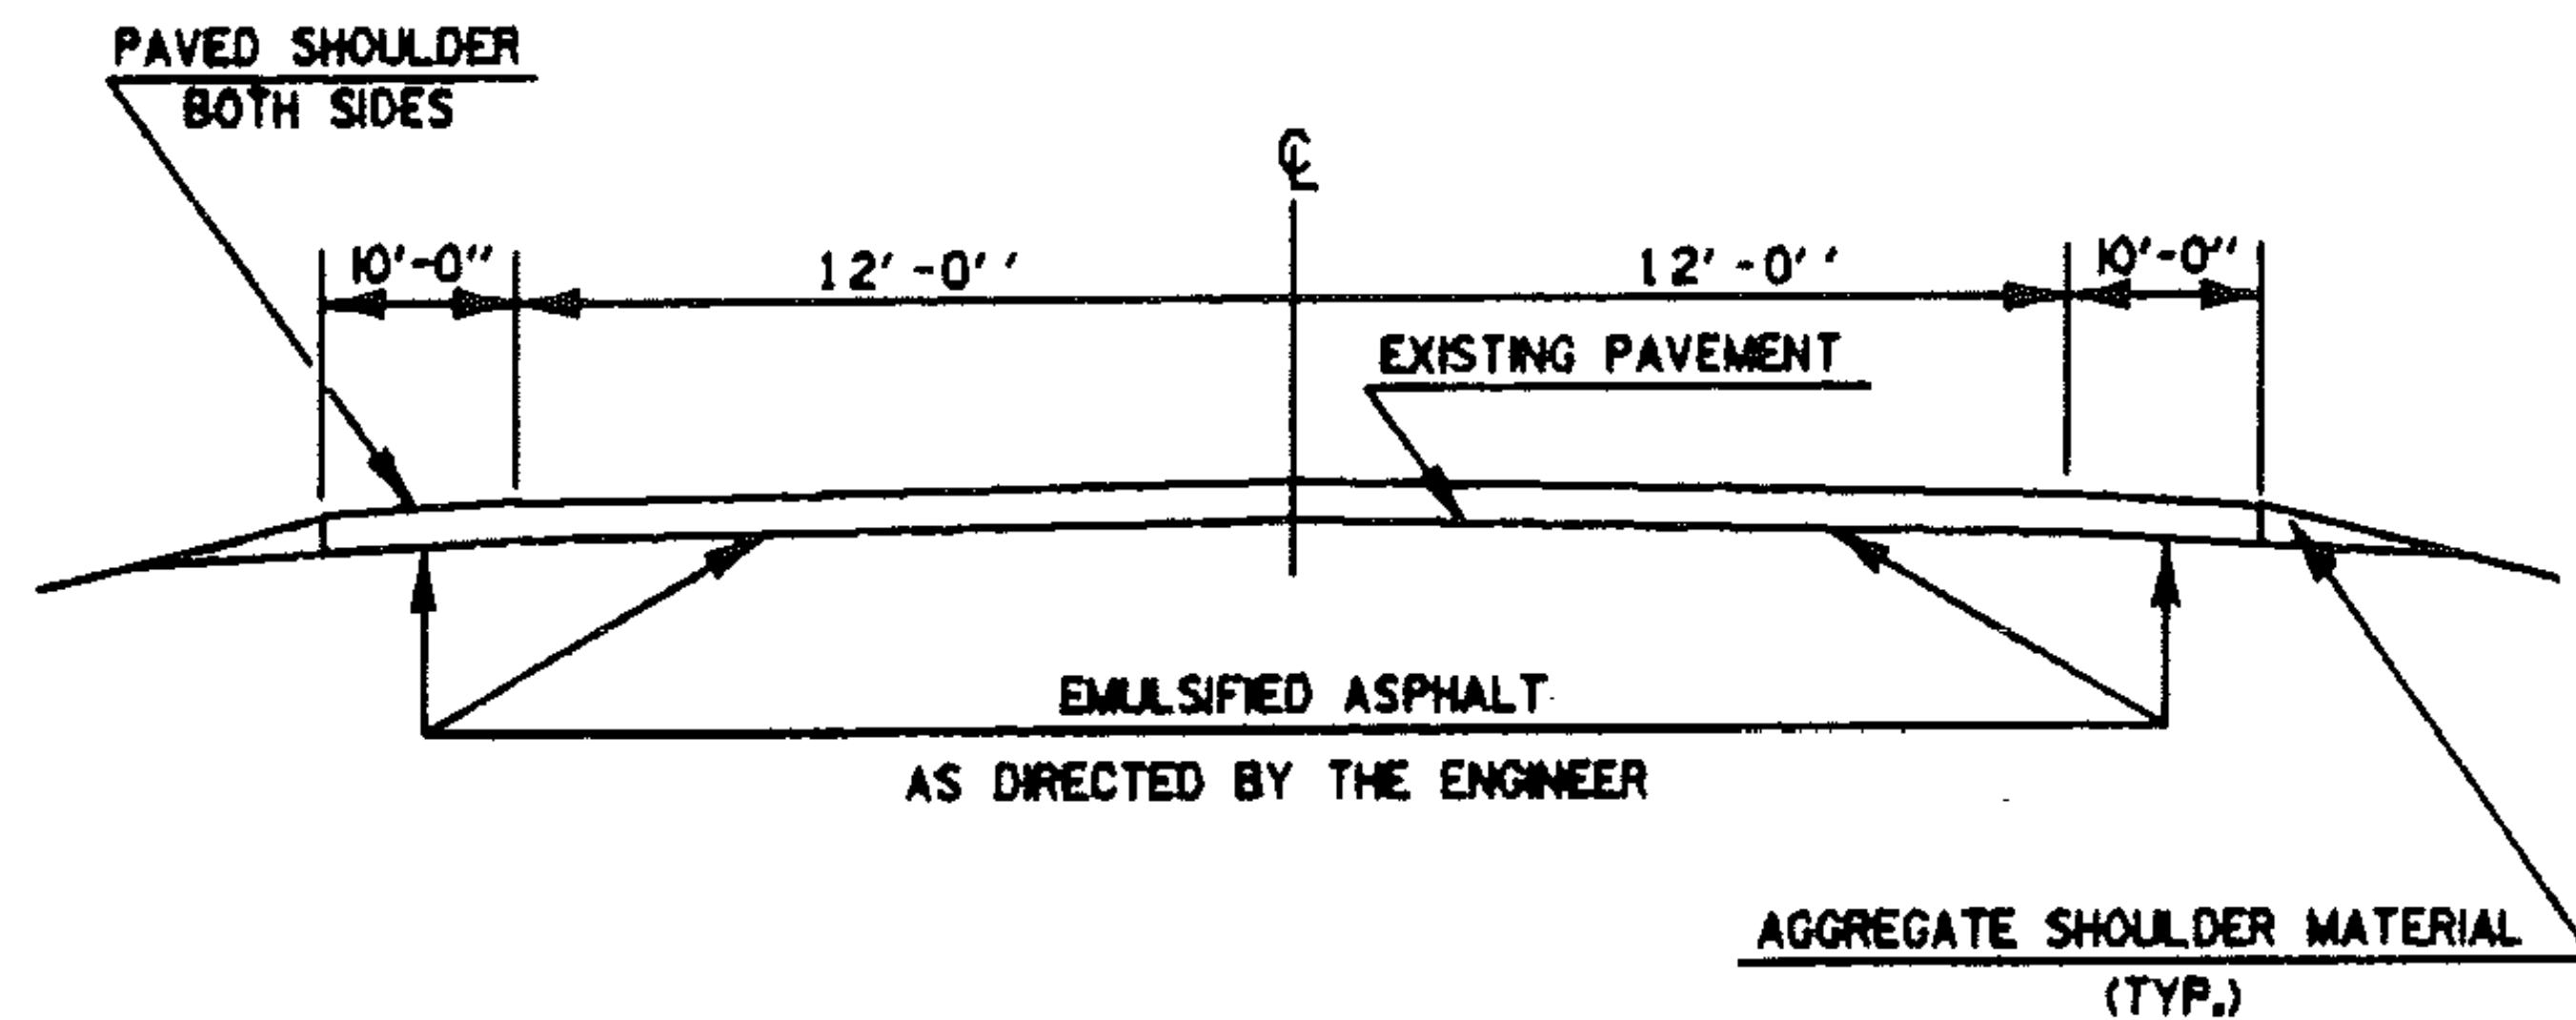

MENDON
U.S. 4 MM 0.850 ~ MM 1.254

NOTE : WHEN ENCOUNTERING VEGETATION OR POOR MATERIAL IN THE SHOULDER AREA,
REMOVE 2" BELOW EXISTING PAVEMENT LEVEL AND REPLACE WITH AGGREGATE
SHOULDER MATERIAL. REMOVAL OF THIS MATERIAL WILL BE PAID FOR UNDER
THE ITEM 'ALL PURPOSE EXCAVATOR RENTAL' OR 'GRADER RENTAL'.

PROJECT RUTLAND-MENDON

NO. HMA 2847
SHEET 6 OF 12 SHEETS
SHEET 62 OF 75 SHEETS