



# TYPICAL SECTIONS & DESIGN DATA

WATERFORD-ST. JOHNSBURY  
HARDWICK-WALDEN  
MORRISTOWN

HMA 2842  
HMA 2820  
HMA 2817

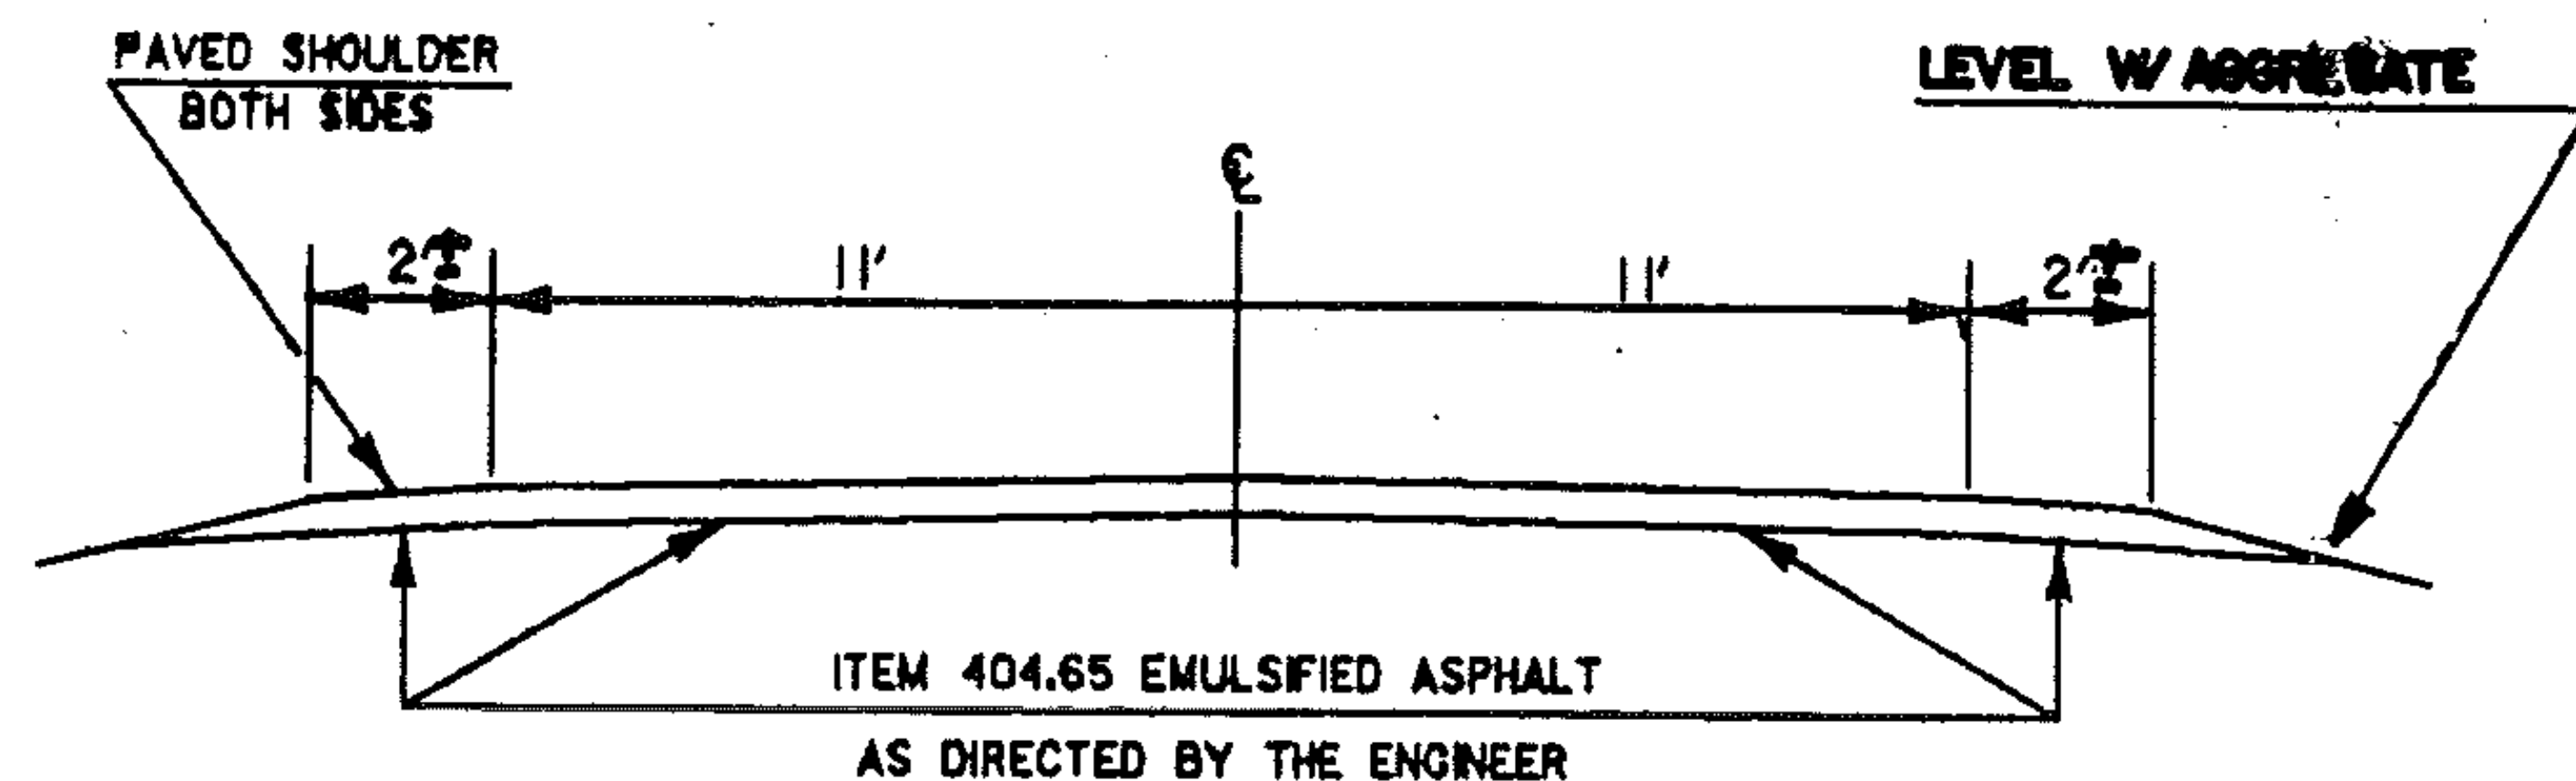

MONTPELIER HMA 2821

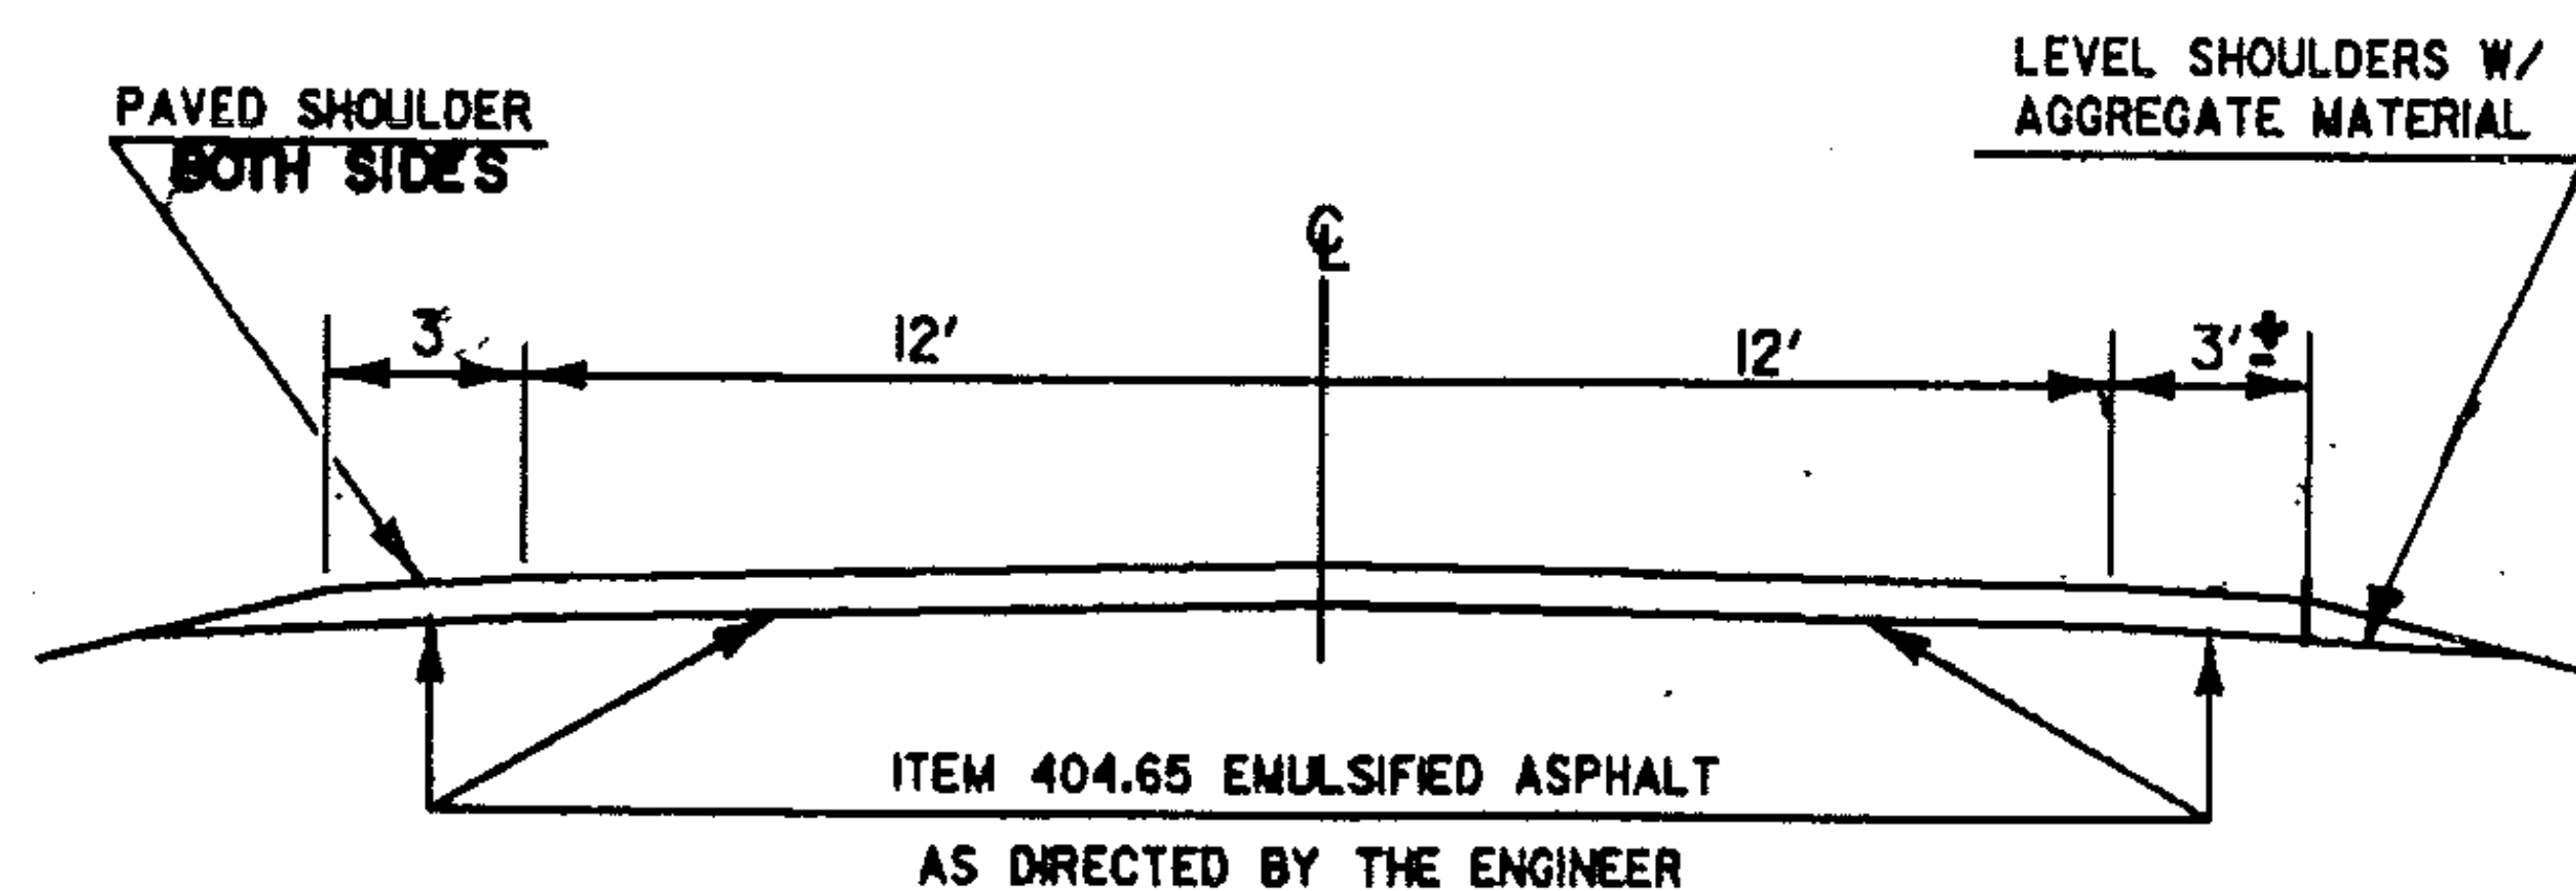

PROJECT WATERFORD-STJOHNSBURY HMA 2842  
HARDWICK-WALDEN HMA 2820  
MORRISTOWN HMA 2817  
MONTPELIER HMA 2821

SHEET 2A OF 81 SHEETS