


# TYPICAL SECTIONS & DESIGN DATA

ITEM 406.25 BITUMINOUS CONCRETE PAVEMENT  
 LEVELING COURSE TYPE IV (300 TONS/MILE)  
 1/4" WEARING COURSE TYPE III ( $\pm 1/4"$ )  
 AS DIRECTED BY THE ENGINEER

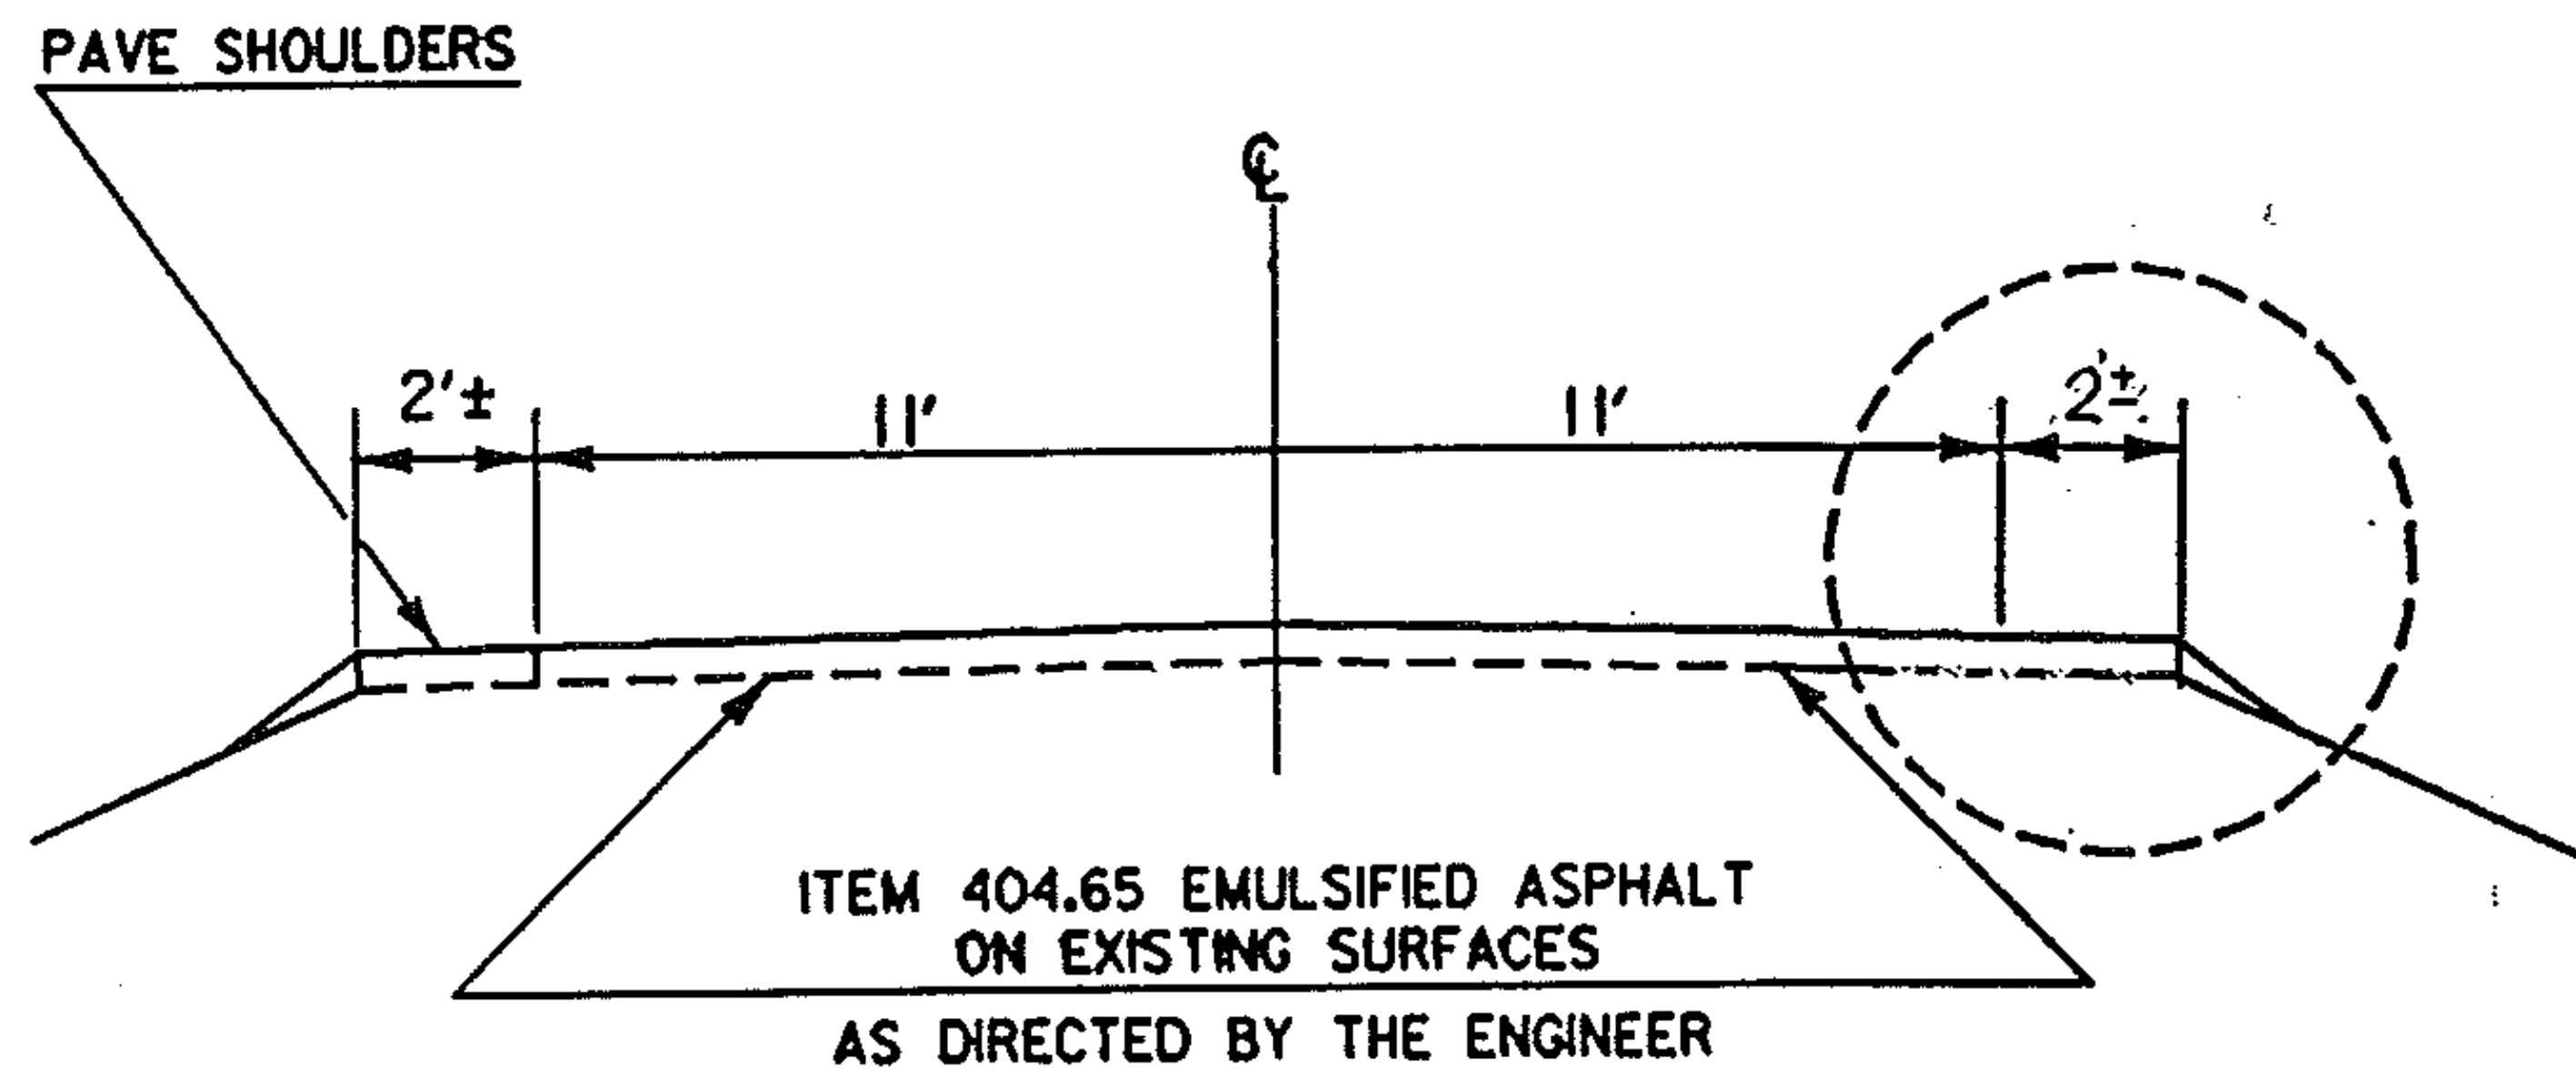

WATERFORD - ST JOHNSBURY  
 US 5  
 MM 0.000 ~ MM 0.269

**GENERAL NOTES:**

MM 0.11  $\pm$  LT. ERODED SHOULDER LEFT SIDE TO BE REPAIRED  
 AND PAID FOR BY ITEM 402.10 , OR 402.12 GRAVEL SHOULDERS  
 WATERFORD MM 0.25~0.30  $\pm$  RT. CLEAN, RESHAPE, AND RESURFACE TREATED  
 TIMBER CURB AS DIRECTED BY THE ENGINEER.  
 ST. JOHNSBURY MM 0.00~0.269  $\pm$  LT. RESURFACE EXISTING GUTTER WITH 1"  
 OF ITEM 616.47 BITUMINOUS CONCRETE GUTTERS & TRAFFIC ISLANDS

PROJECT WATERFORD - ST JOHNSBURY

NO. HMA 2842

SHEET 10 OF 81 SHEETS