


DESCRIPTION AND LOCATION

PROJECT LENGTH: 2.477 MILES ; 13,078 FEET
1985 ADT: 4790

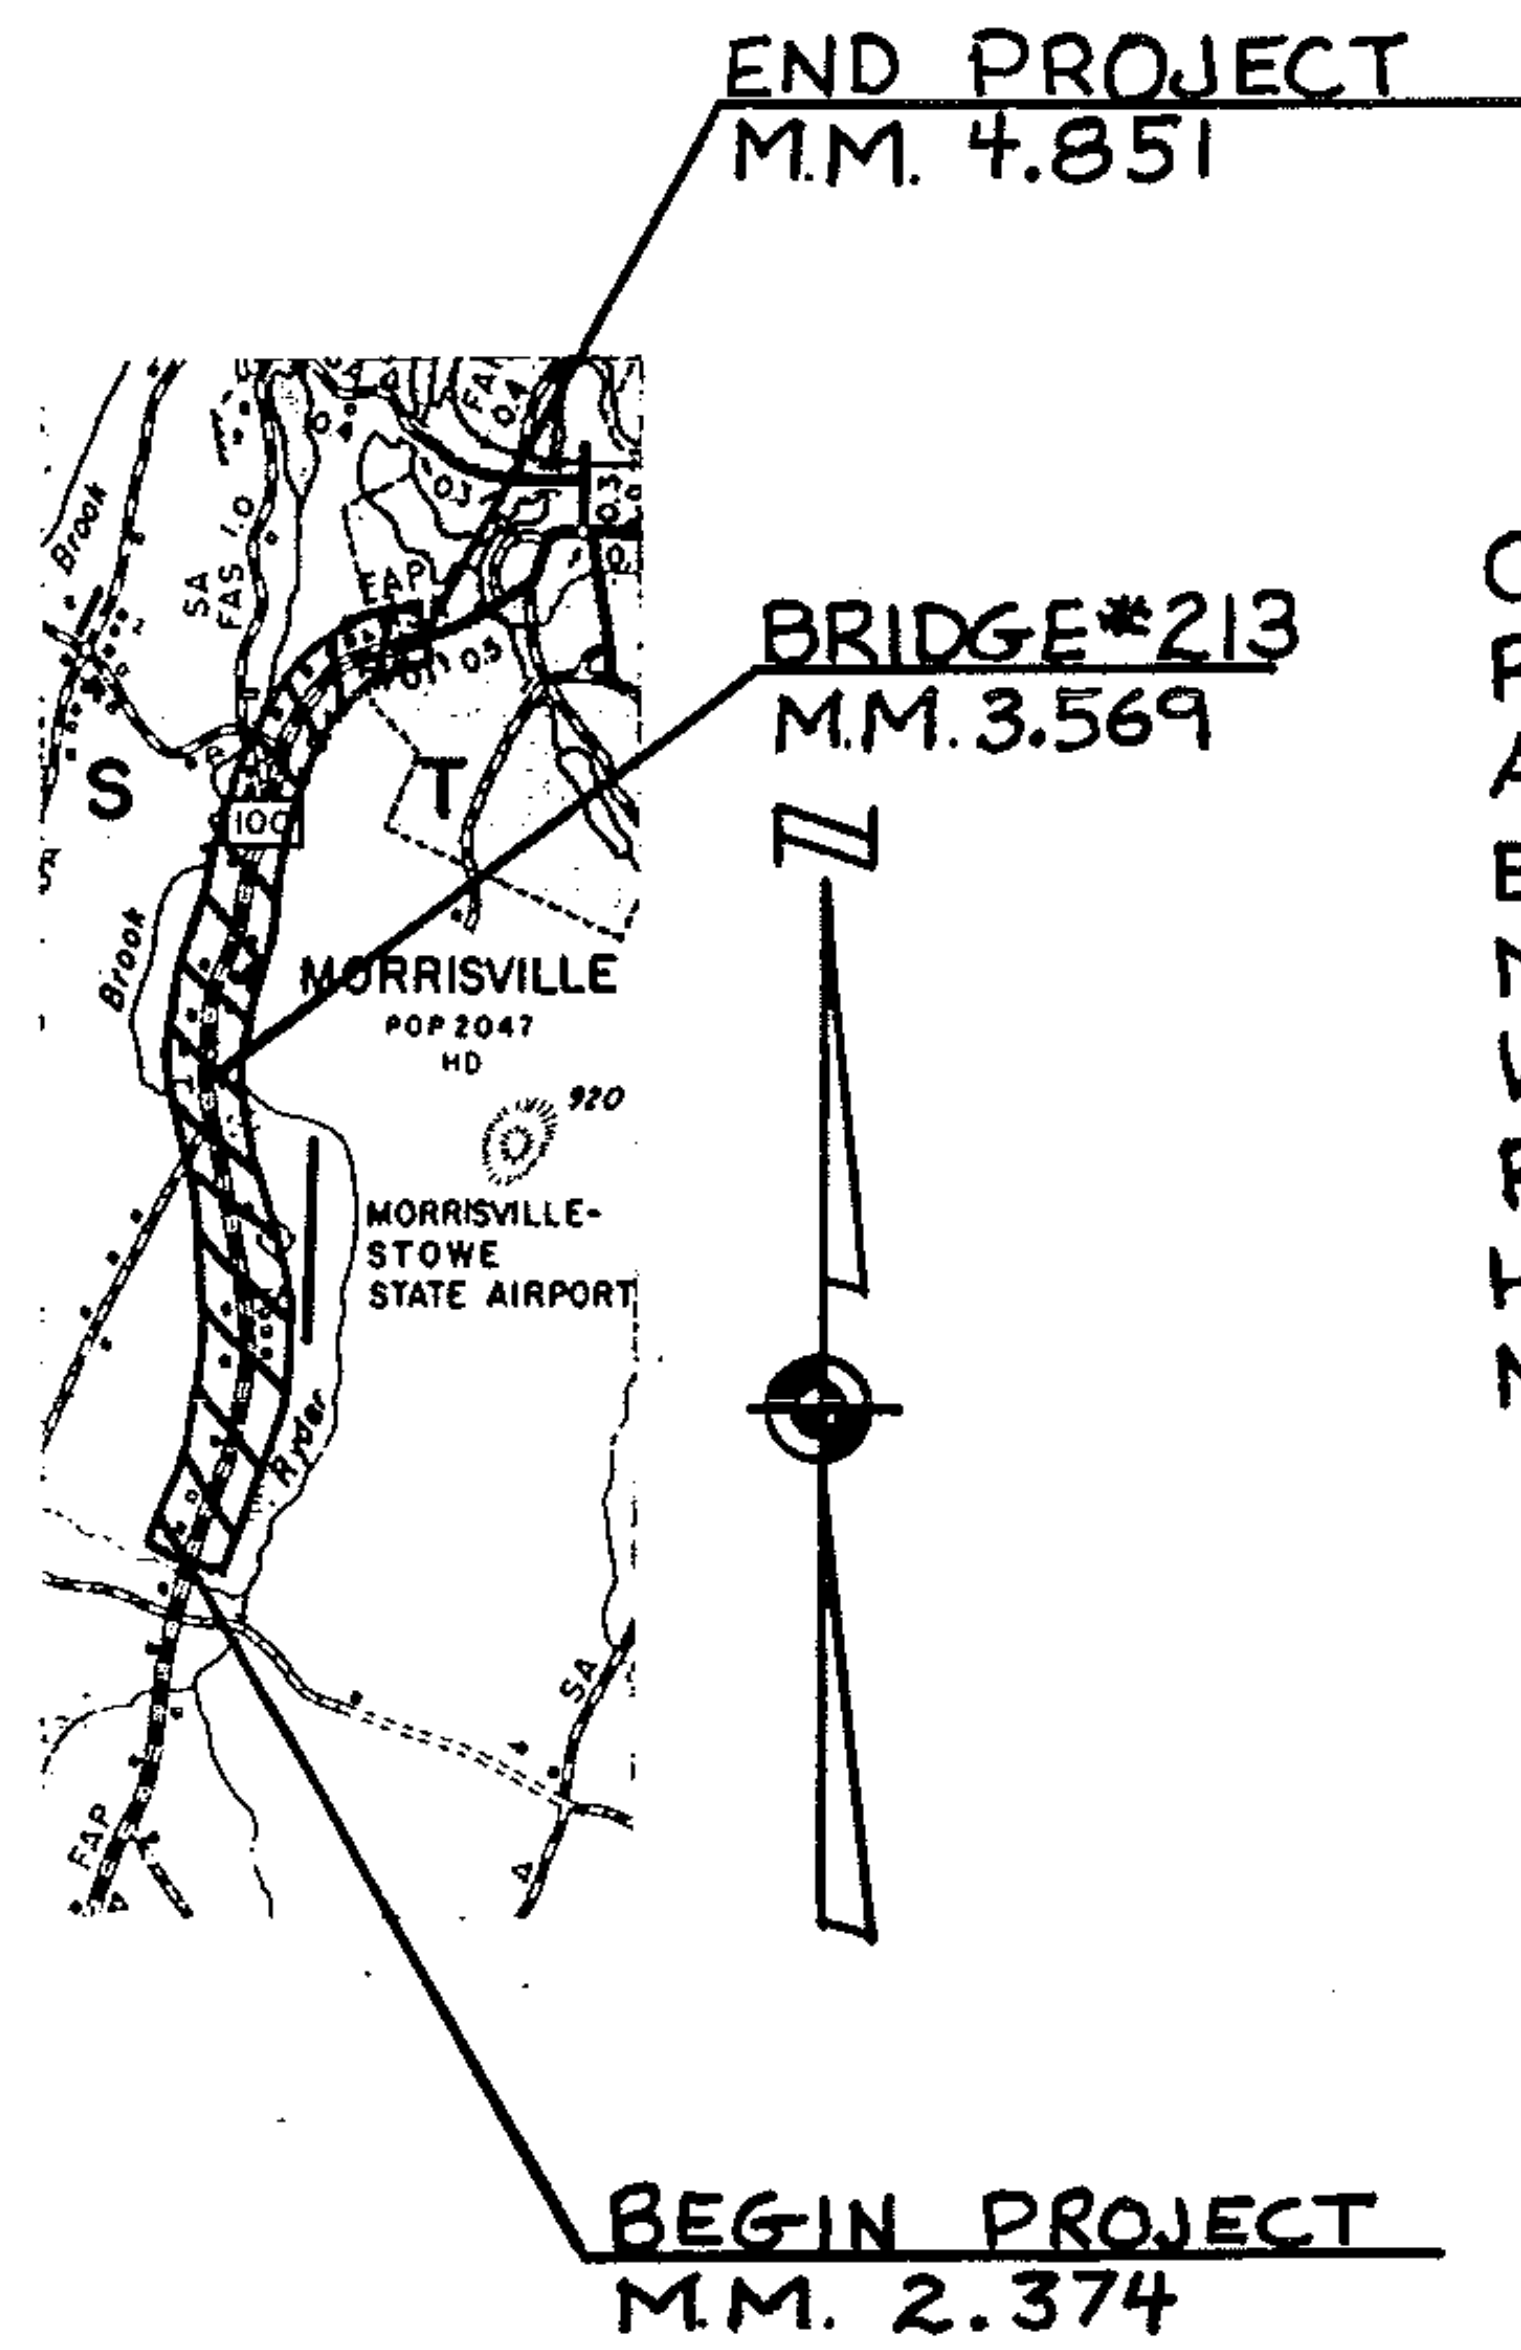

BEGINNING IN THE TOWN
OF MORRISTOWN ON
ROUTE 100 M.M. 2.374
AND EXTENDING NORTH-
ERLY 2.477 MILES TO
M.M. 4.851 IN THE
VILLAGE OF MORRISVILLE.
RESURFACING OF THE
HIGHWAY, NEW PAVEMENT
MARKINGS.

PROJECT MORRISTOWN

NO. HMA 2817

SHEET 29 OF 61 SHEETS