



PAVING LIMITS FOR DRIVES & TOWN ROADS

PAVING LIMITS FOR TOWN ROADS

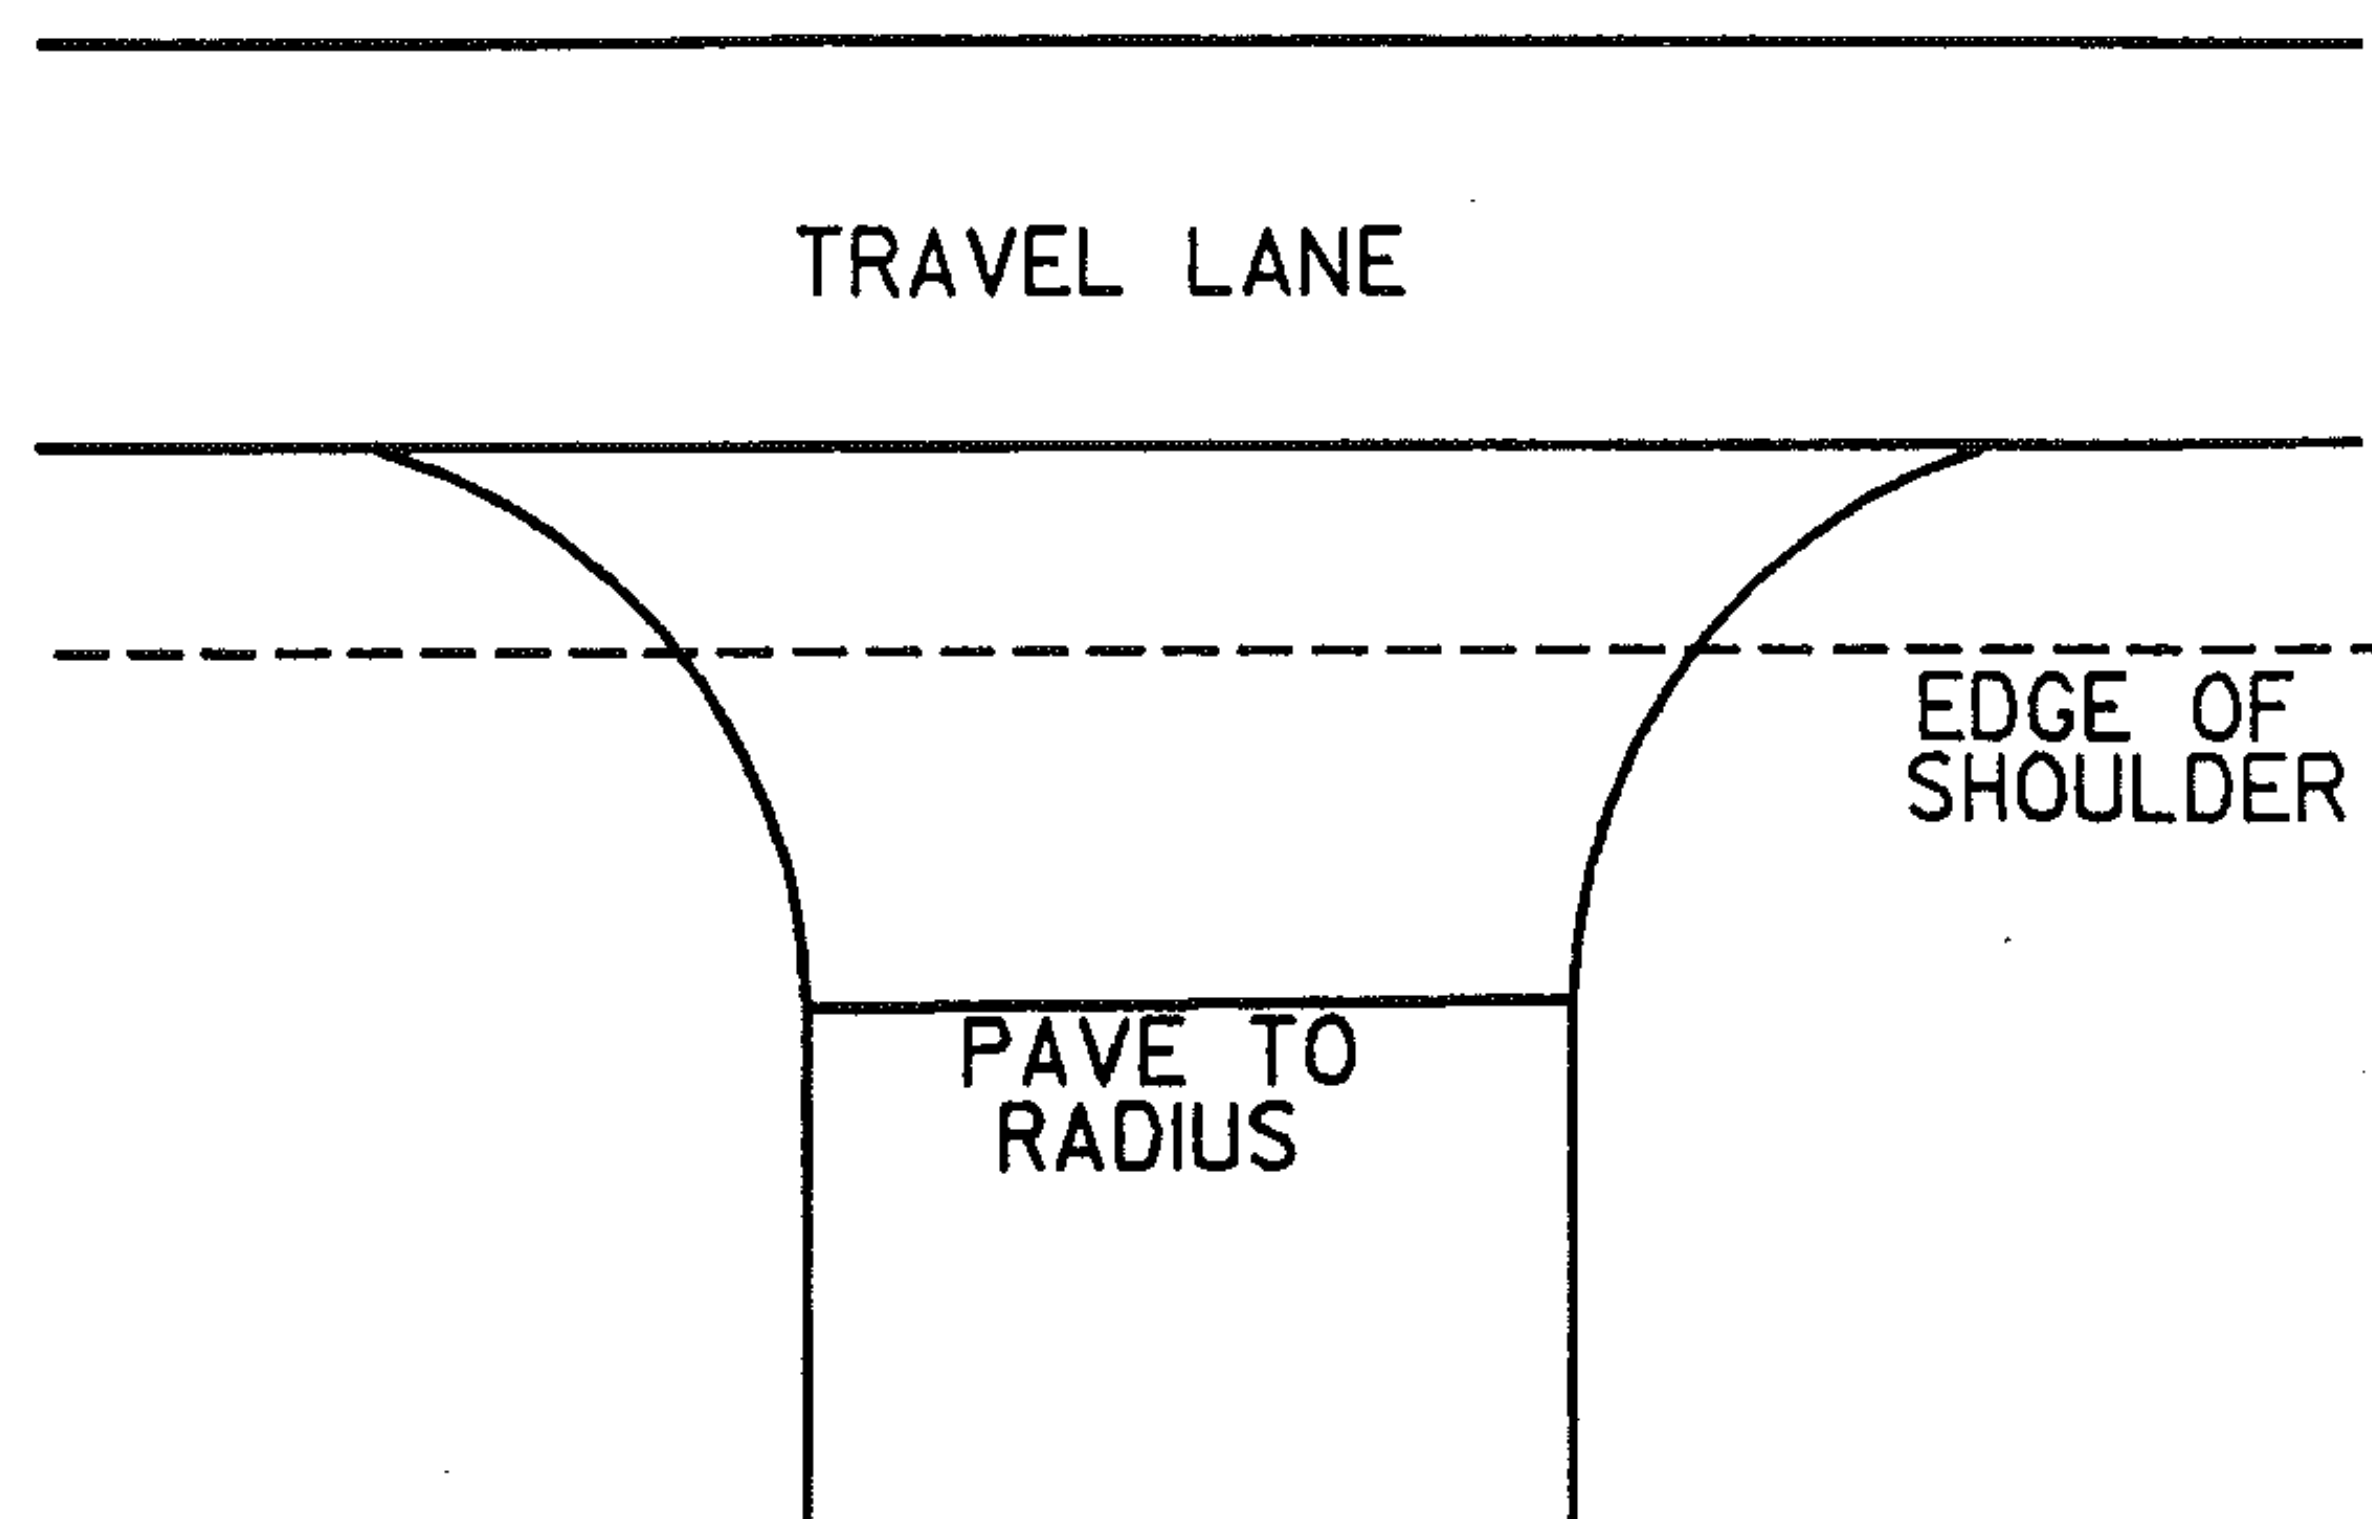

PAVING LIMITS FOR DRIVES

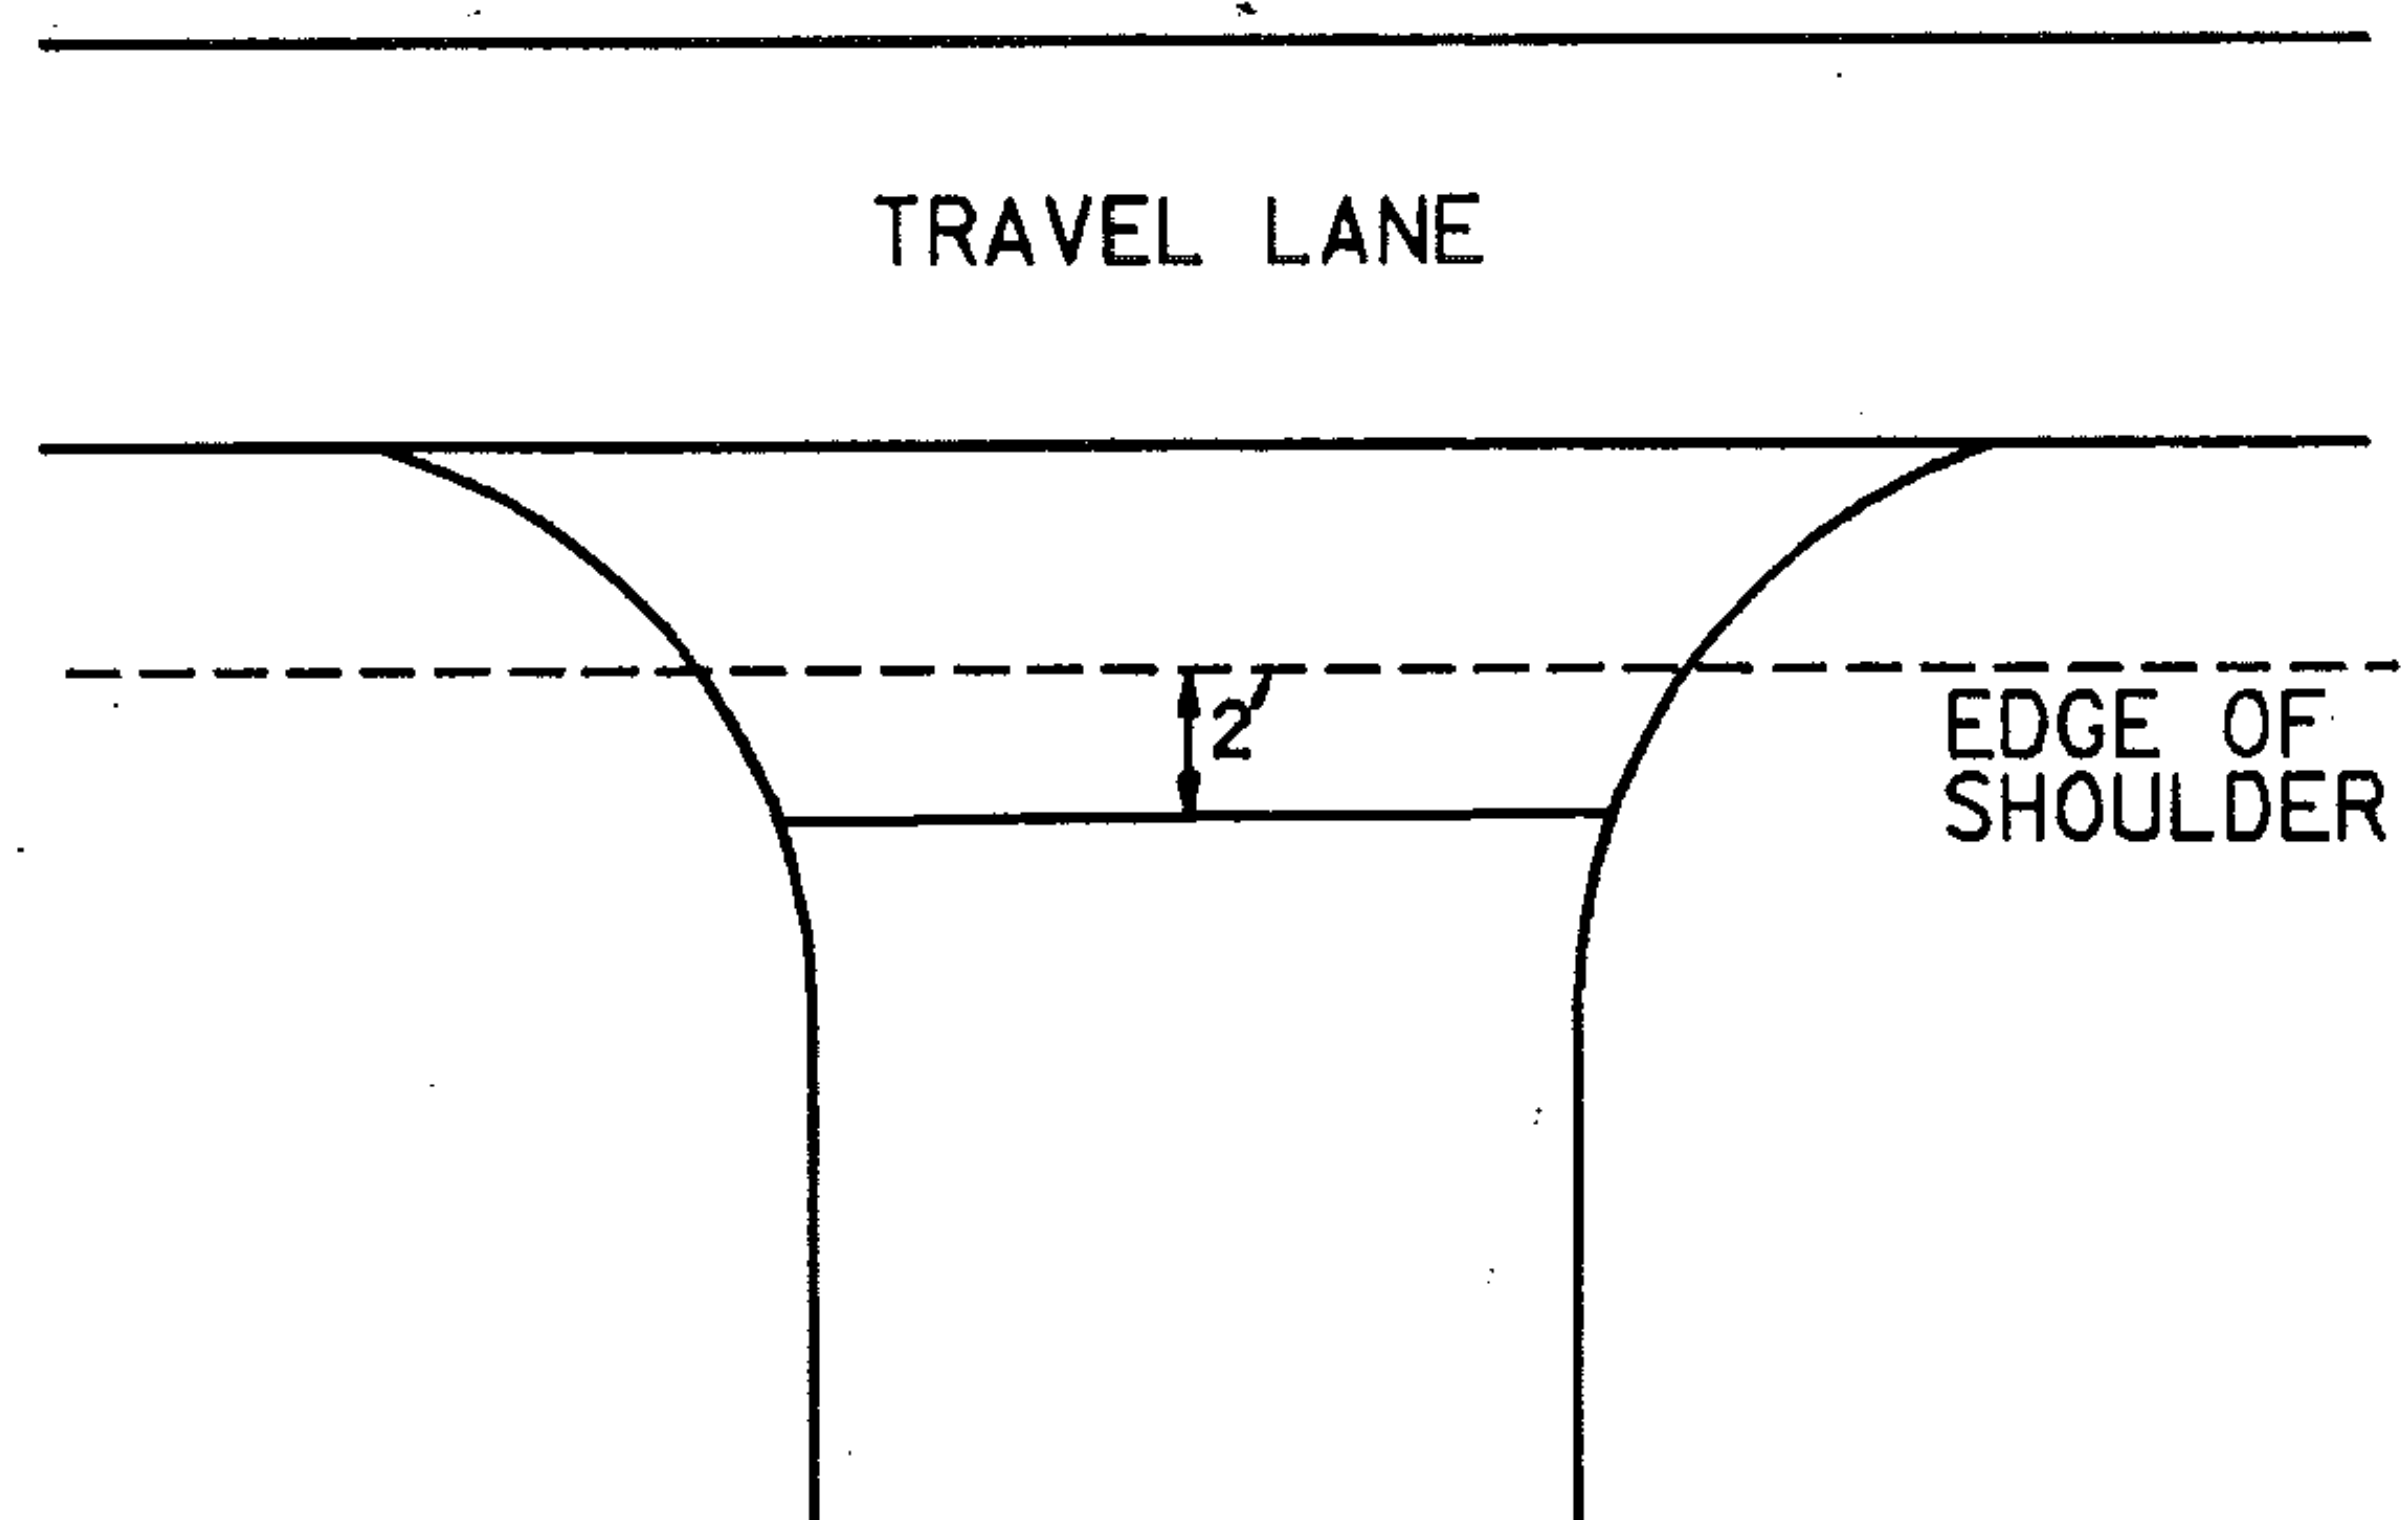

PROJECT MORRISTOWN

NO. HMA 2817

SHEET 31 OF 81 SHEETS