



SPECIAL MARKING DETAILS

Painted Island Detail

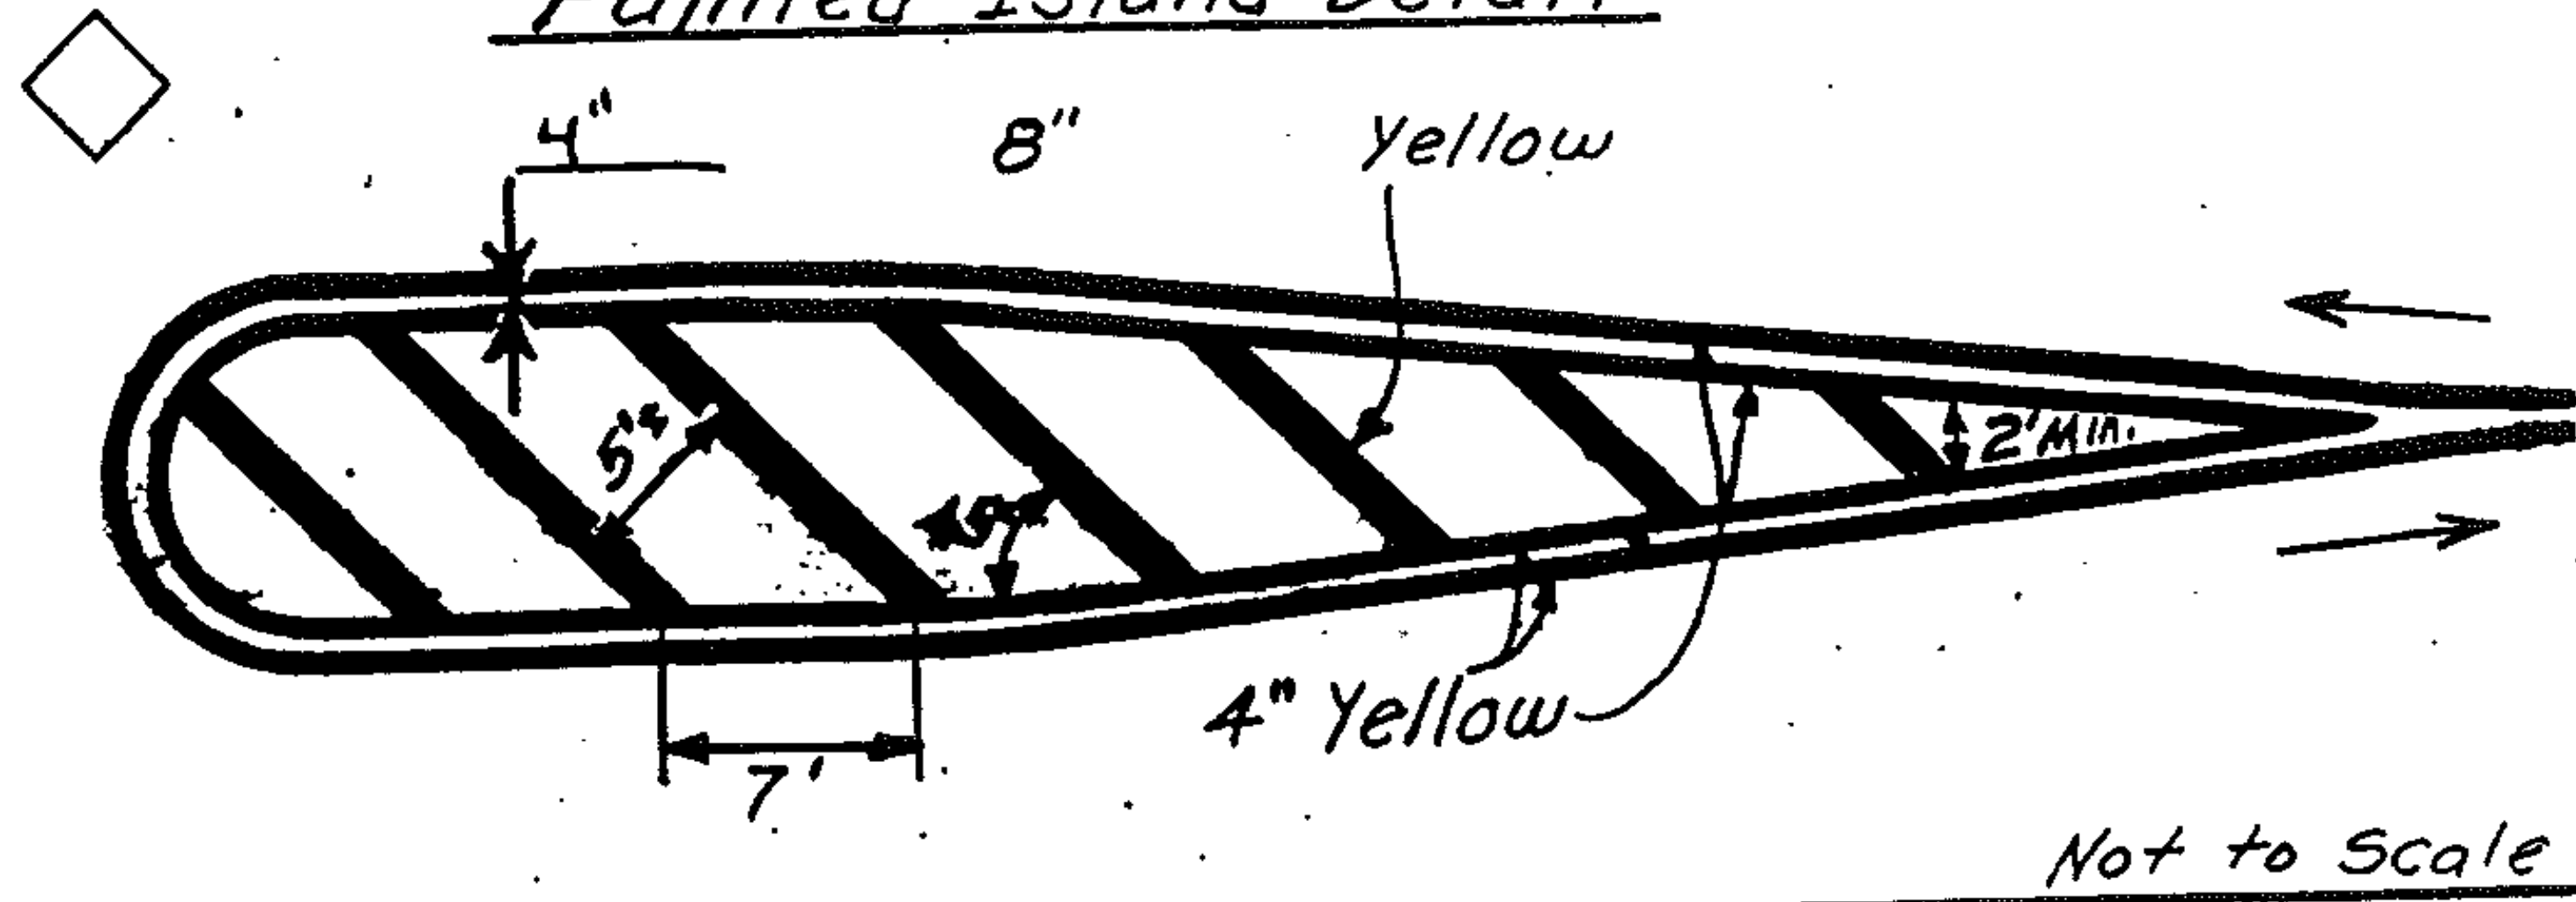

Gore Marking Detail - EXIT

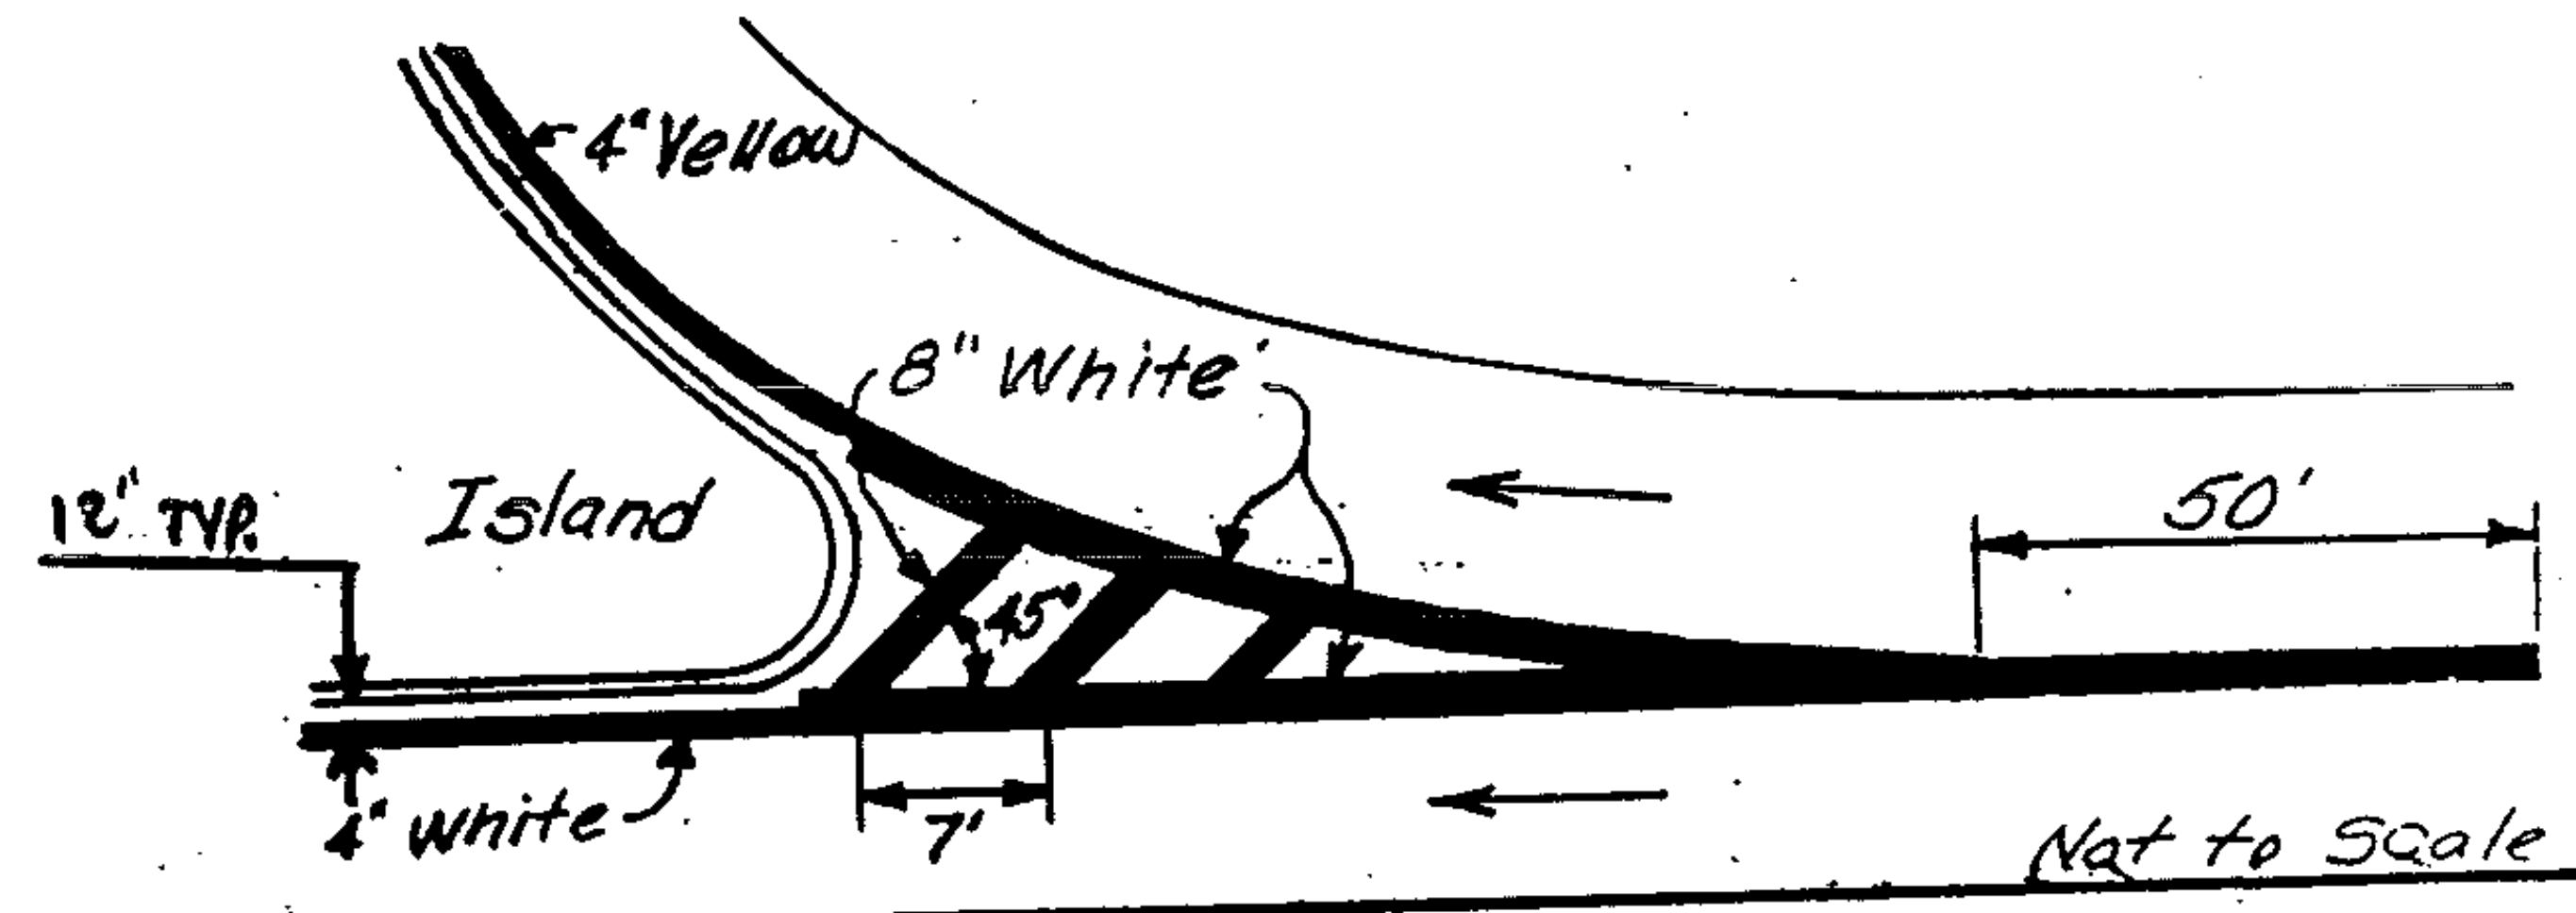

Turn Lane and Painted Curb Detail

