



PAVING LIMITS FOR TOWN ROADS & DRIVES

PAVING LIMITS FOR TOWN ROADS

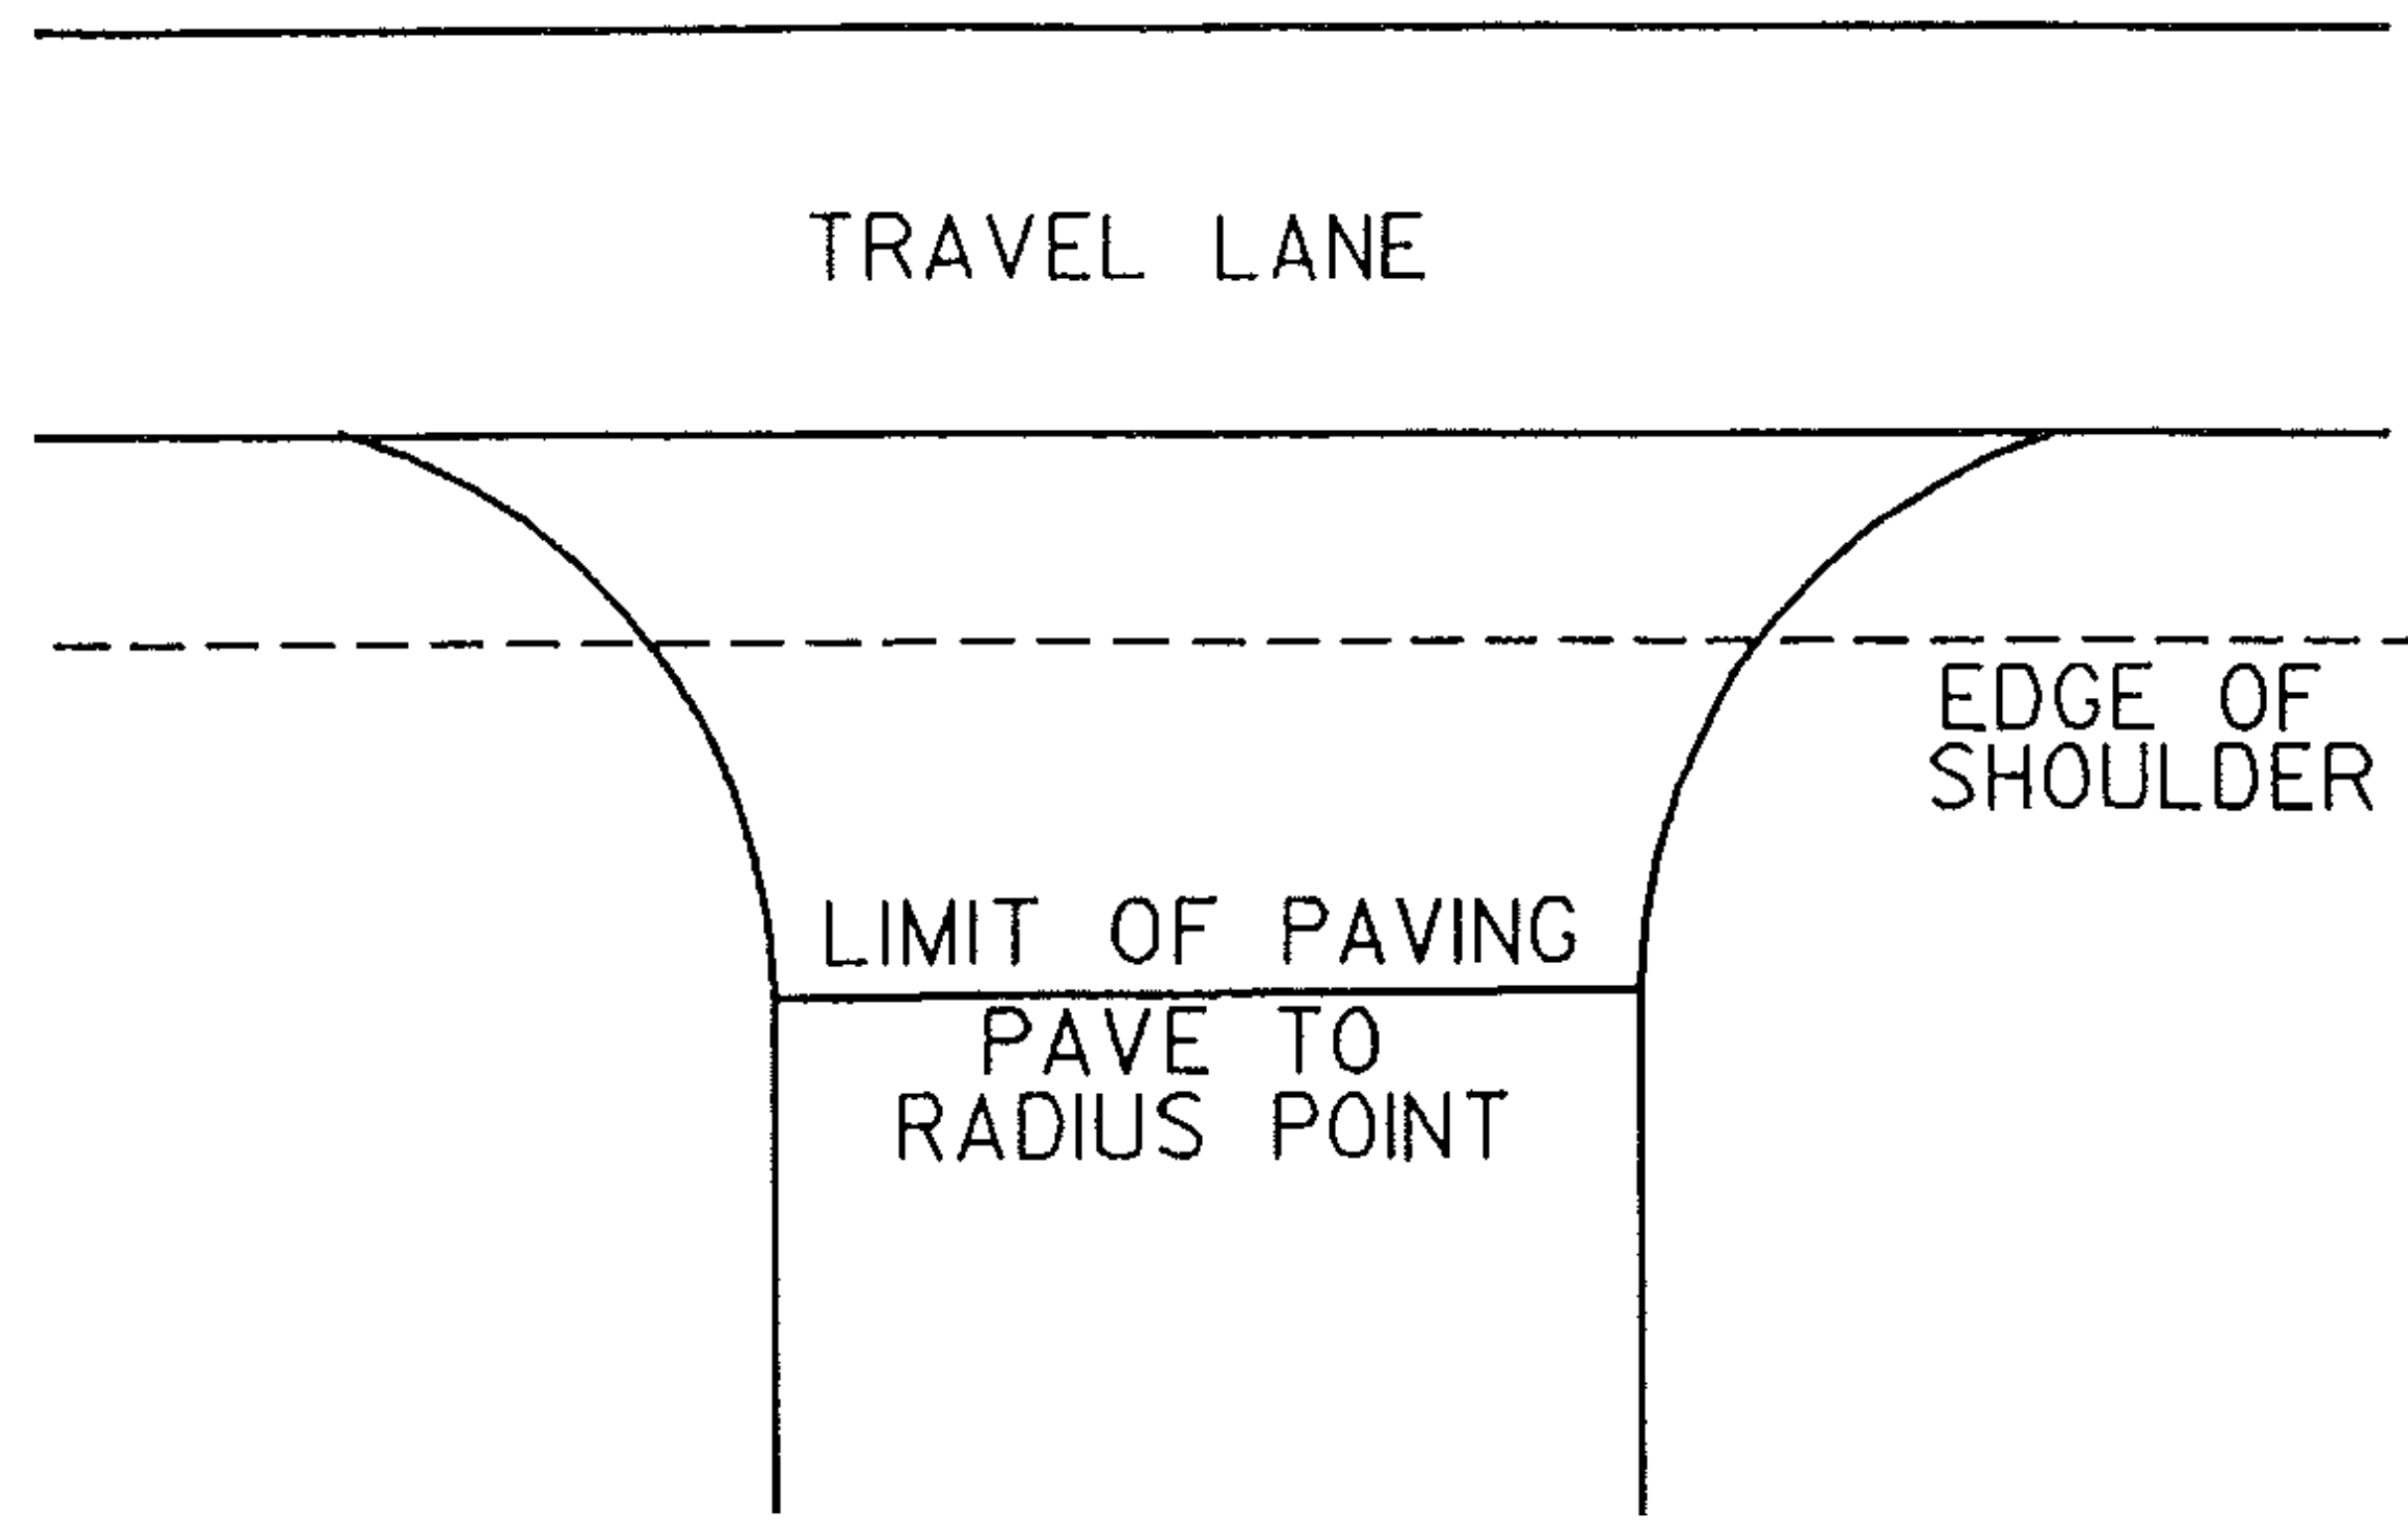

PAVING LIMITS FOR DRIVES

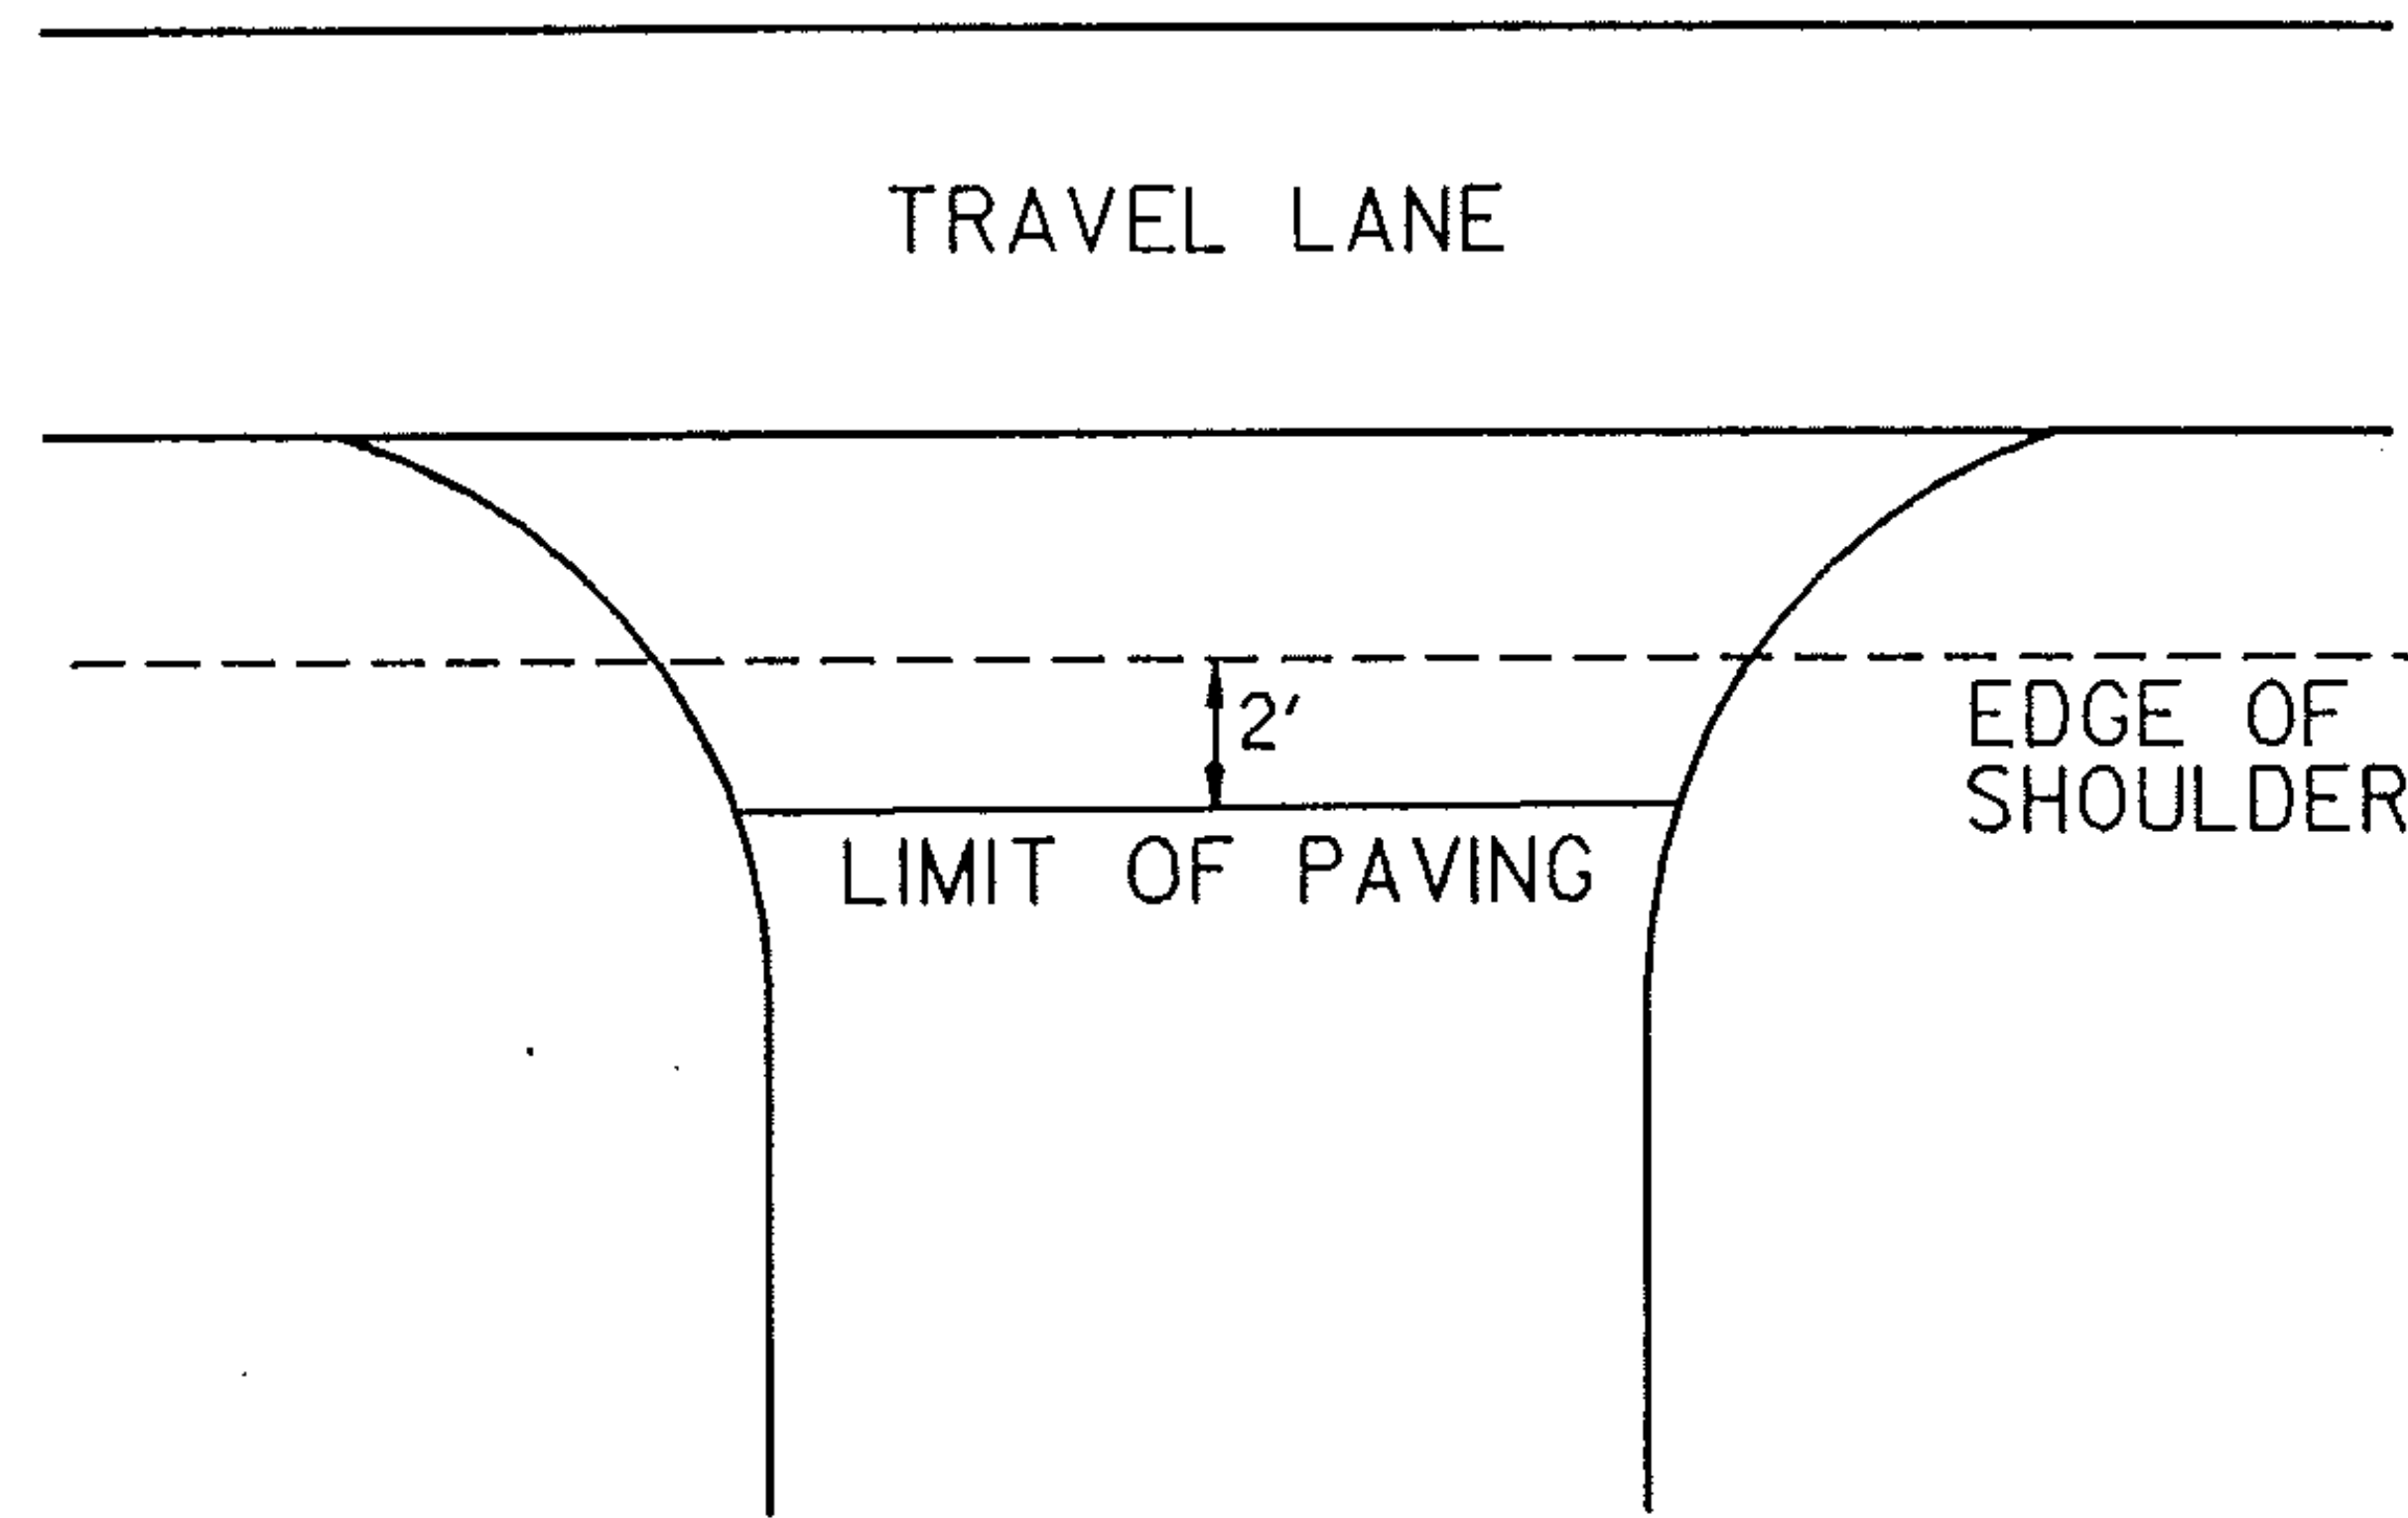

PROJECT PAVING

NO. \_\_\_\_\_

SHEET 3 OF 26 SHEETS