


DESCRIPTION AND LOCATION

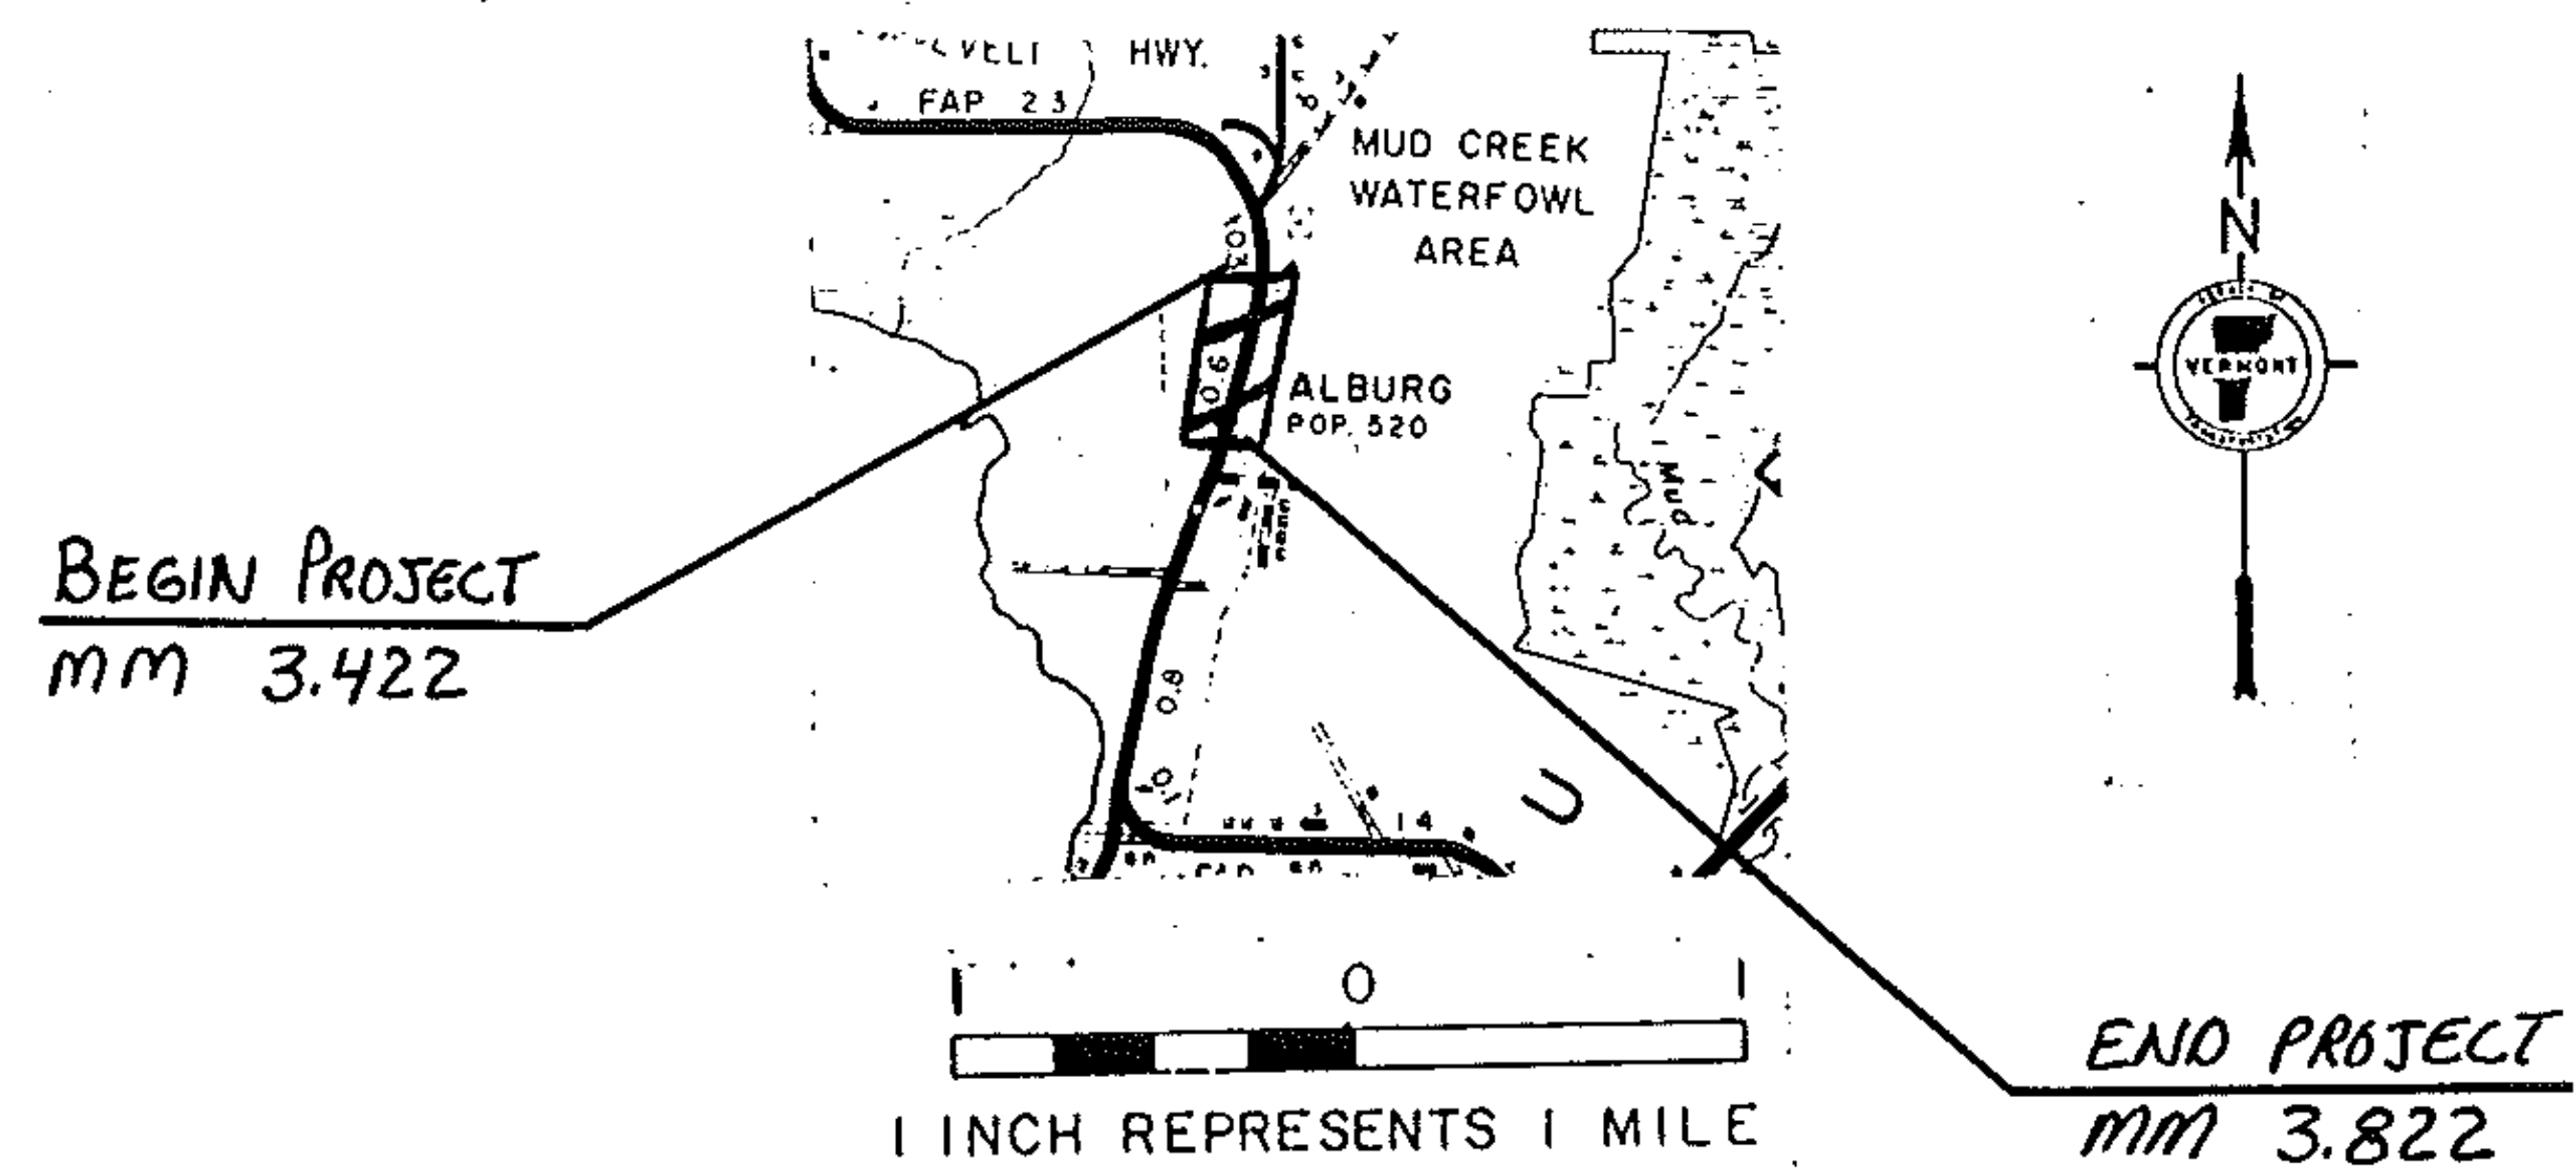

BEGINNING IN THE TOWN OF ALBURG AT MM 3.422
ON US2, AND EXTENDING SOUTHERLY 0.400 MILES TO MM 3.822.
RESURFACING AND NEW PAVEMENT MARKINGS.

LENGTH : 0.400 MILES
2112 FEET

1984 AOT : 4230

PROJECT ALBURG

NO. HMA 2846

SHEET 26 OF 60 SHEETS