


DESCRIPTION AND LOCATION

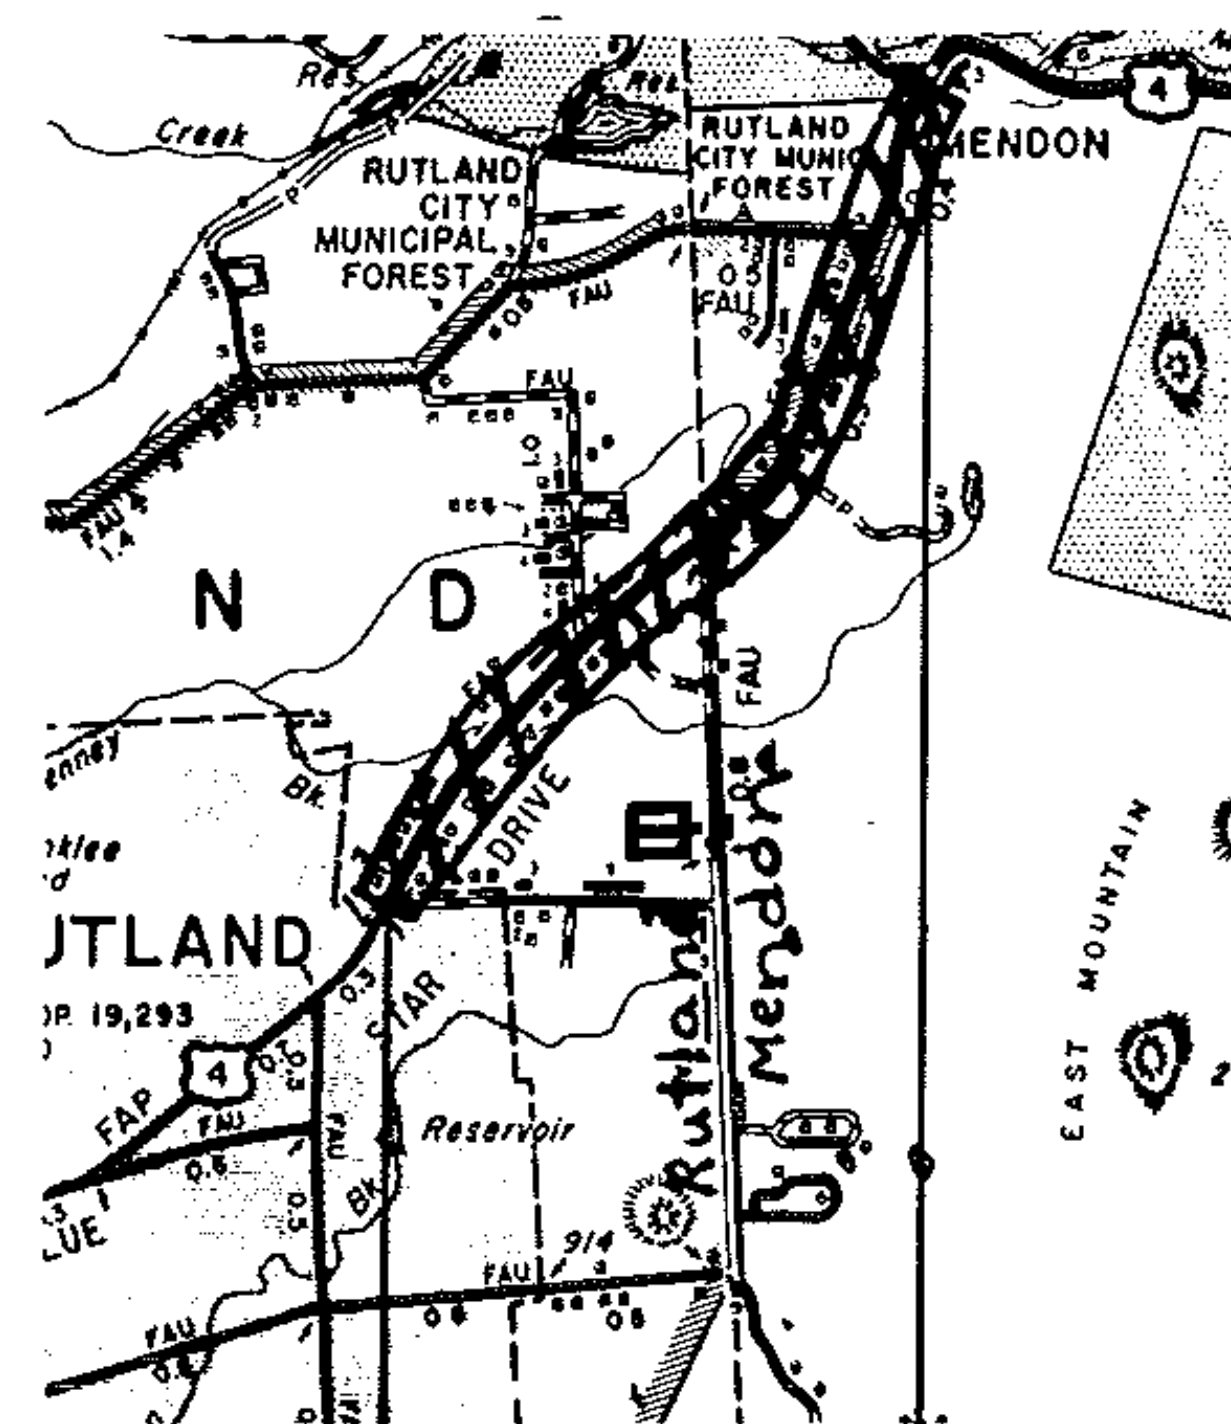

scale: 1" = 1 mile

End Project HMA 2847
MM 1.254

Begin Project HMA 2847
MM 0.997

Beginning at a point on US 4, 0.997 miles easterly of the West Rutland-Rutland town line and extending 2.488 miles easterly to MM 1.254 in the town of Mendon

Work consists of resurfacing of the highway, including shoulders and new pavement markings

1986 ADT 9770

length of Project 2.488 miles
13130 feet

PROJECT Rutland-Mendon

NO. HMA 2847

SHEET 3 OF 12 SHEETS

SHEET 59 OF 75 SHEETS