


# DESCRIPTION AND LOCATION

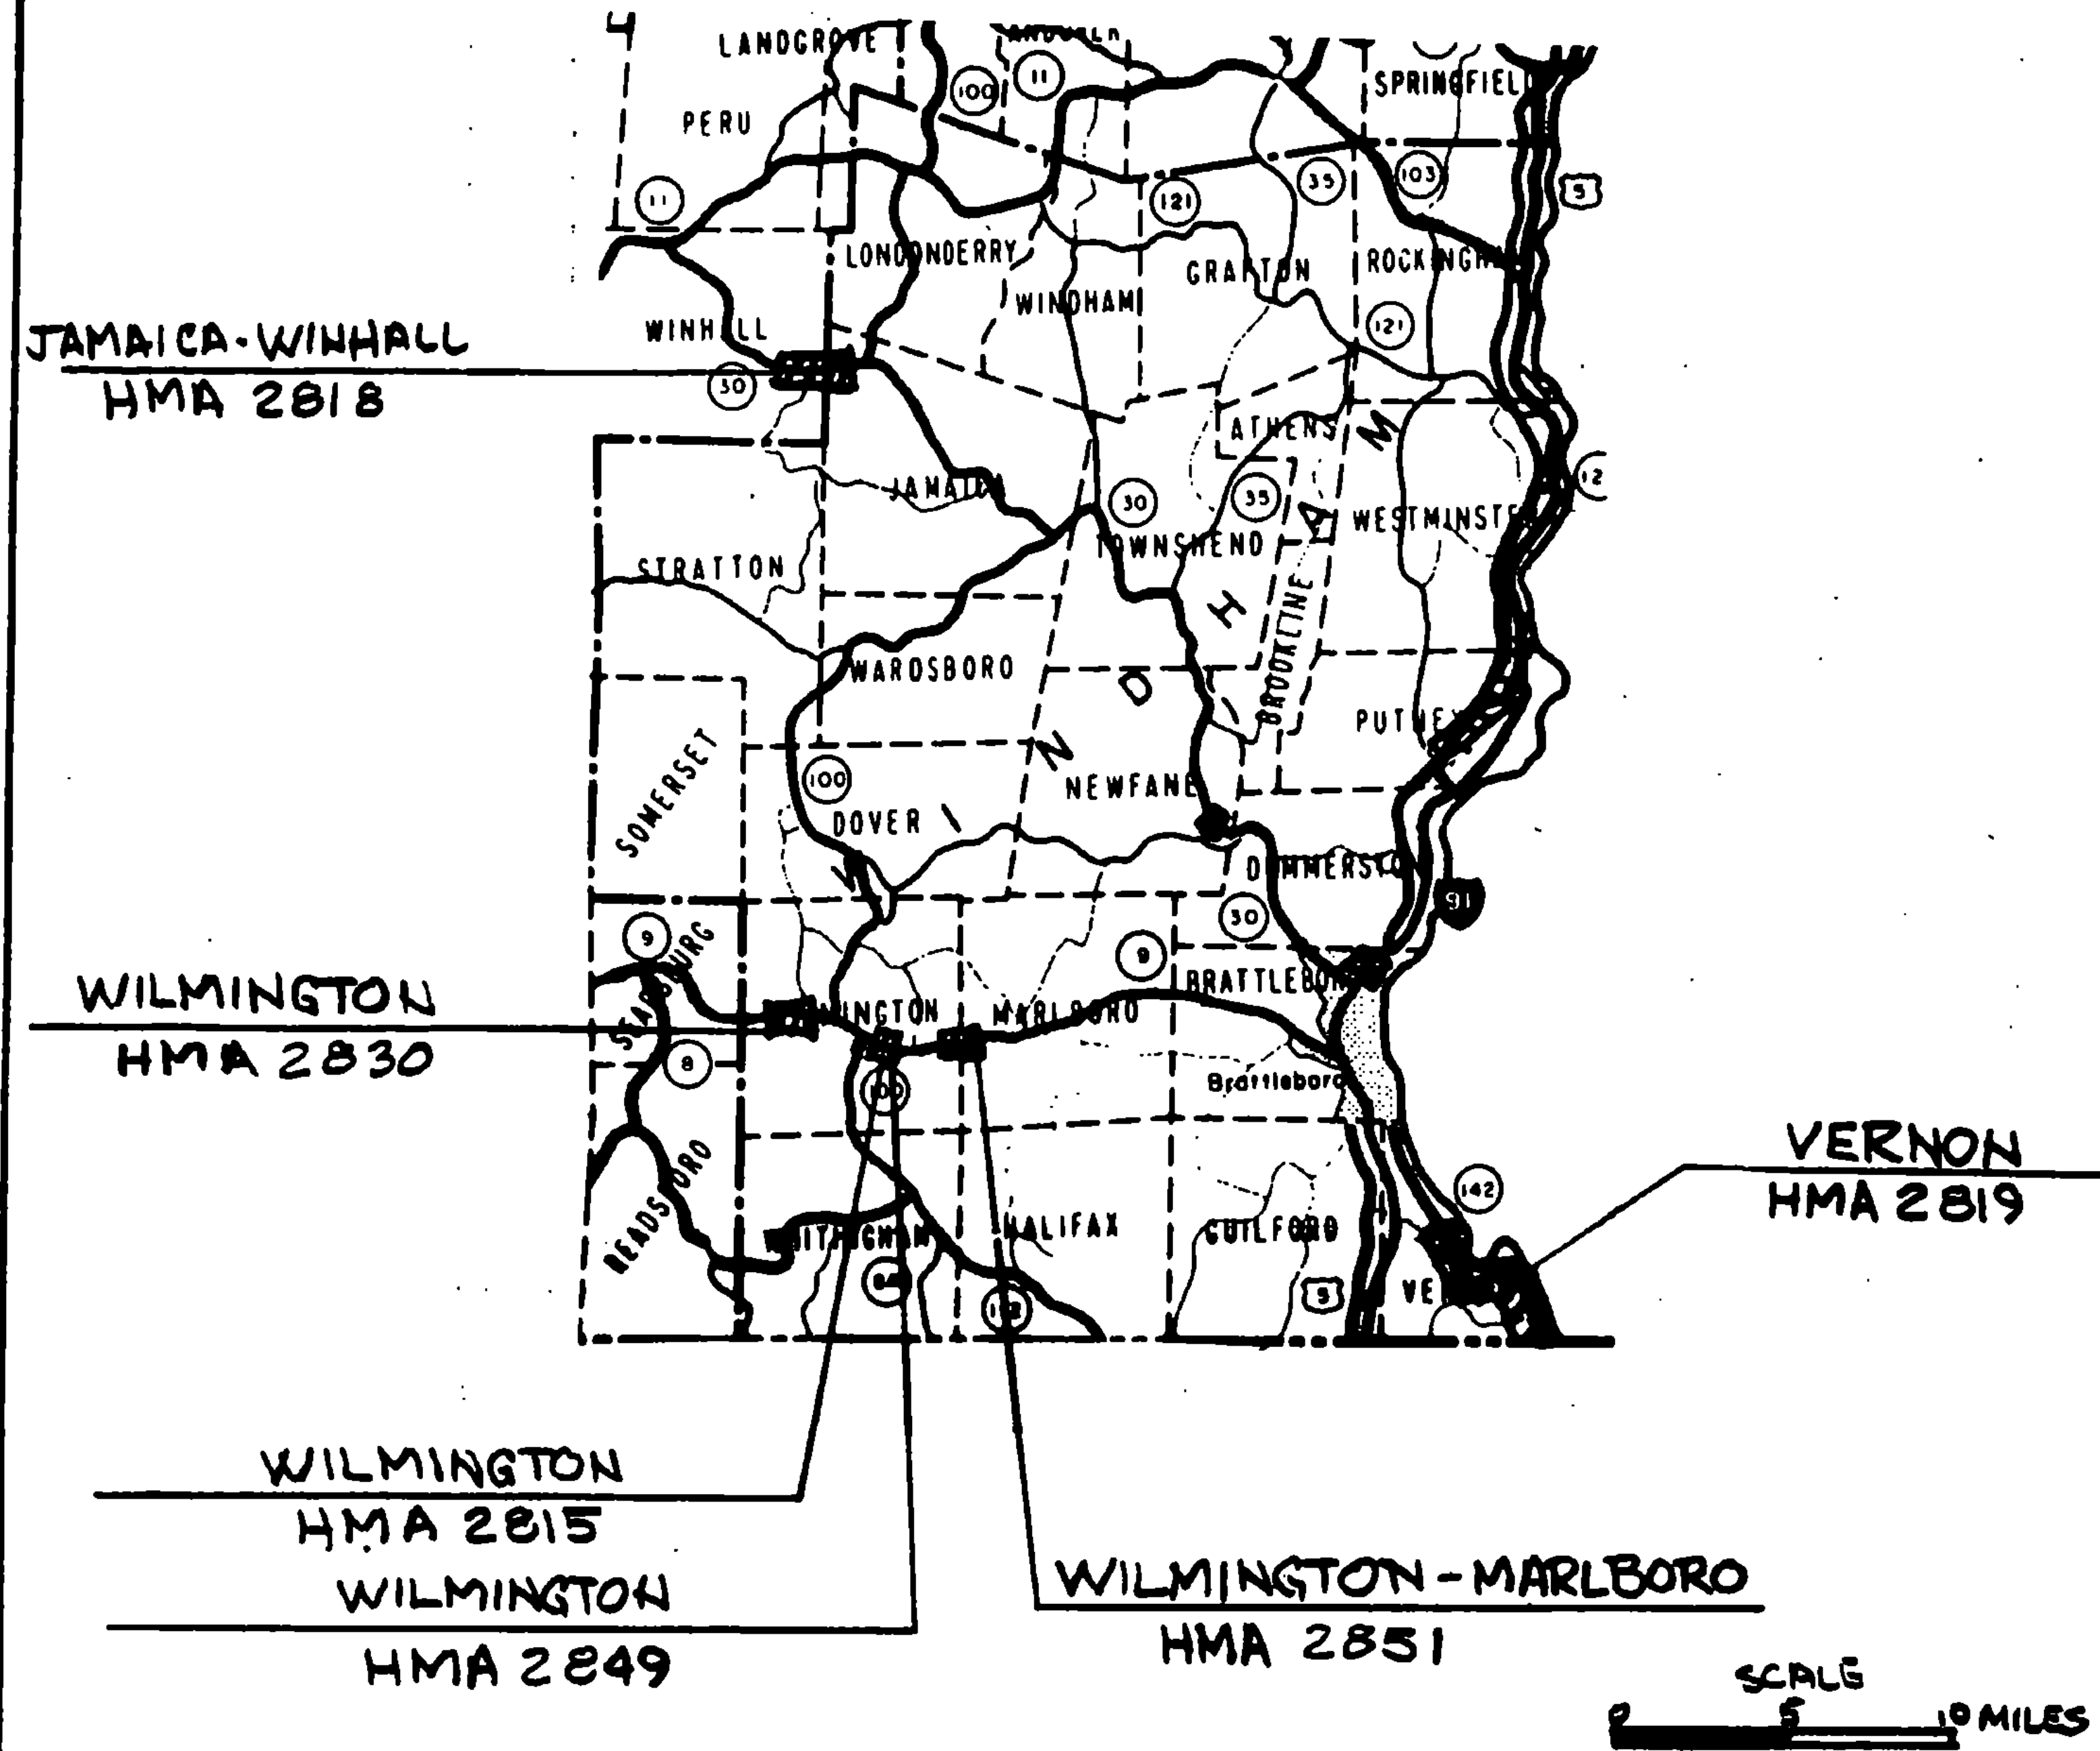

PROJECT	OVERLAY DEPTH	BEGIN	END	LENGTH (FT)	LENGTH (MI)
JAMAICA-WINHALL HMA 2818	1 1/4"	JAMAICA 2.525	WINHALL 2.096	16030.080	3.036
VERNON HMA 2819	1 1/4"	0.000	6.800	35904.000	6.800
WILMINGTON HMA 2830	1 1/4"	1.270	1.978	3738.24	0.708
WILMINGTON HMA 2815	1 1/4"	4.283	4.500	1145.76	0.217
WILMINGTON HMA 2849	1 1/4"	4.500	5.157	3468.960	0.657
WILMINGTON-MARLBORO HMA 2851	1 1/4"	WILMINGTON 7.118	MARLBORO 0.970	3315.840	0.628
<b>TOTALS</b>				<b>63,602.88</b>	<b>12.046</b>

NO. HMA PAVING  
SHEET 3 OF 64 SHEETS

PROJECT 1987 DIST. 2 PAVING