


SHOULDER DETAIL SHEET

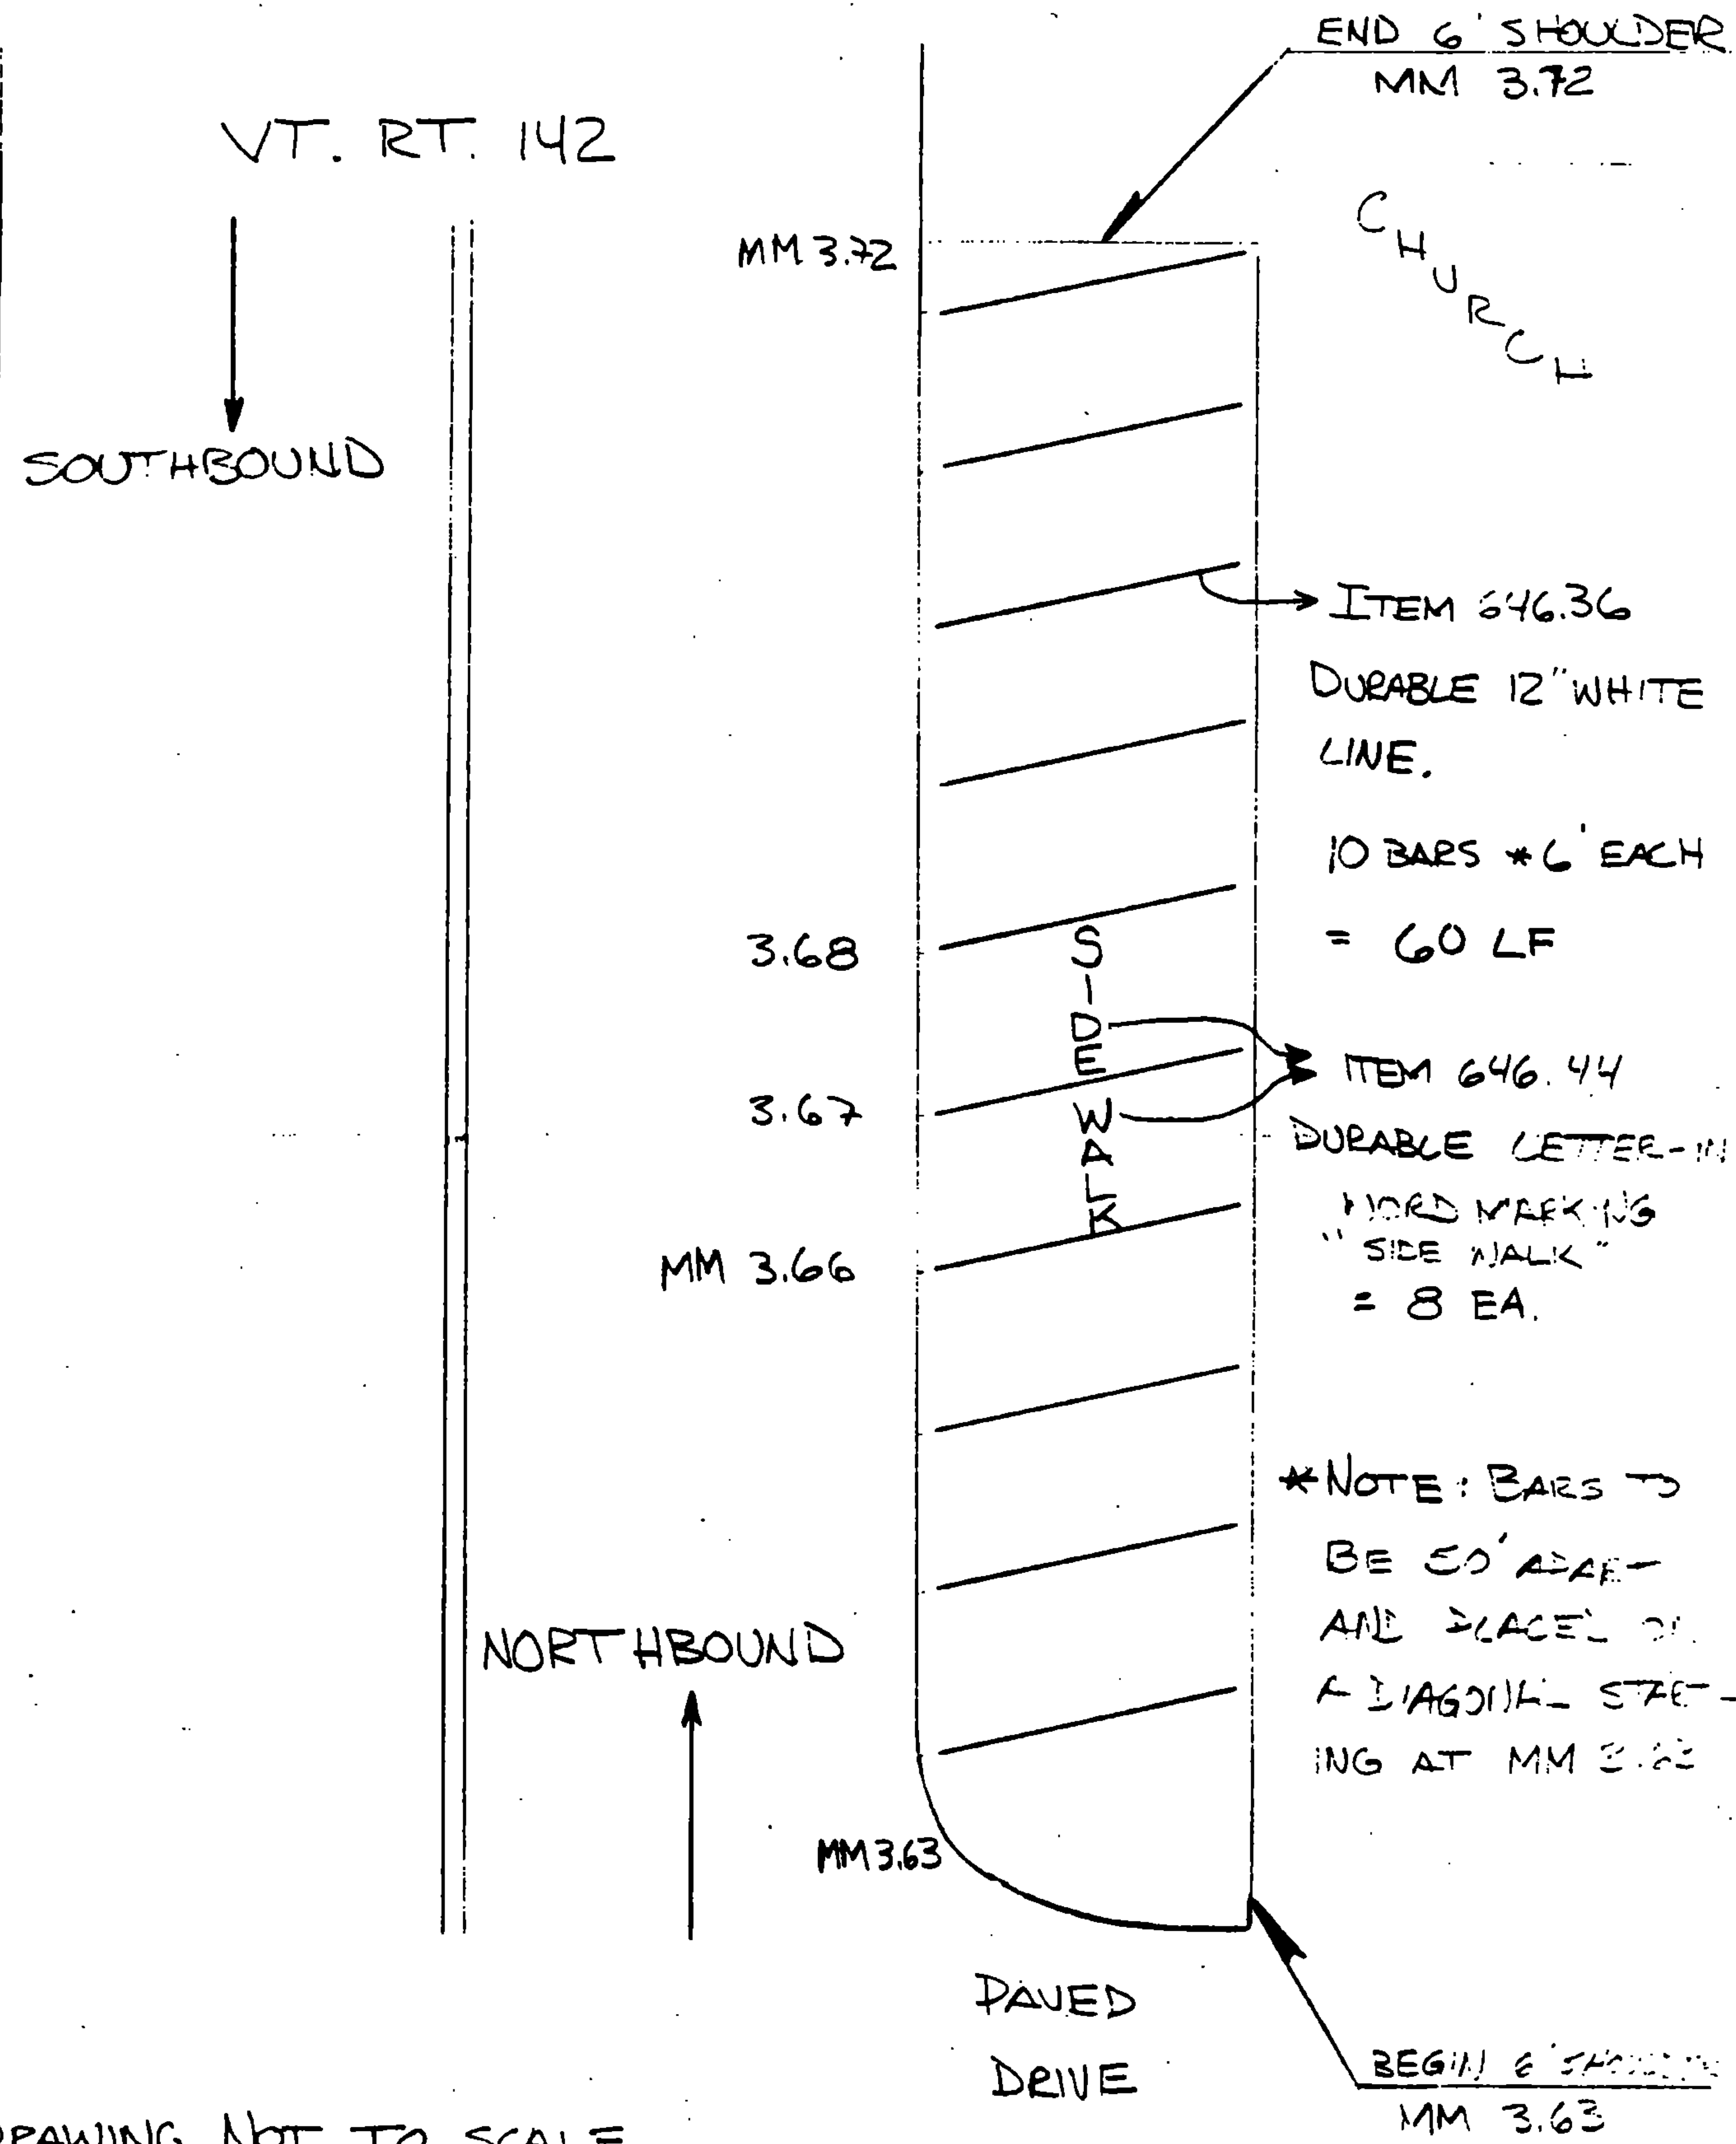

NOTE: DRAWING NOT TO SCALE

PROJECT VERNON

NO. HMA 7819
 SHT. 29 OF 64 SHTS.
 SHT. 10 OF 10 SHTS.