


TYPICAL SECTIONS & DESIGN DATA

WILMINGTON 4.500 ~ 5.157
ITEM 406.25 BITUMINOUS CONCRETE PAVEMENT
LEVELING COURSE TYPE IV (518 TONS/MILE)
1/4" WEARING COURSE TYPE III ($\pm 1/4"$)
AS DIRECTED BY THE ENGINEER
NOTE: ROADWAY IS CURRENTLY STRIPED
12' 6".

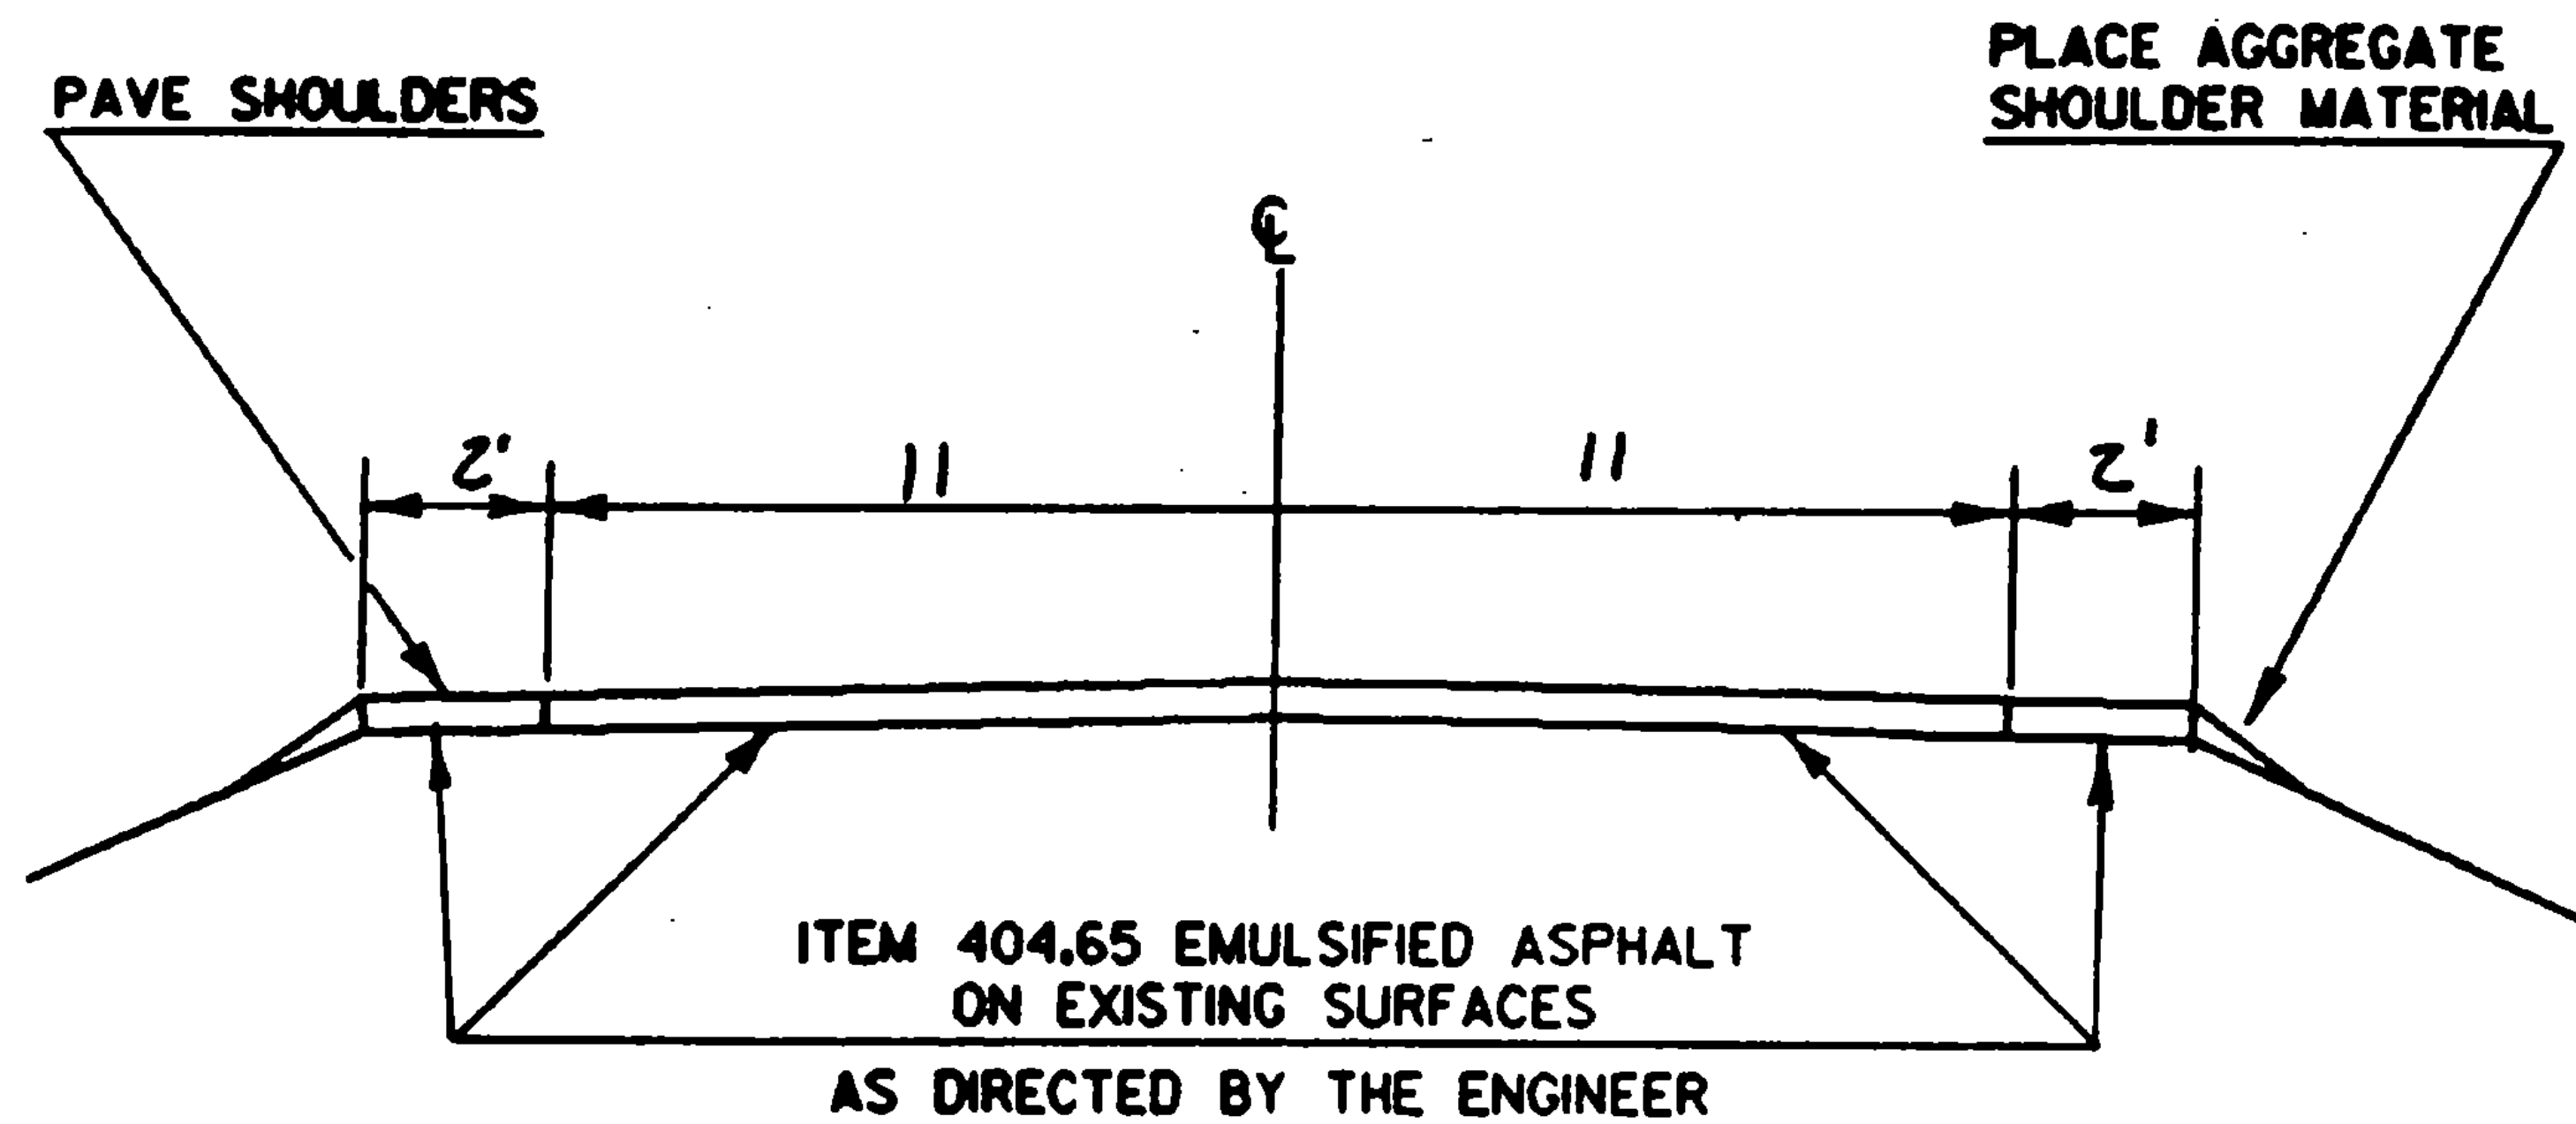

PROJECT WILMINGTON

No. HMA 2849

SHEET 4 OF 7 SHEETS

SHEET 46 OF 64 SHEETS