


# TYPICAL SECTIONS & DESIGN DATA

WILMINGTON MM 7.118 ~ MARLBORO MM 0.280  
ITEM 406.25 BITUMINOUS CONCRETE PAVEMENT  
LEVELING COURSE TYPE IV (341 TONS/MILE )  
1/4" WEARING COURSE TYPE III ( $\pm 1/4"$ )  
AS DIRECTED BY THE ENGINEER

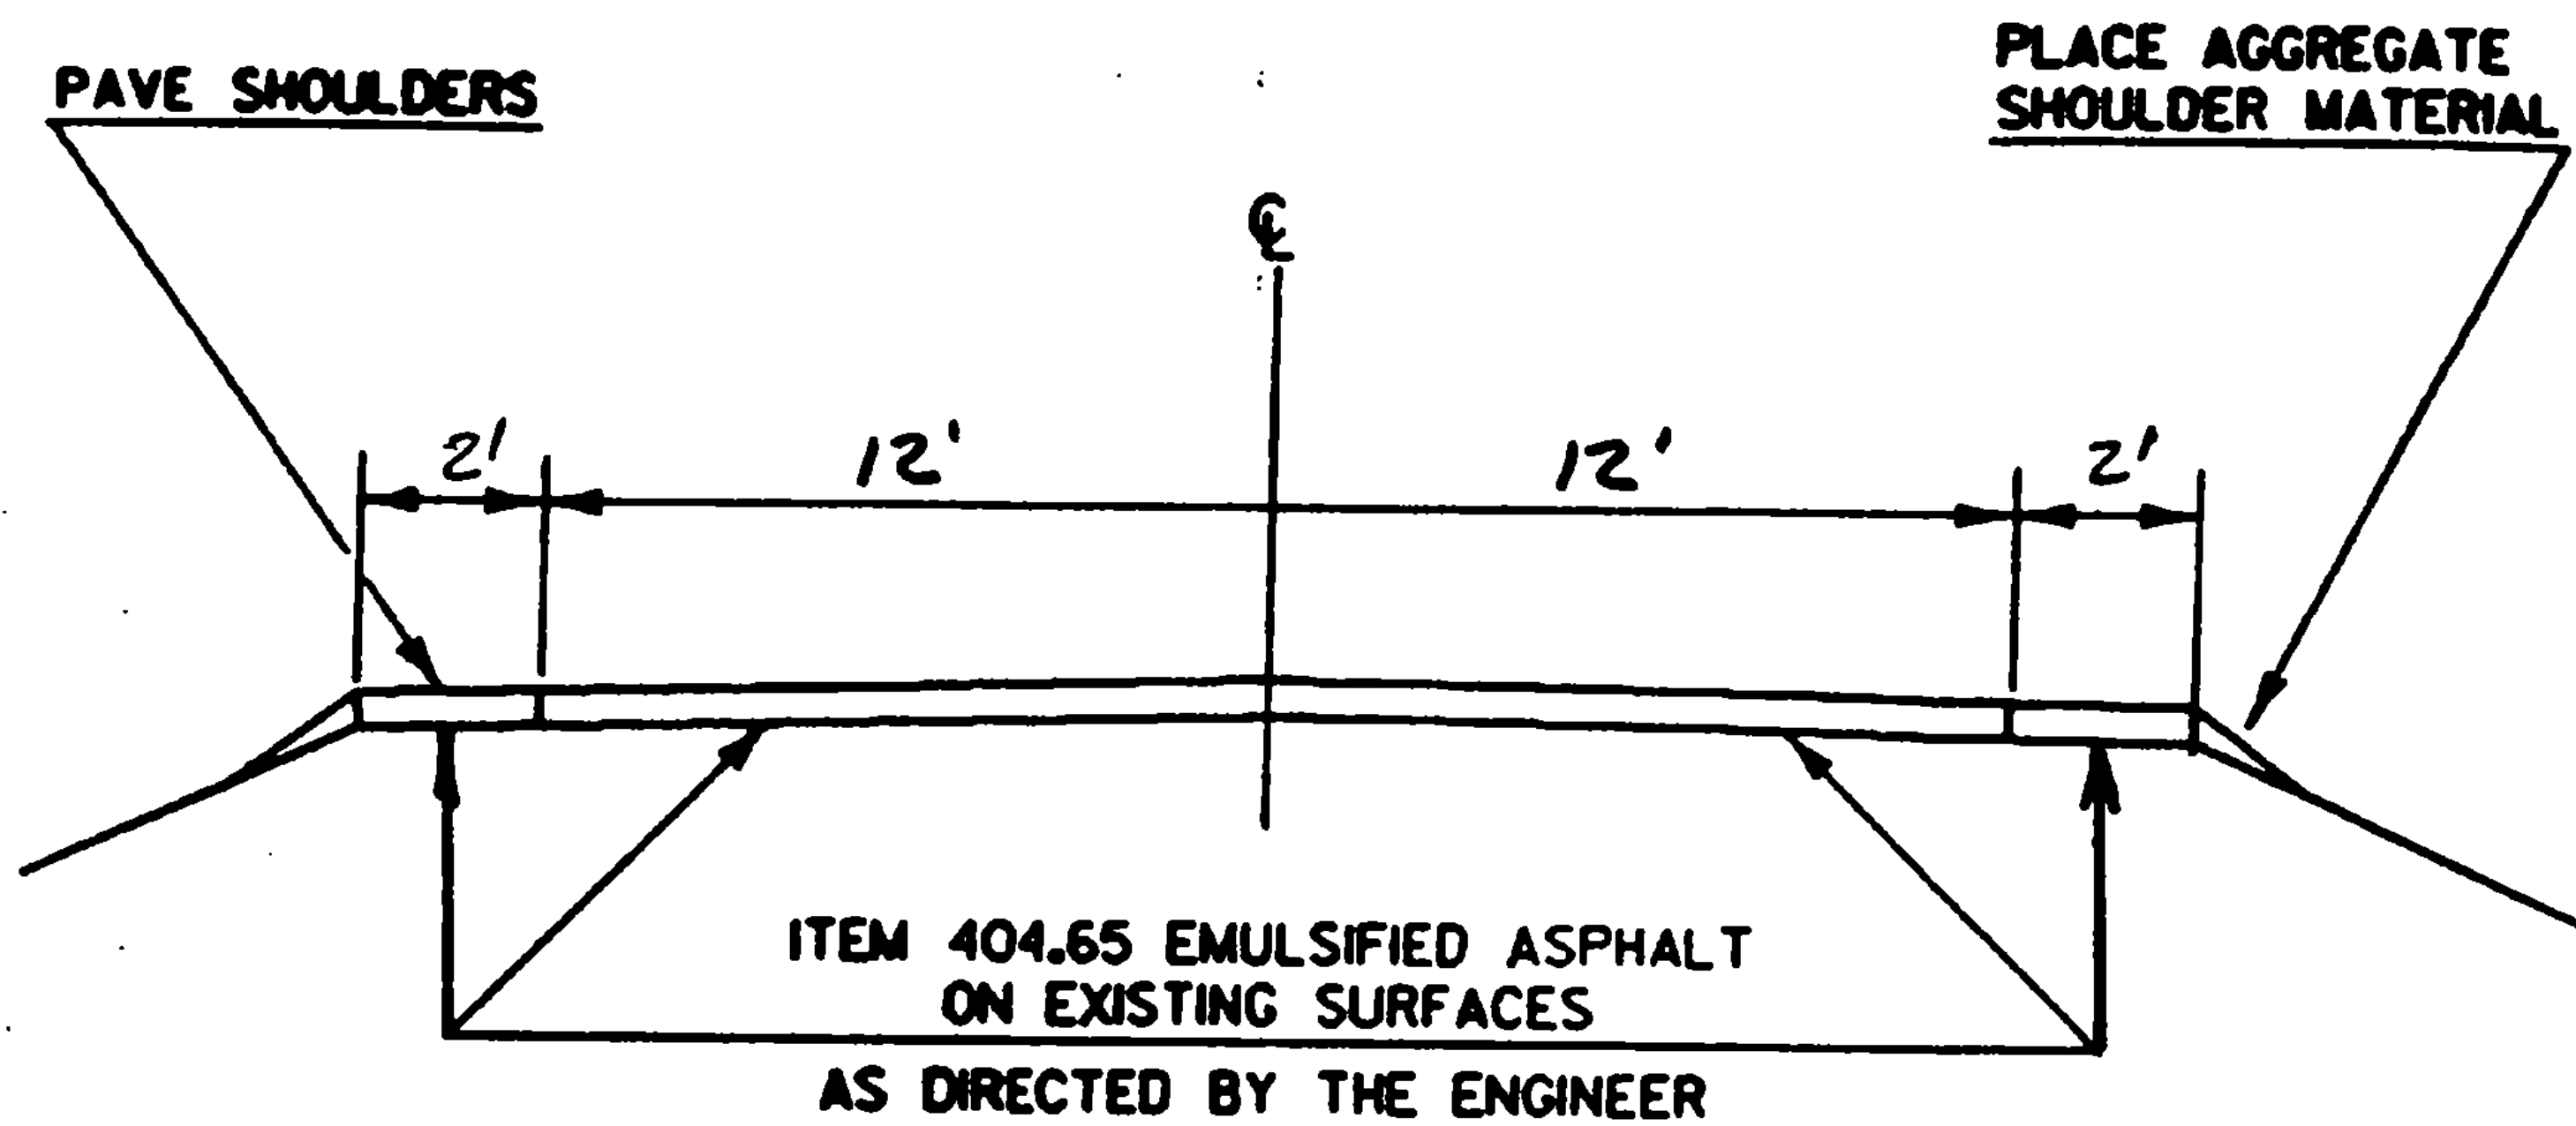

PROJECT WILMINGTON-MARLBORO

NO. HMA 2851

SHEET 4 OF 8 SHEETS

SHEET 53 OF 64 SHTS