


DESCRIPTION AND LOCATION

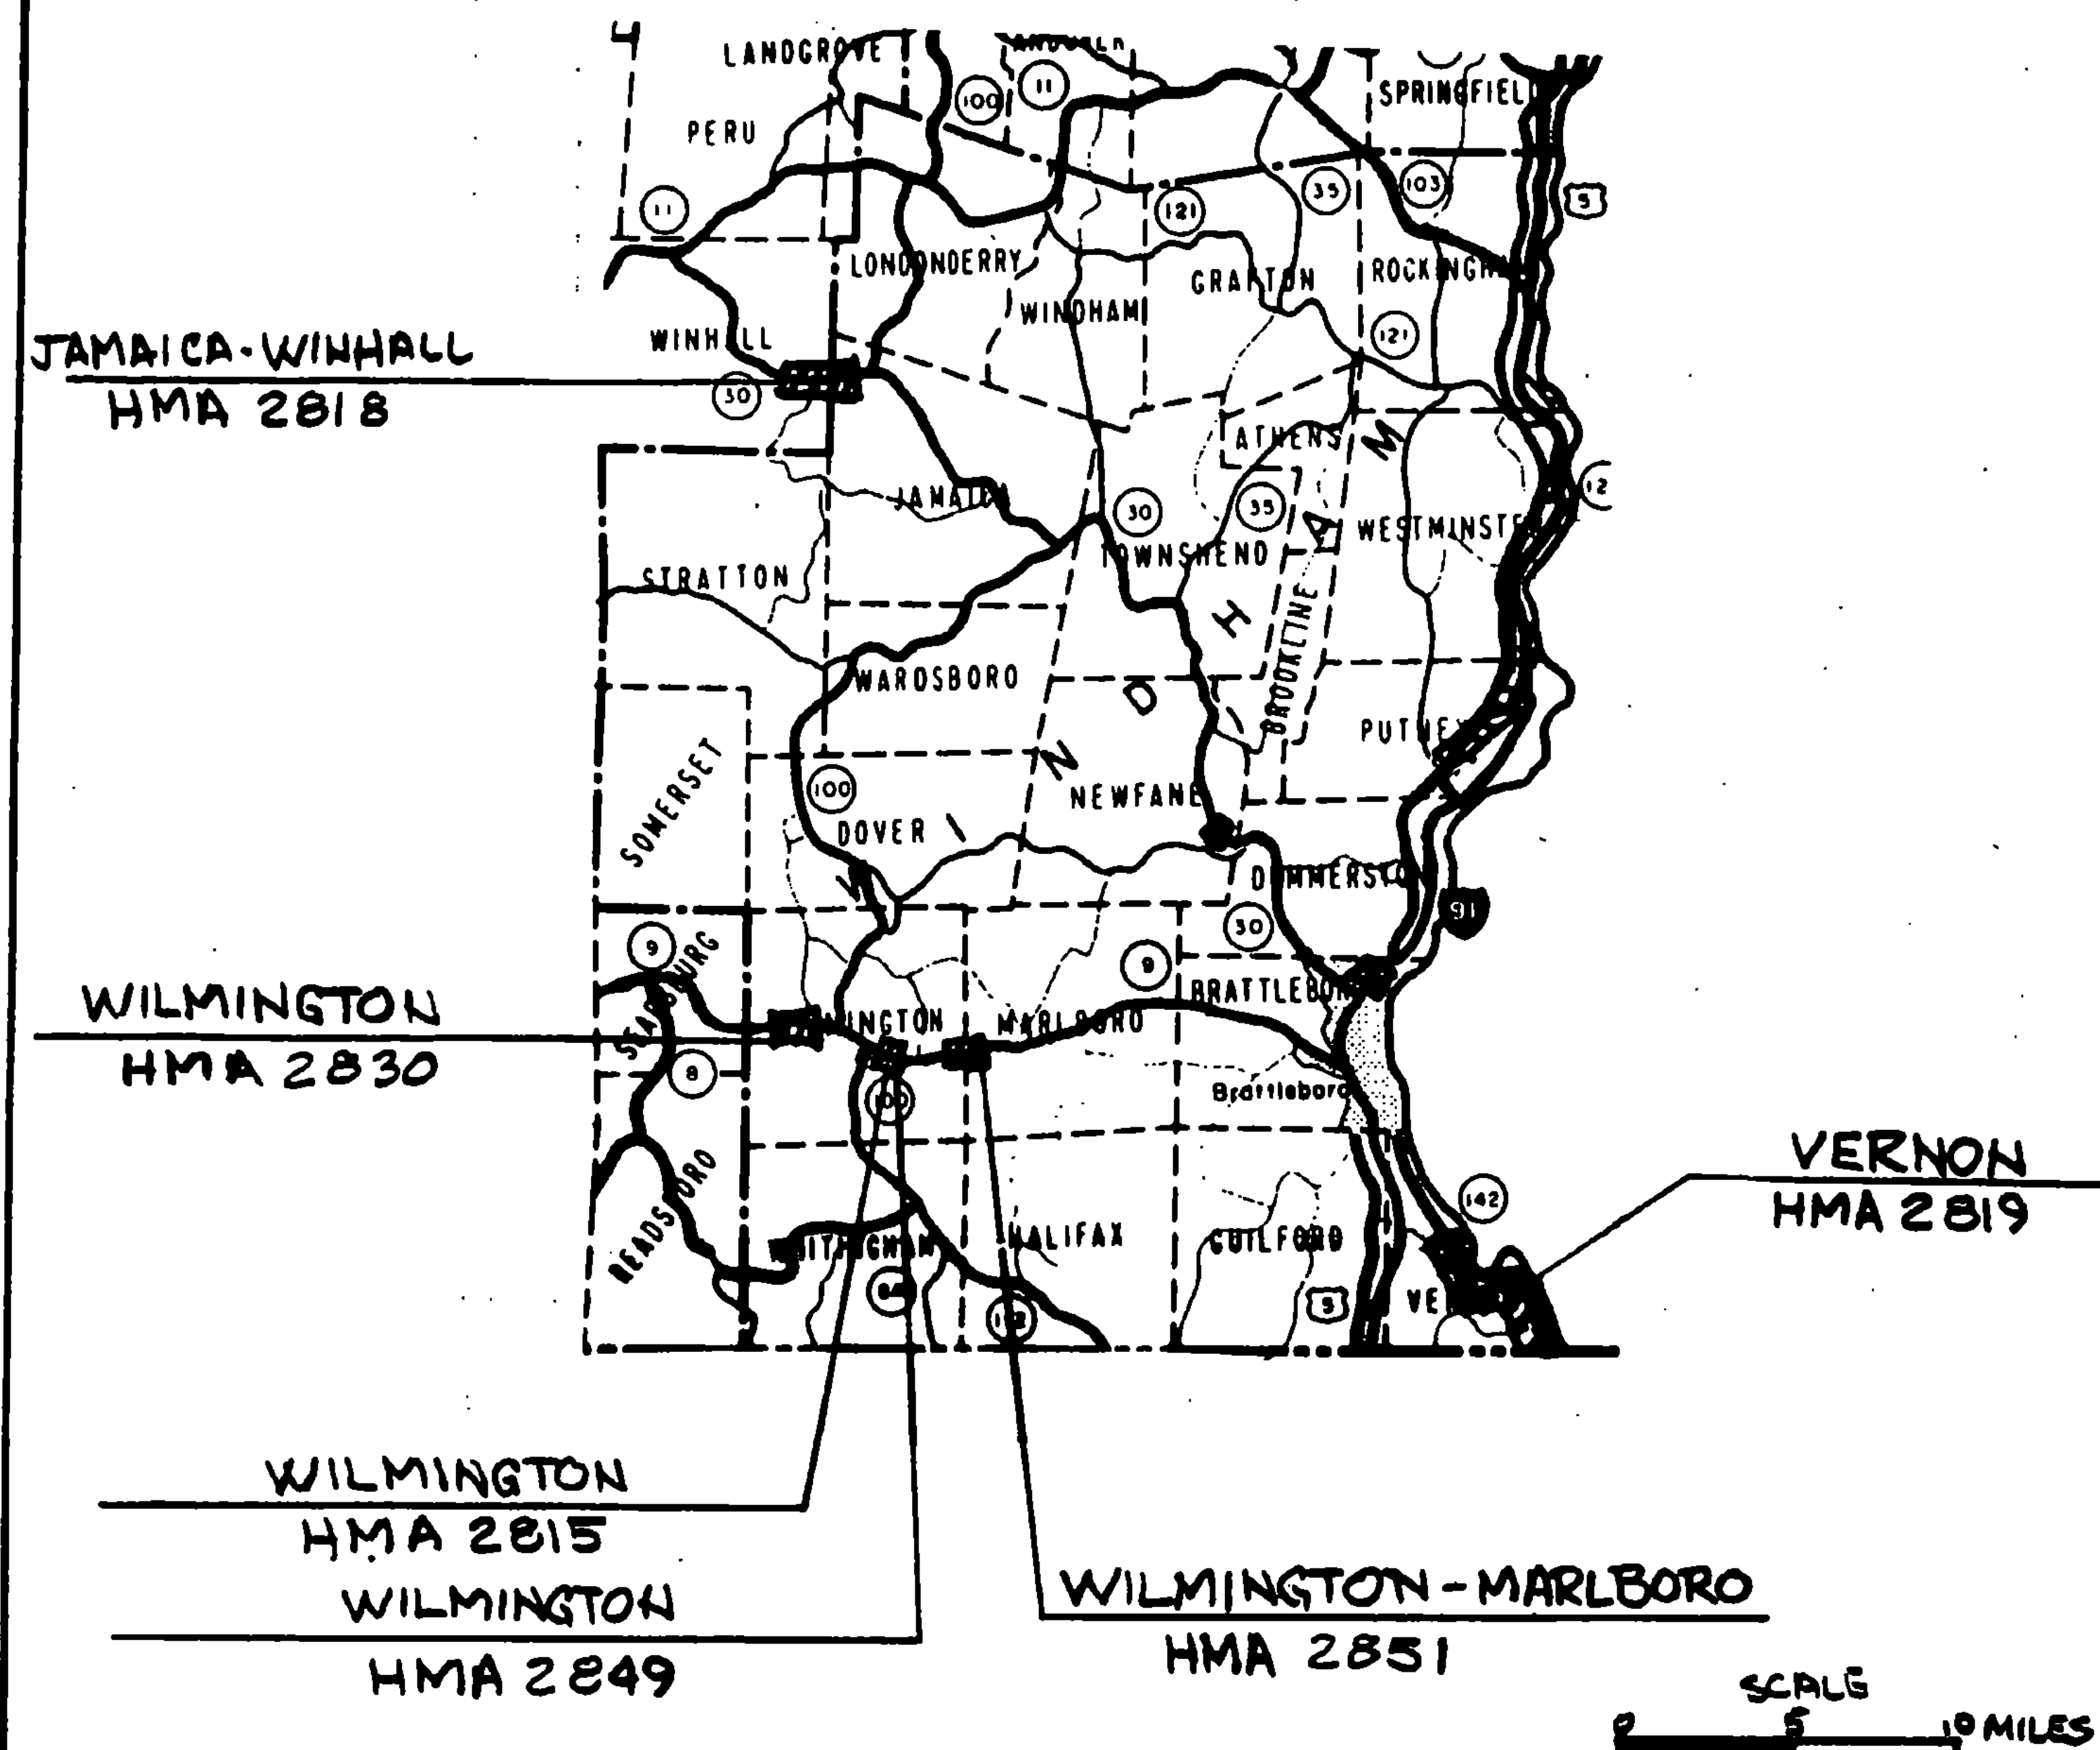

PROJECT	OVERLAY	DEPTH	BEGIN	END	LENGTH (FT)	LENGTH (MI)
JAMAICA-WINHALL HMA 2818		1 1/4"	JAMAICA 2.825	WINHALL 2.096	16030.080	3.036
VERNON HMA 2819		1 1/4"	0.000	6.800	35904.000	6.800
WILMINGTON HMA 2830		1 1/4"	1.270	1.978	3738.24	0.708
WILMINGTON HMA 2815		1 1/4"	4.283	4.500	1145.76	0.217
WILMINGTON HMA 2849		1 1/4"	4.500	5.157	3468.960	0.657
WILMINGTON-MARLBORO HMA 2851		1 1/4"	WILMINGTON 7.118	MARLBORO 6.870	3315.840	0.628
TOTALS					63,602.88	12.046

PROJECT 1987 DIST. 2 PAVING

NO. HMA PAVING

SHEET 3 OF 64 SHEETS