



PAVING LIMITS FOR TOWN ROADS & DRIVES

PAVING LIMITS FOR TOWN ROADS

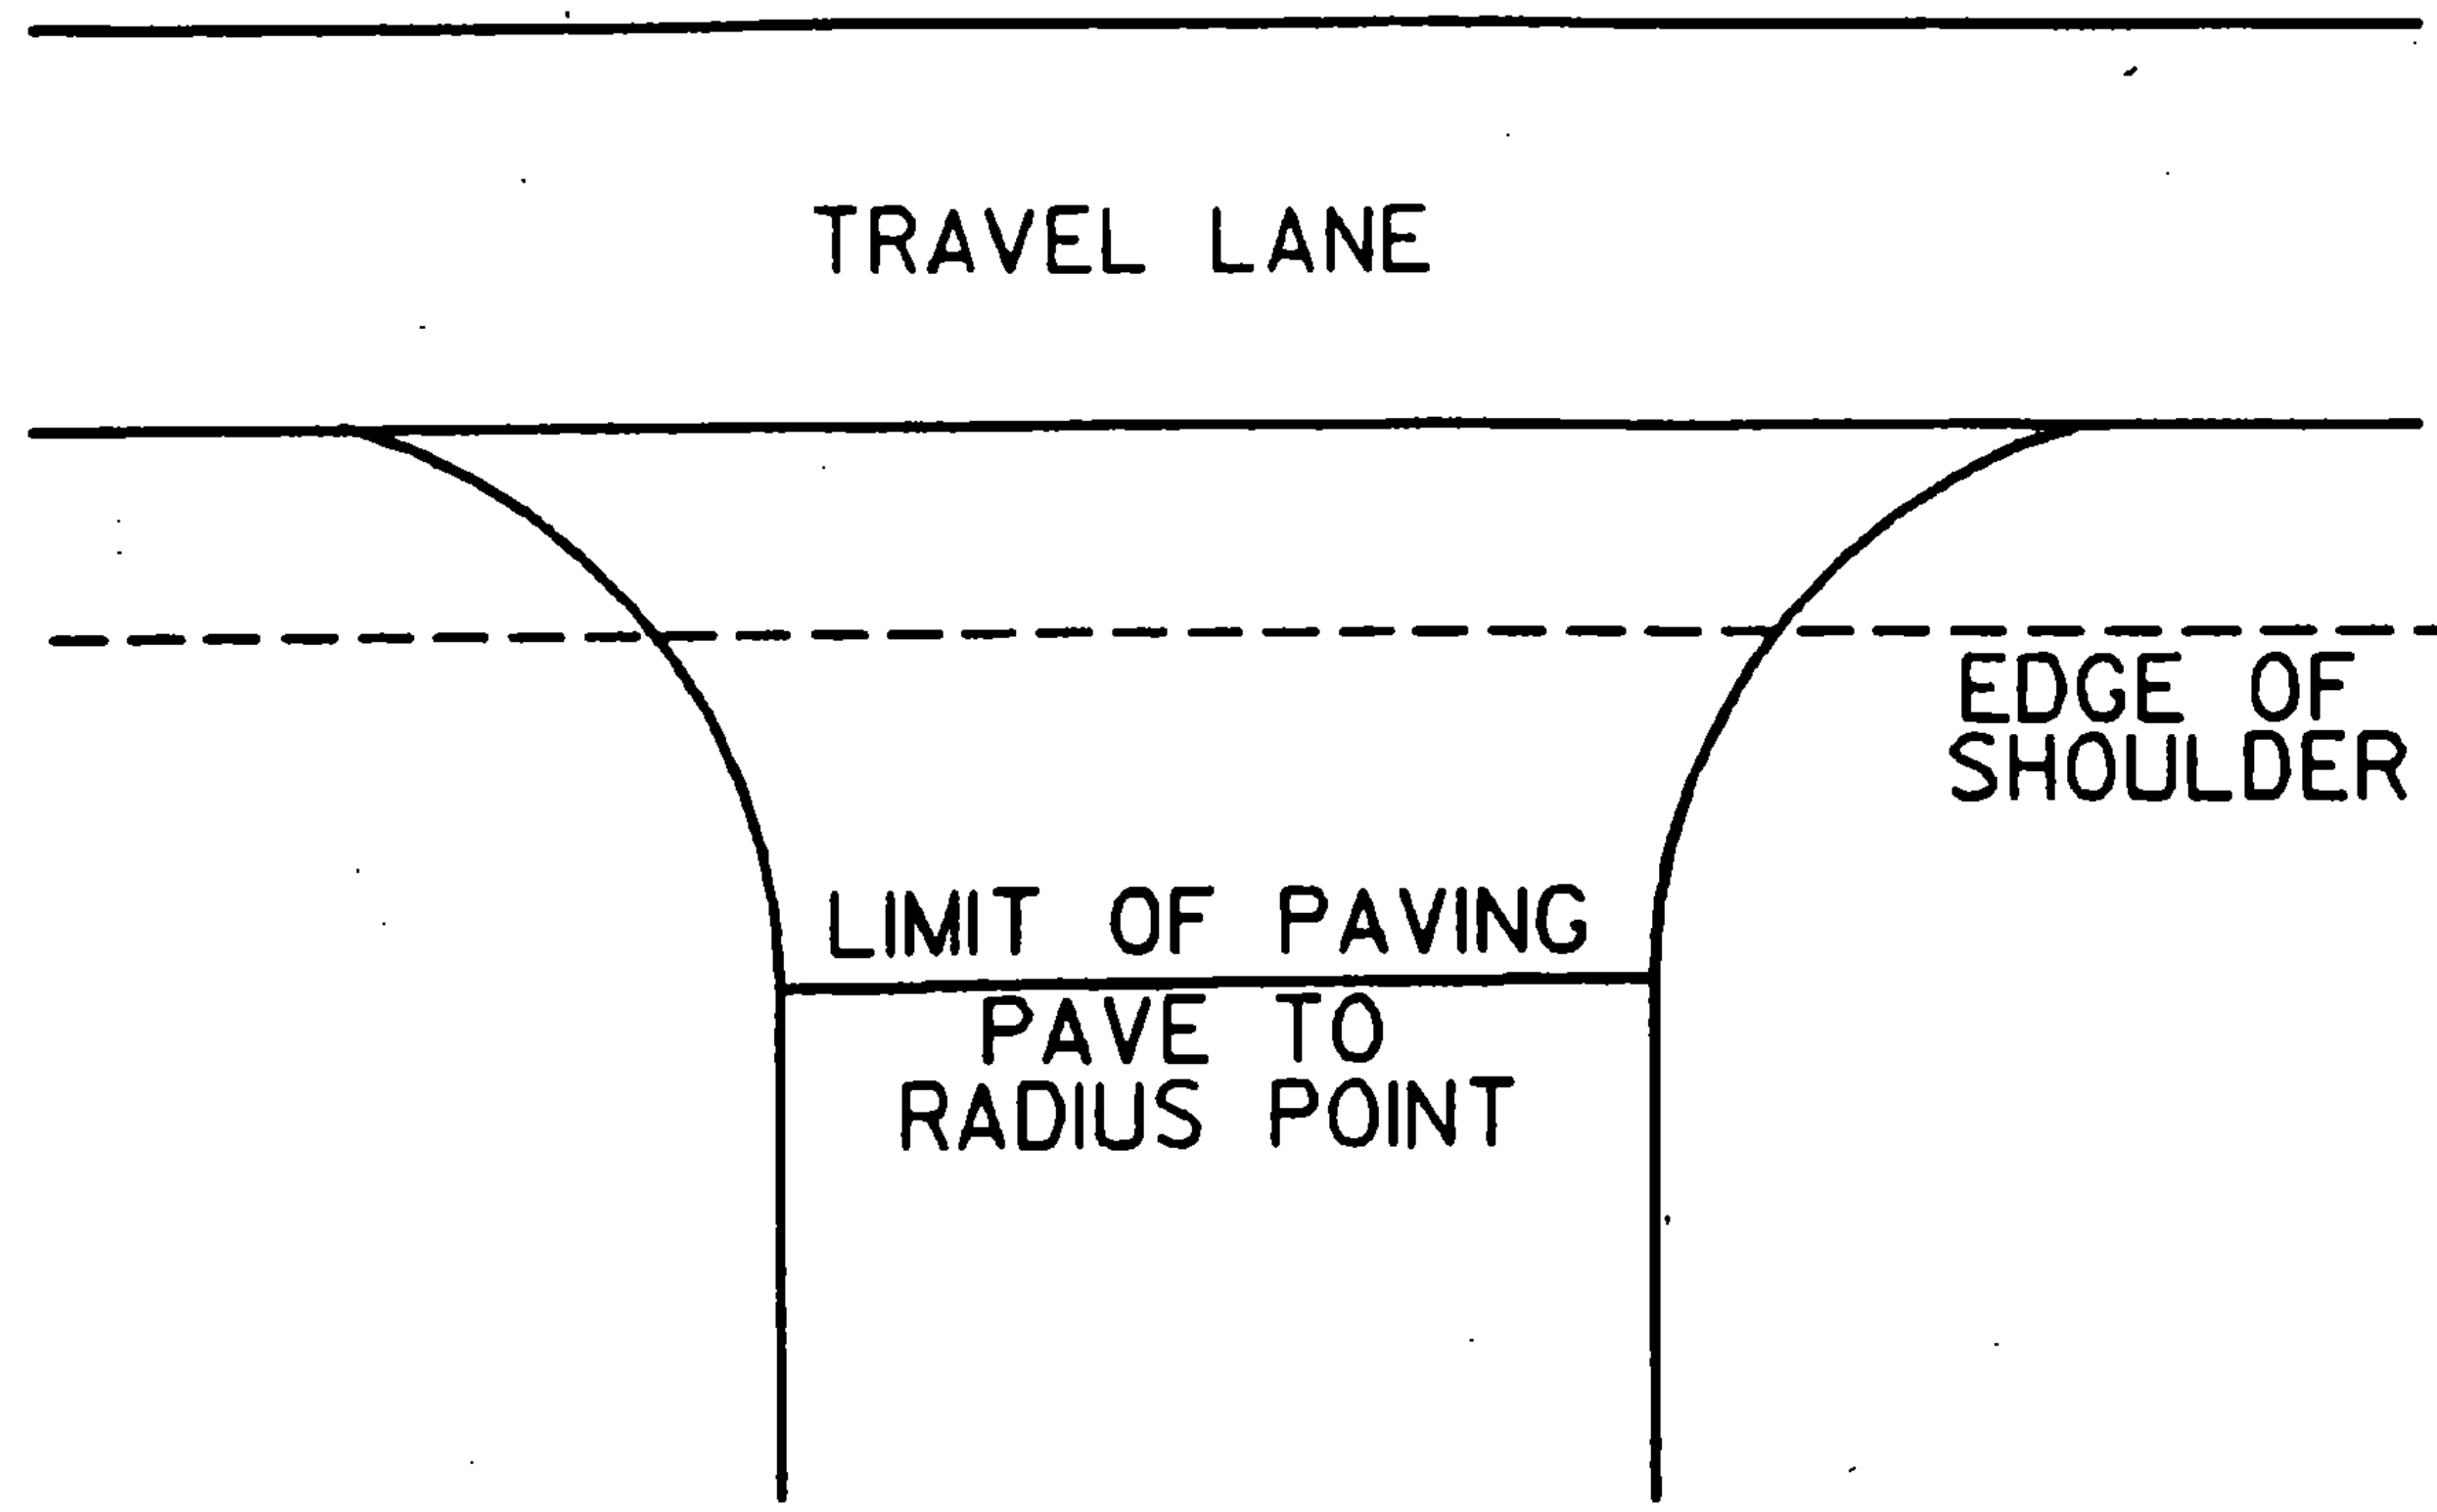

PAVING LIMITS FOR DRIVES

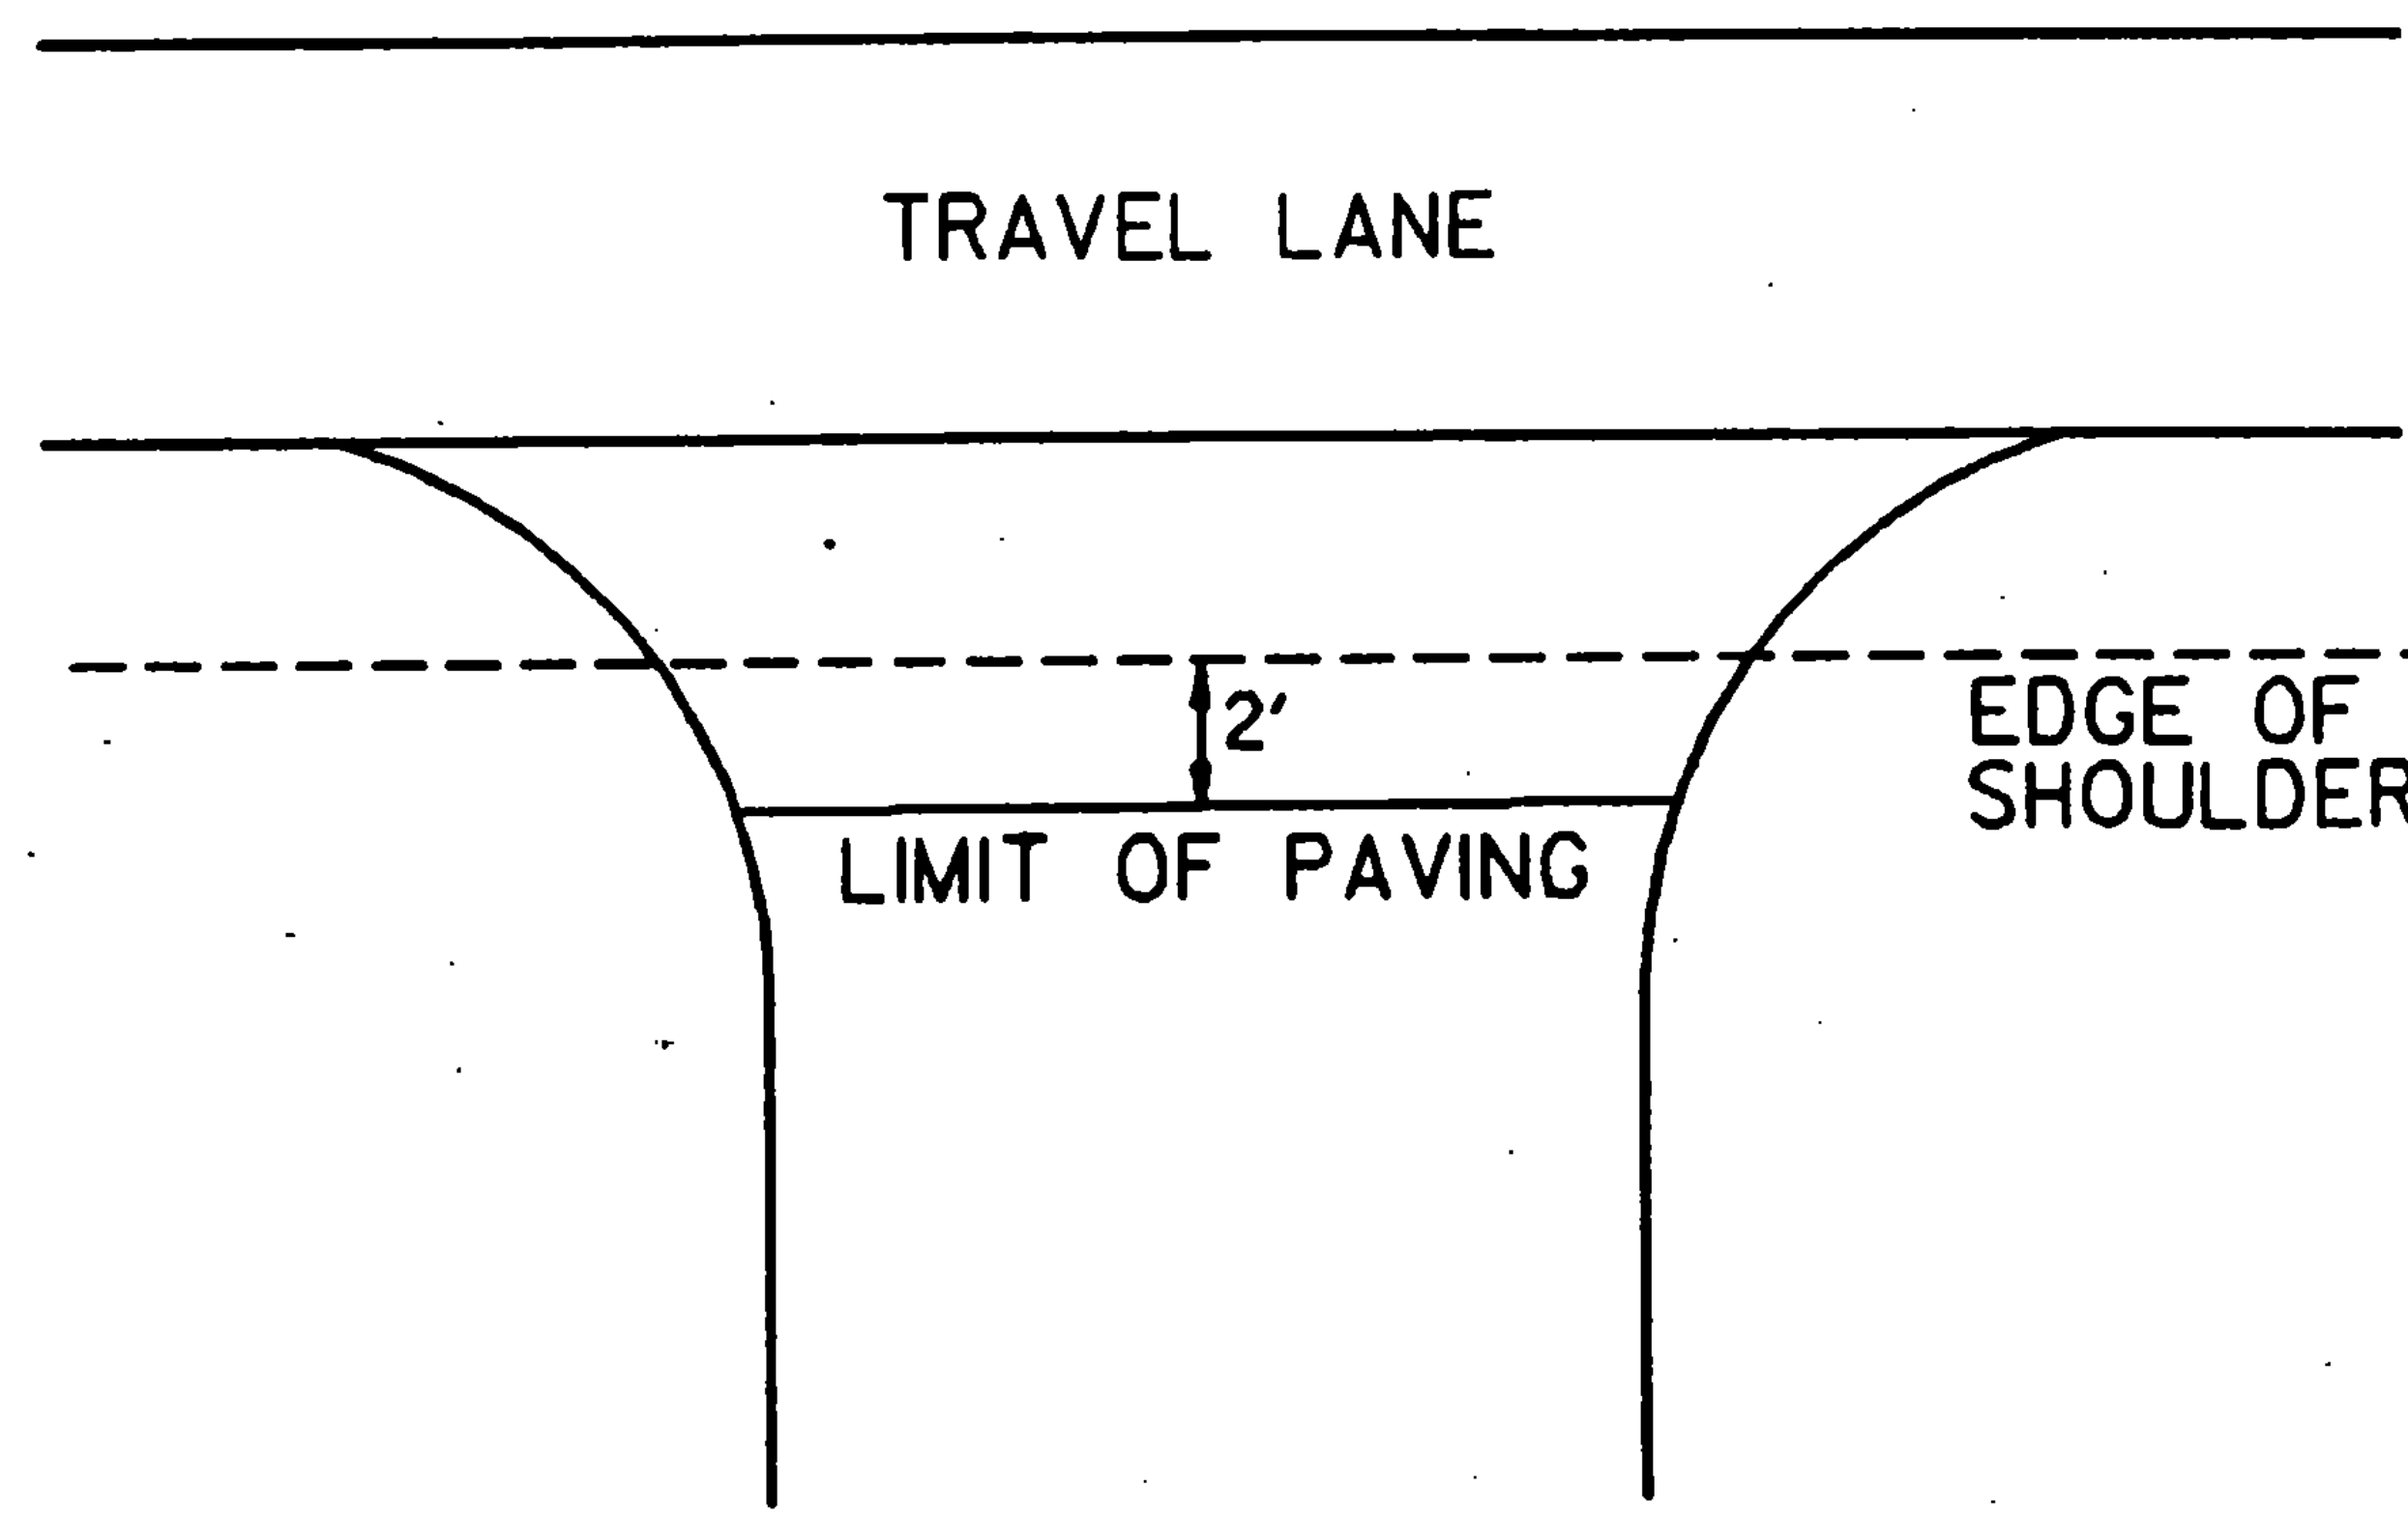

PROJECT 1987 DIST. 2 PAVING

NO. HMA PROJECTS

SHEET 6 OF 64 SHEETS