


TYPICAL SECTIONS & DESIGN DATA

BITUMINOUS CONCRETE PAVEMENT

TYPE IV MIX WILL BE USED FOR LEVELING UNLESS OTHERWISE DETERMINED BY THE RESIDENT ENGINEER

1 1/4" WEARING COURSE, TYPE III

TYPE IV MIX, 27' WIDE @ 250 TONS/MI.

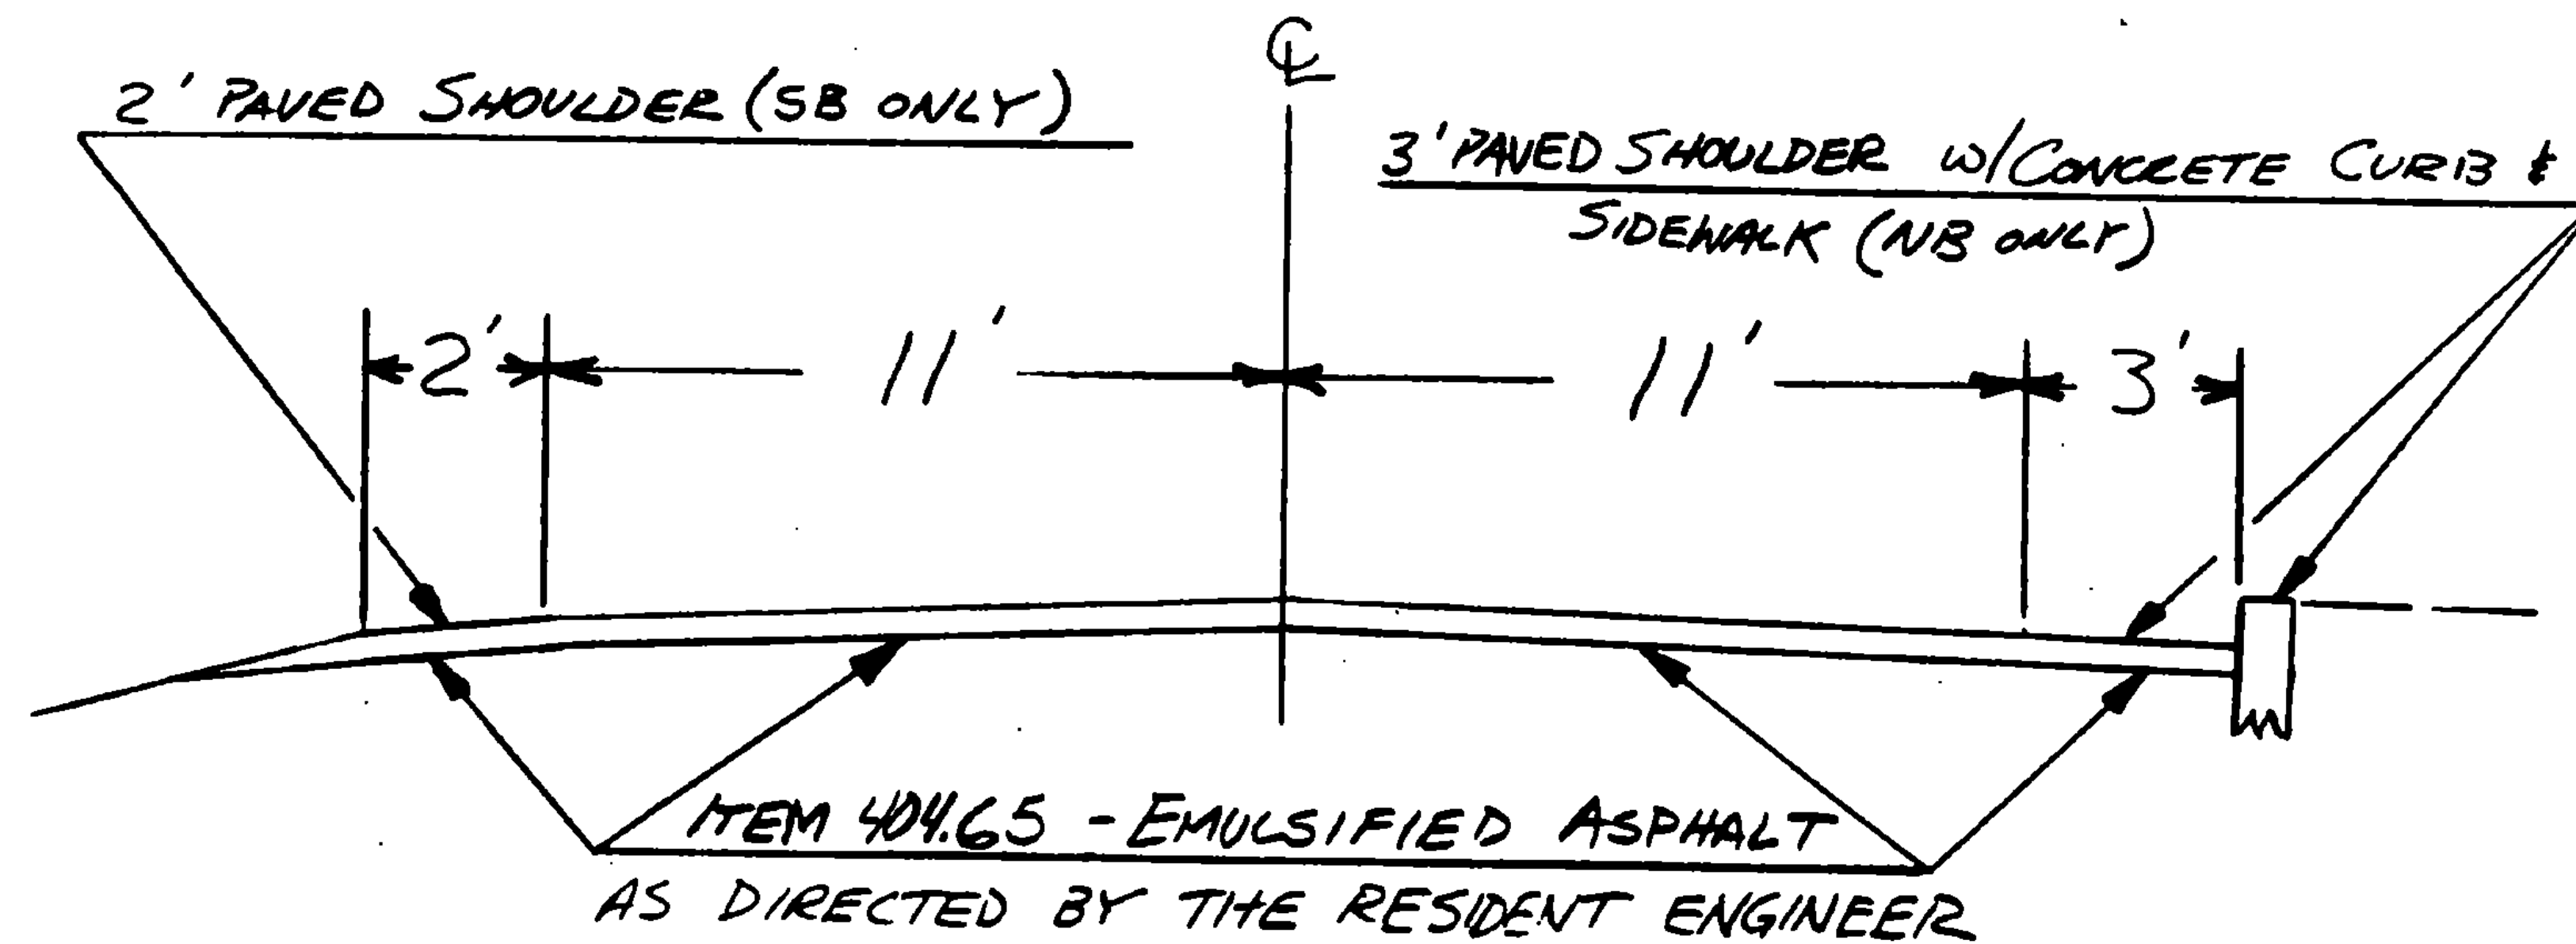

WINHALL MM 0.272 ~ MM 0.424

PROJECT JAMAICA-WINHALL

NO. HMA 2818
SHT 14 OF 64 SHTS
SHT. 6 OF 10 SHTS.